



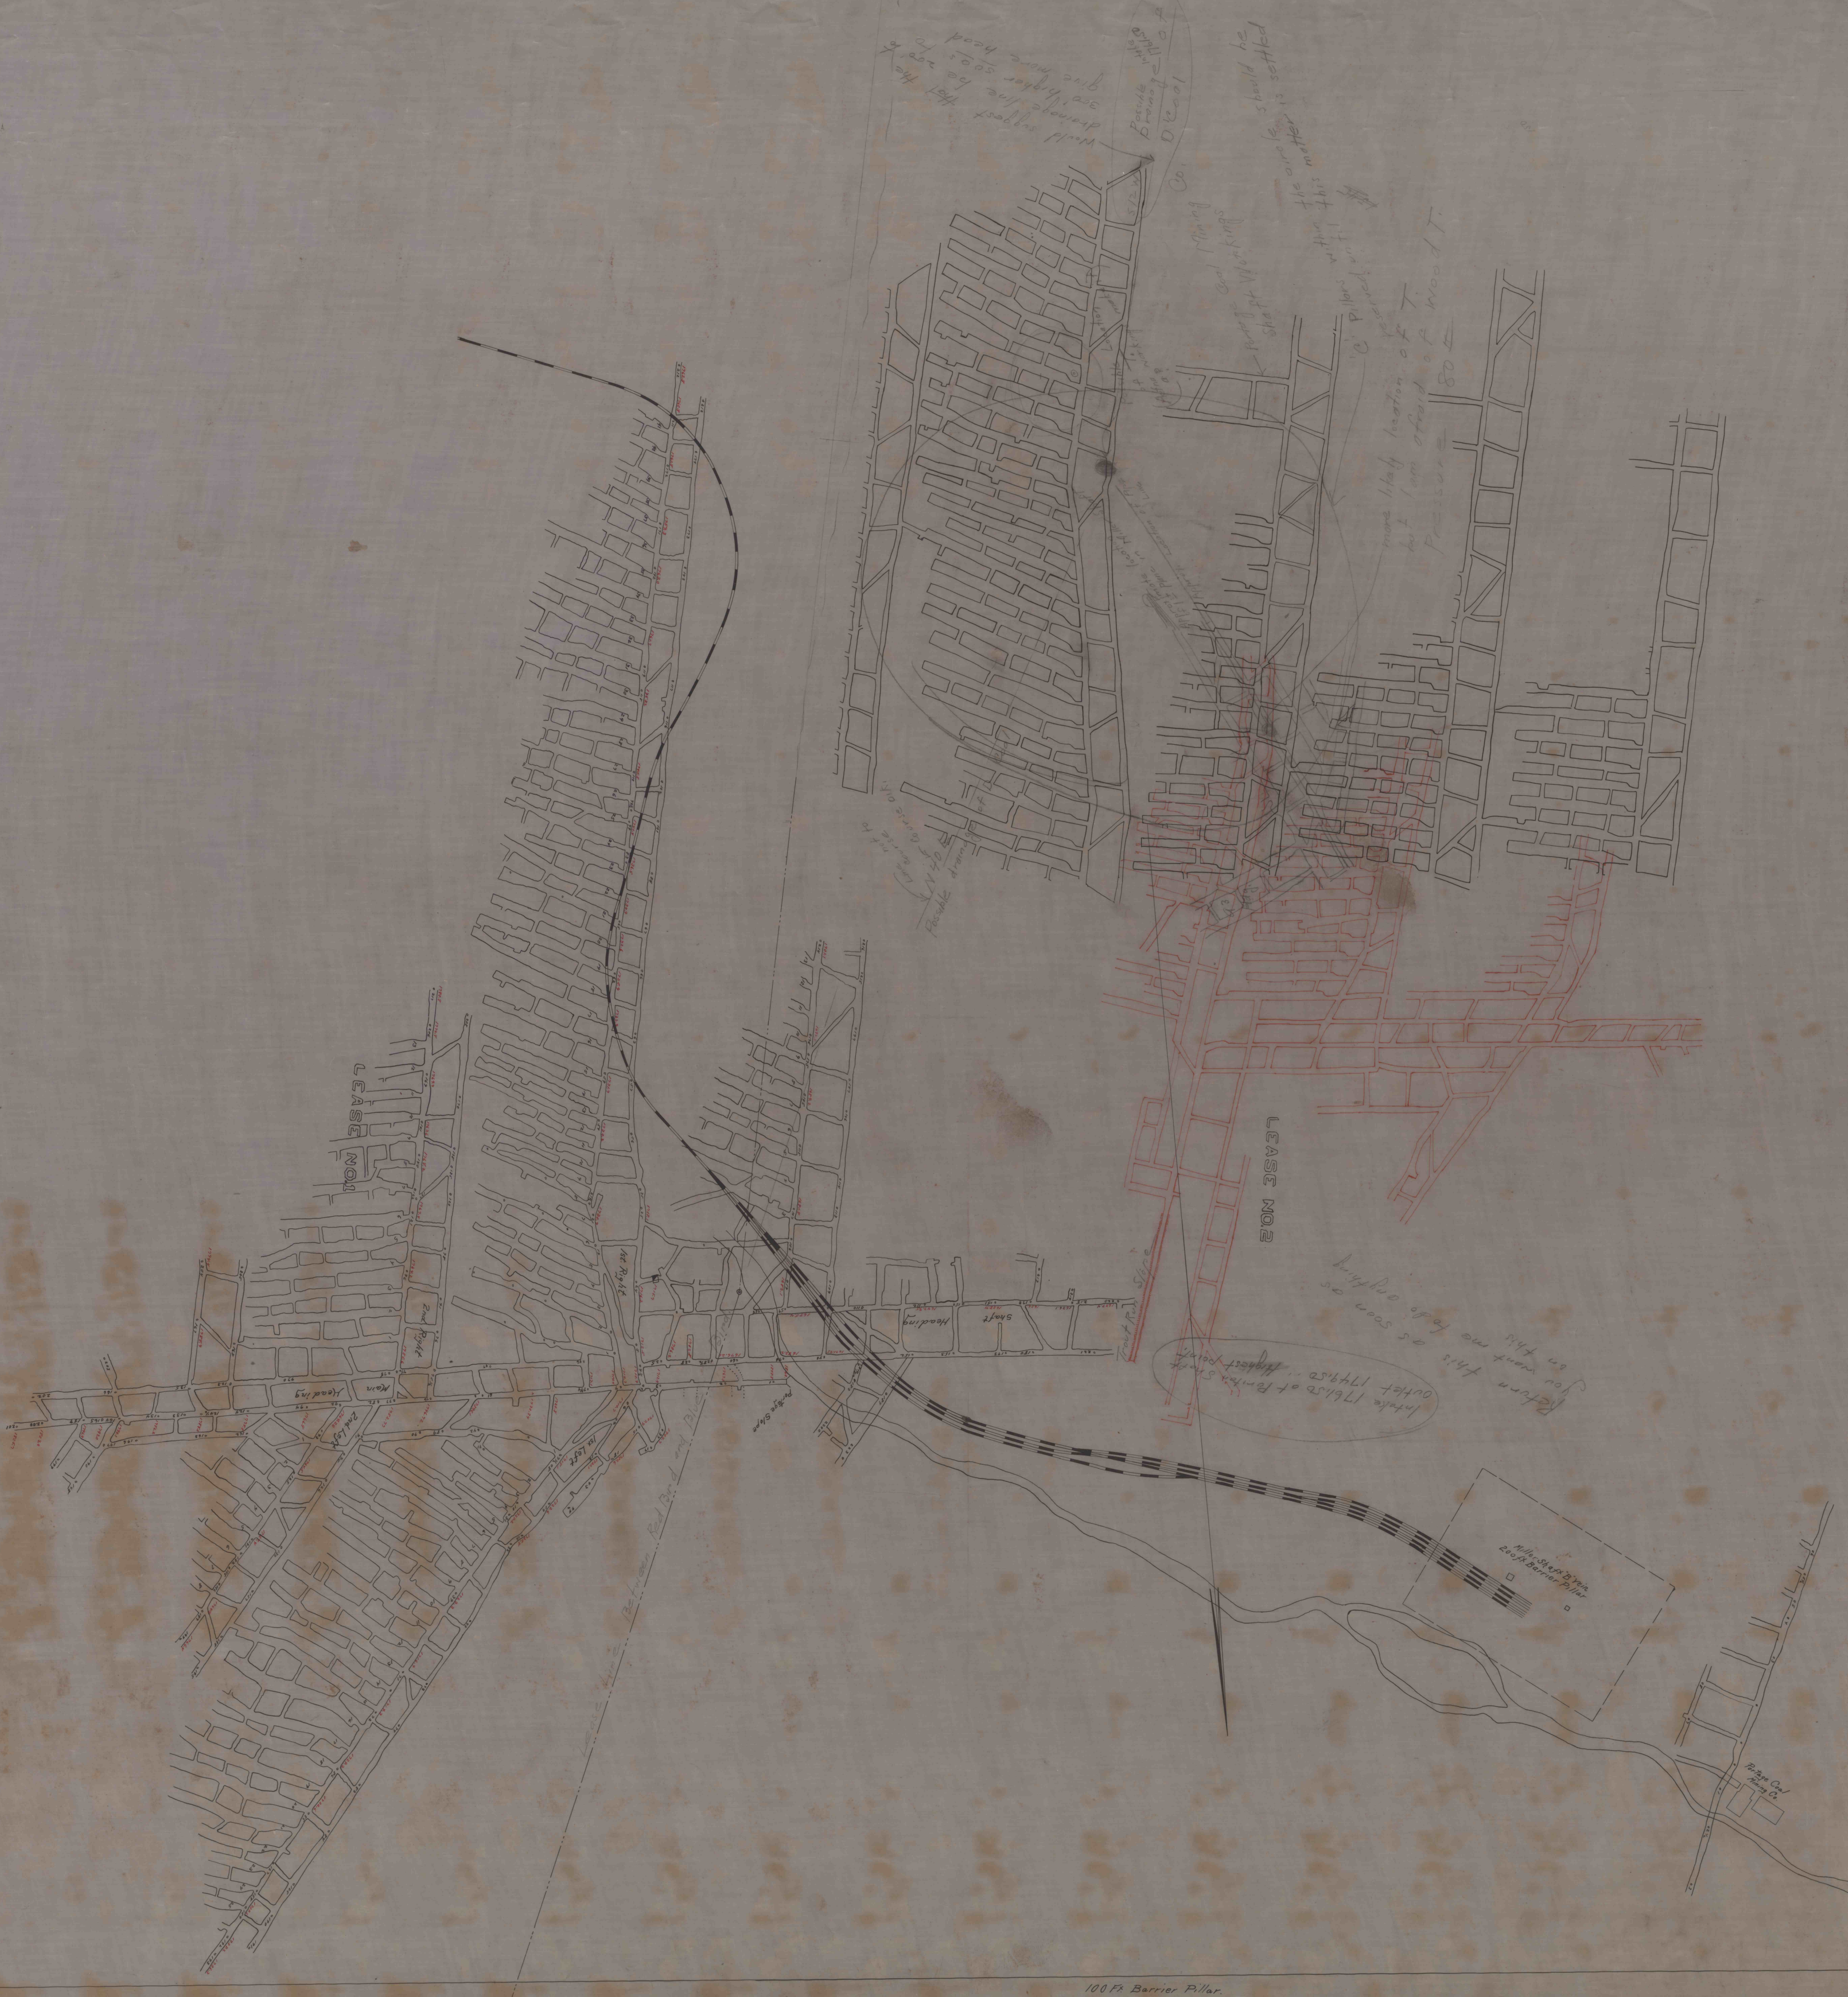

100 FT Barrier Pillar.

100 FT Barrier Pillar.