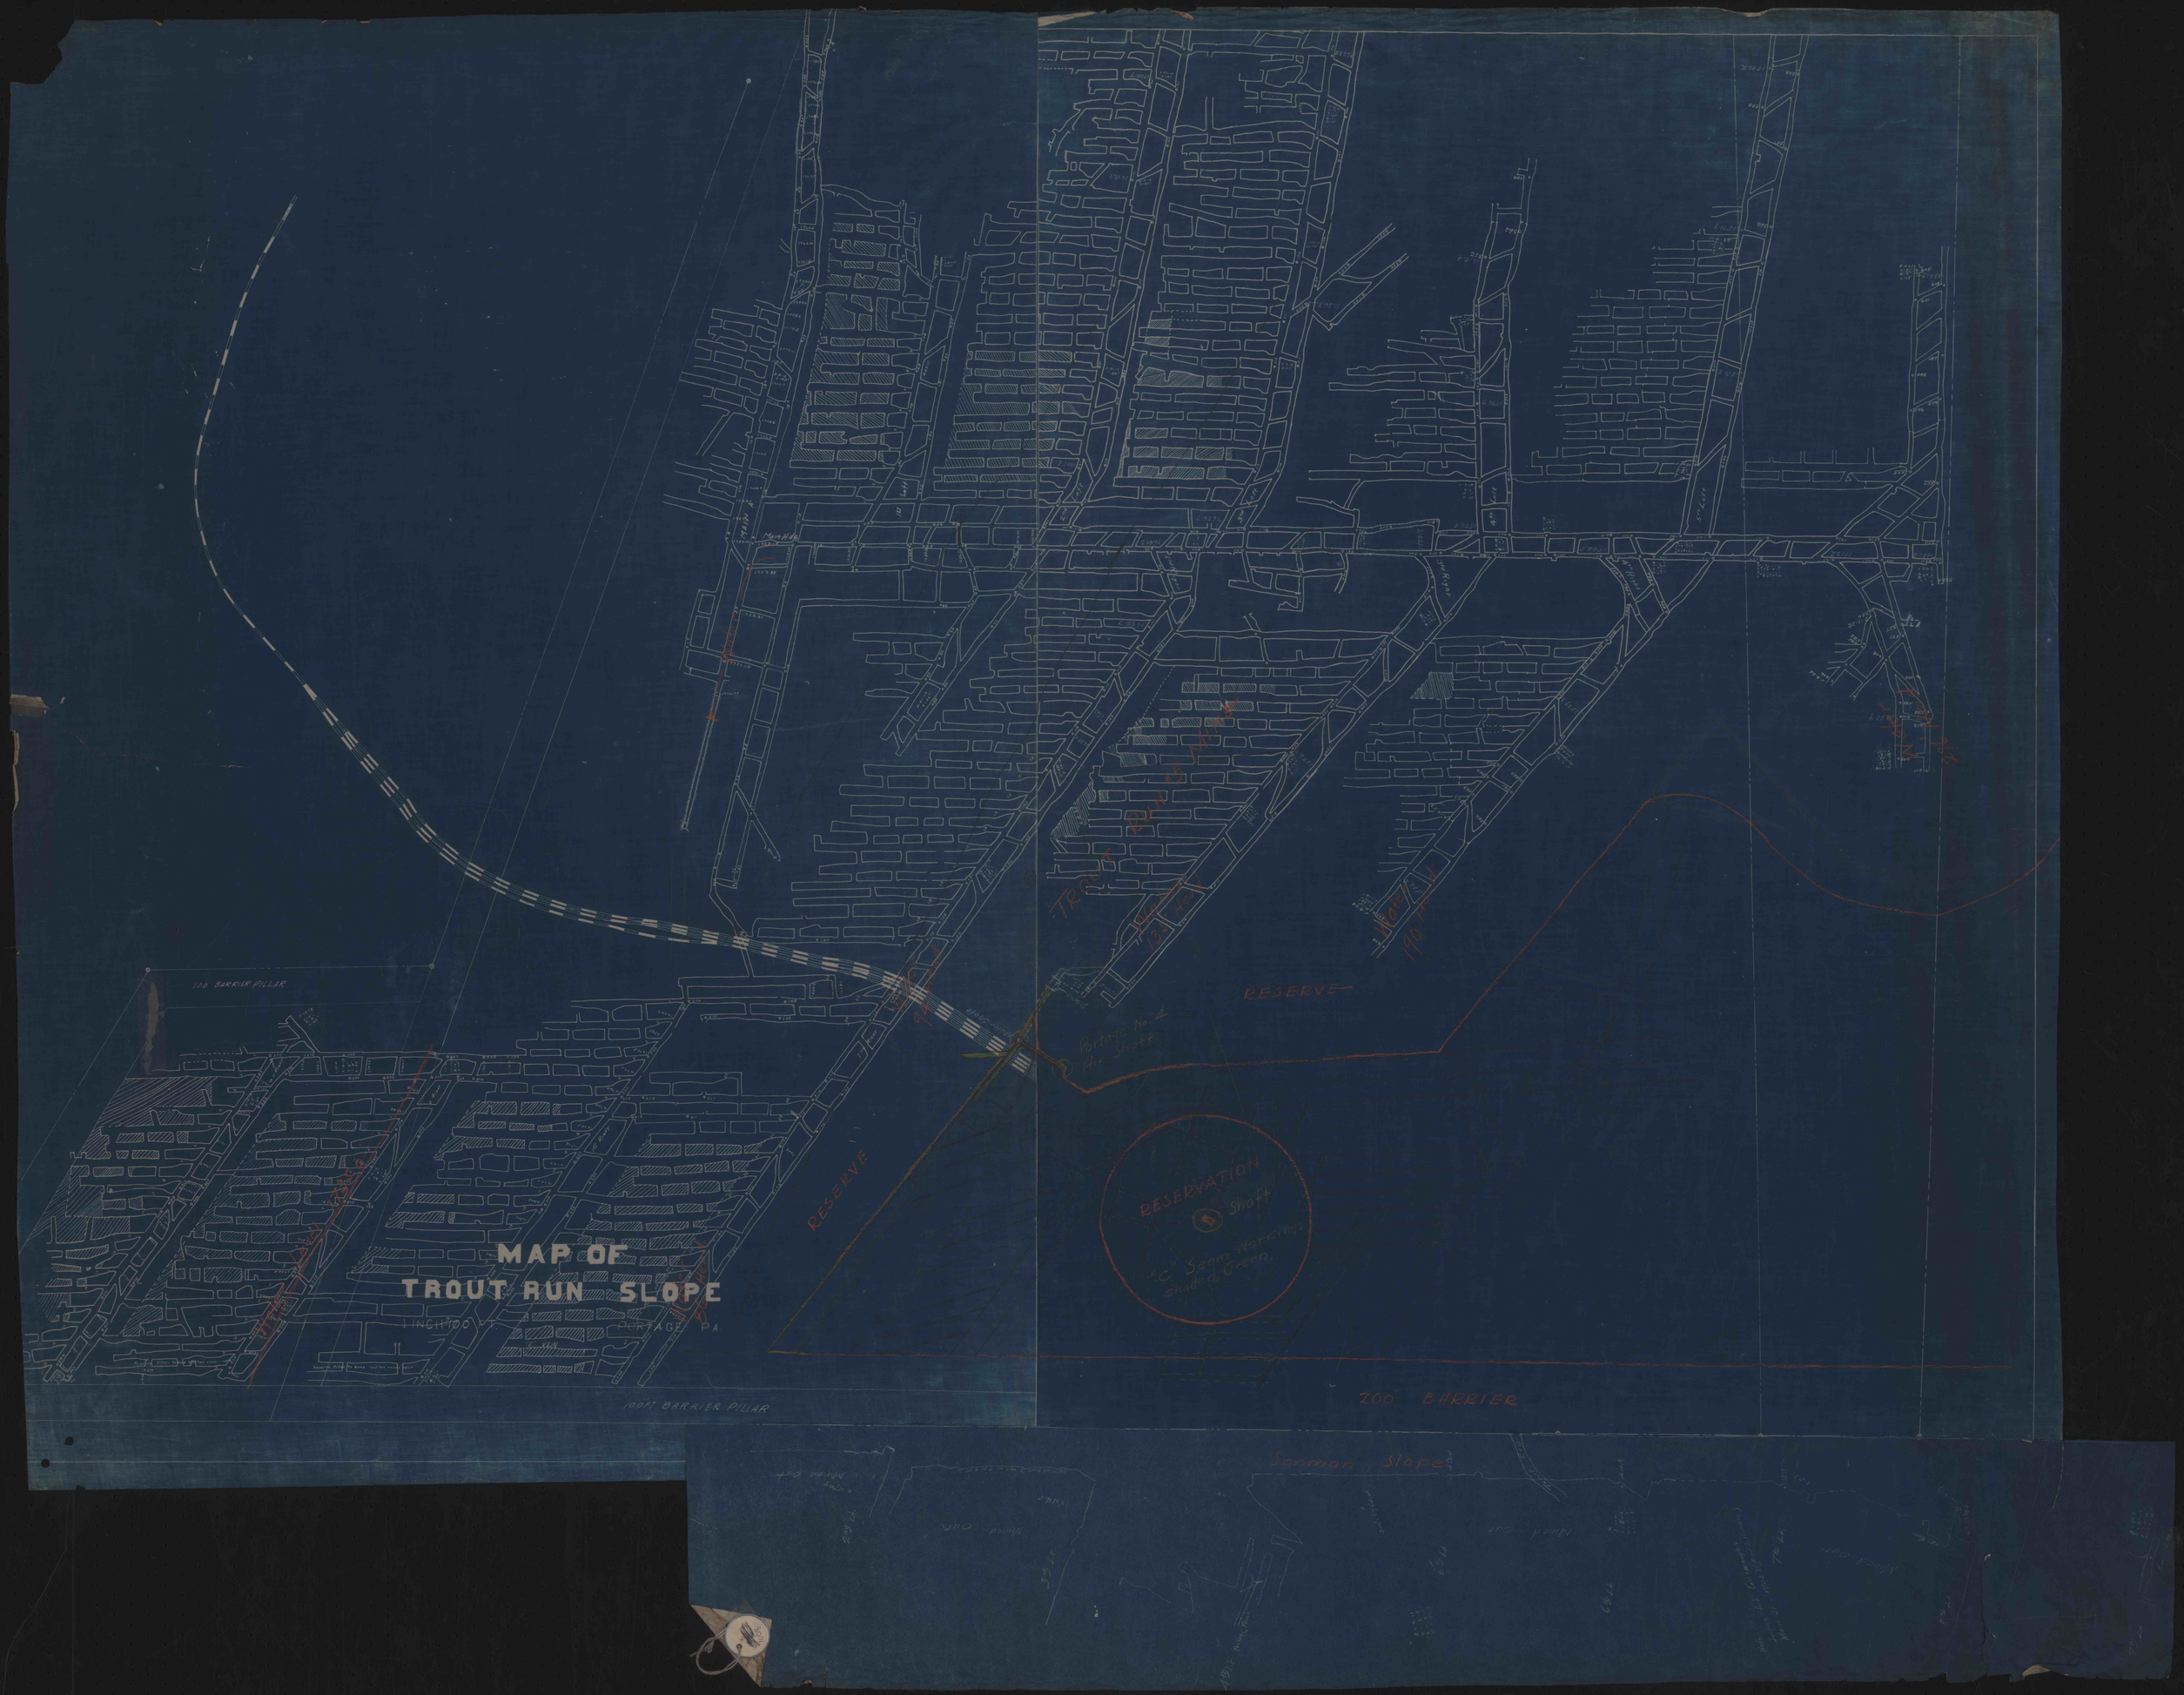
MAP OF
TROUT RUN SLOPE
100 BARRIER PILLAR
100 FT BARRIER PILLAR
RESERVE
RESERVE
RESERVATION
Shaft
"C" Seam Workings
Shaded Green.
200' BARRIER
Senman Slope
Portage No. 4
Air Shaft
Main Rd.
Portage Pa.