


1010

200

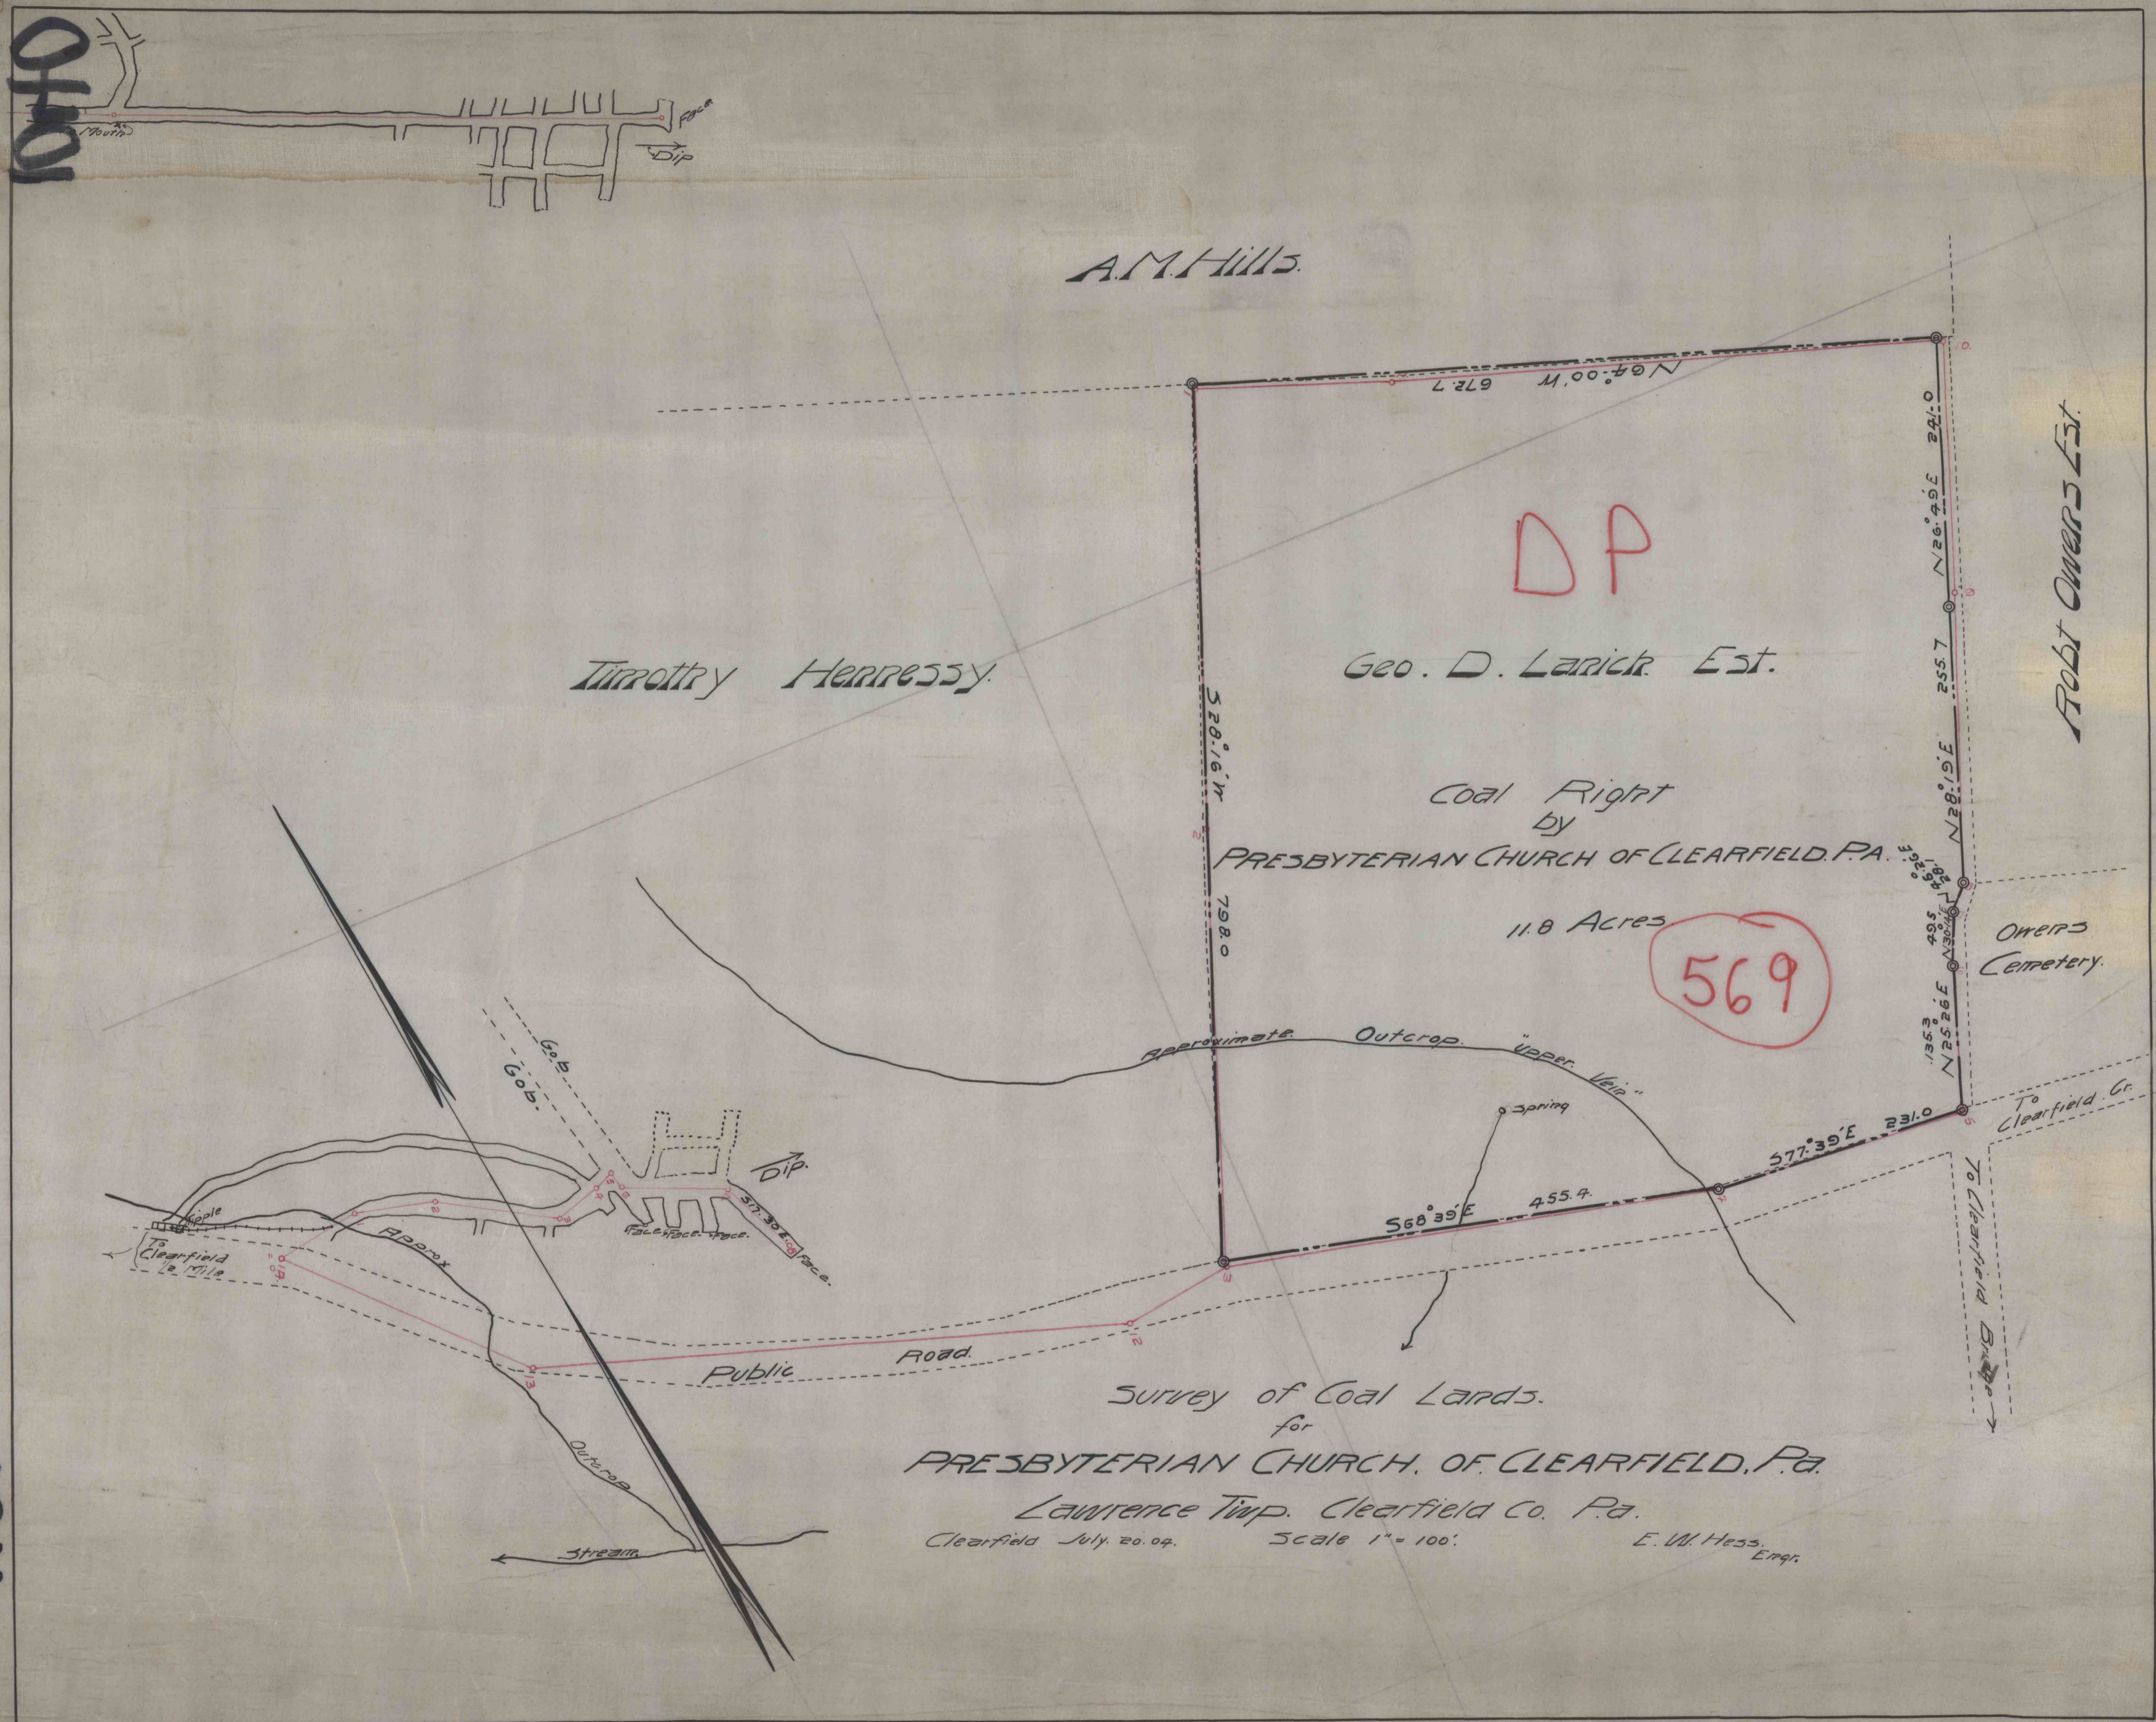

A.M. Hills.

DP

Timothy Hennessy.

Geo. D. Larick Est.

Robt Owens Est.

Coal Right by
PRESBYTERIAN CHURCH OF CLEARFIELD, PA.

11.8 Acres

569

Owens Cemetery.

Survey of Coal Lands
for

PRESBYTERIAN CHURCH, OF CLEARFIELD, Pa.

Lawrence Timp. Clearfield Co. Pa.

Clearfield July 20. 04.

Scale 1" = 100'

E. W. Hess, Engr.

200