


SONMAN SHAFT COAL CO.
E SEAM MINE
MAP SHOWING
MINE WORKINGS UNDER PORTAGE BOROUGH.
SCALE 1"=100' NOV. 1923 J. O. SILLYMAN & CO.
ENGINEERS

INDICATES MASONRY BUILDINGS.
INDICATES COAL NOT OWNED UNDER LOTS IN PORTAGE.

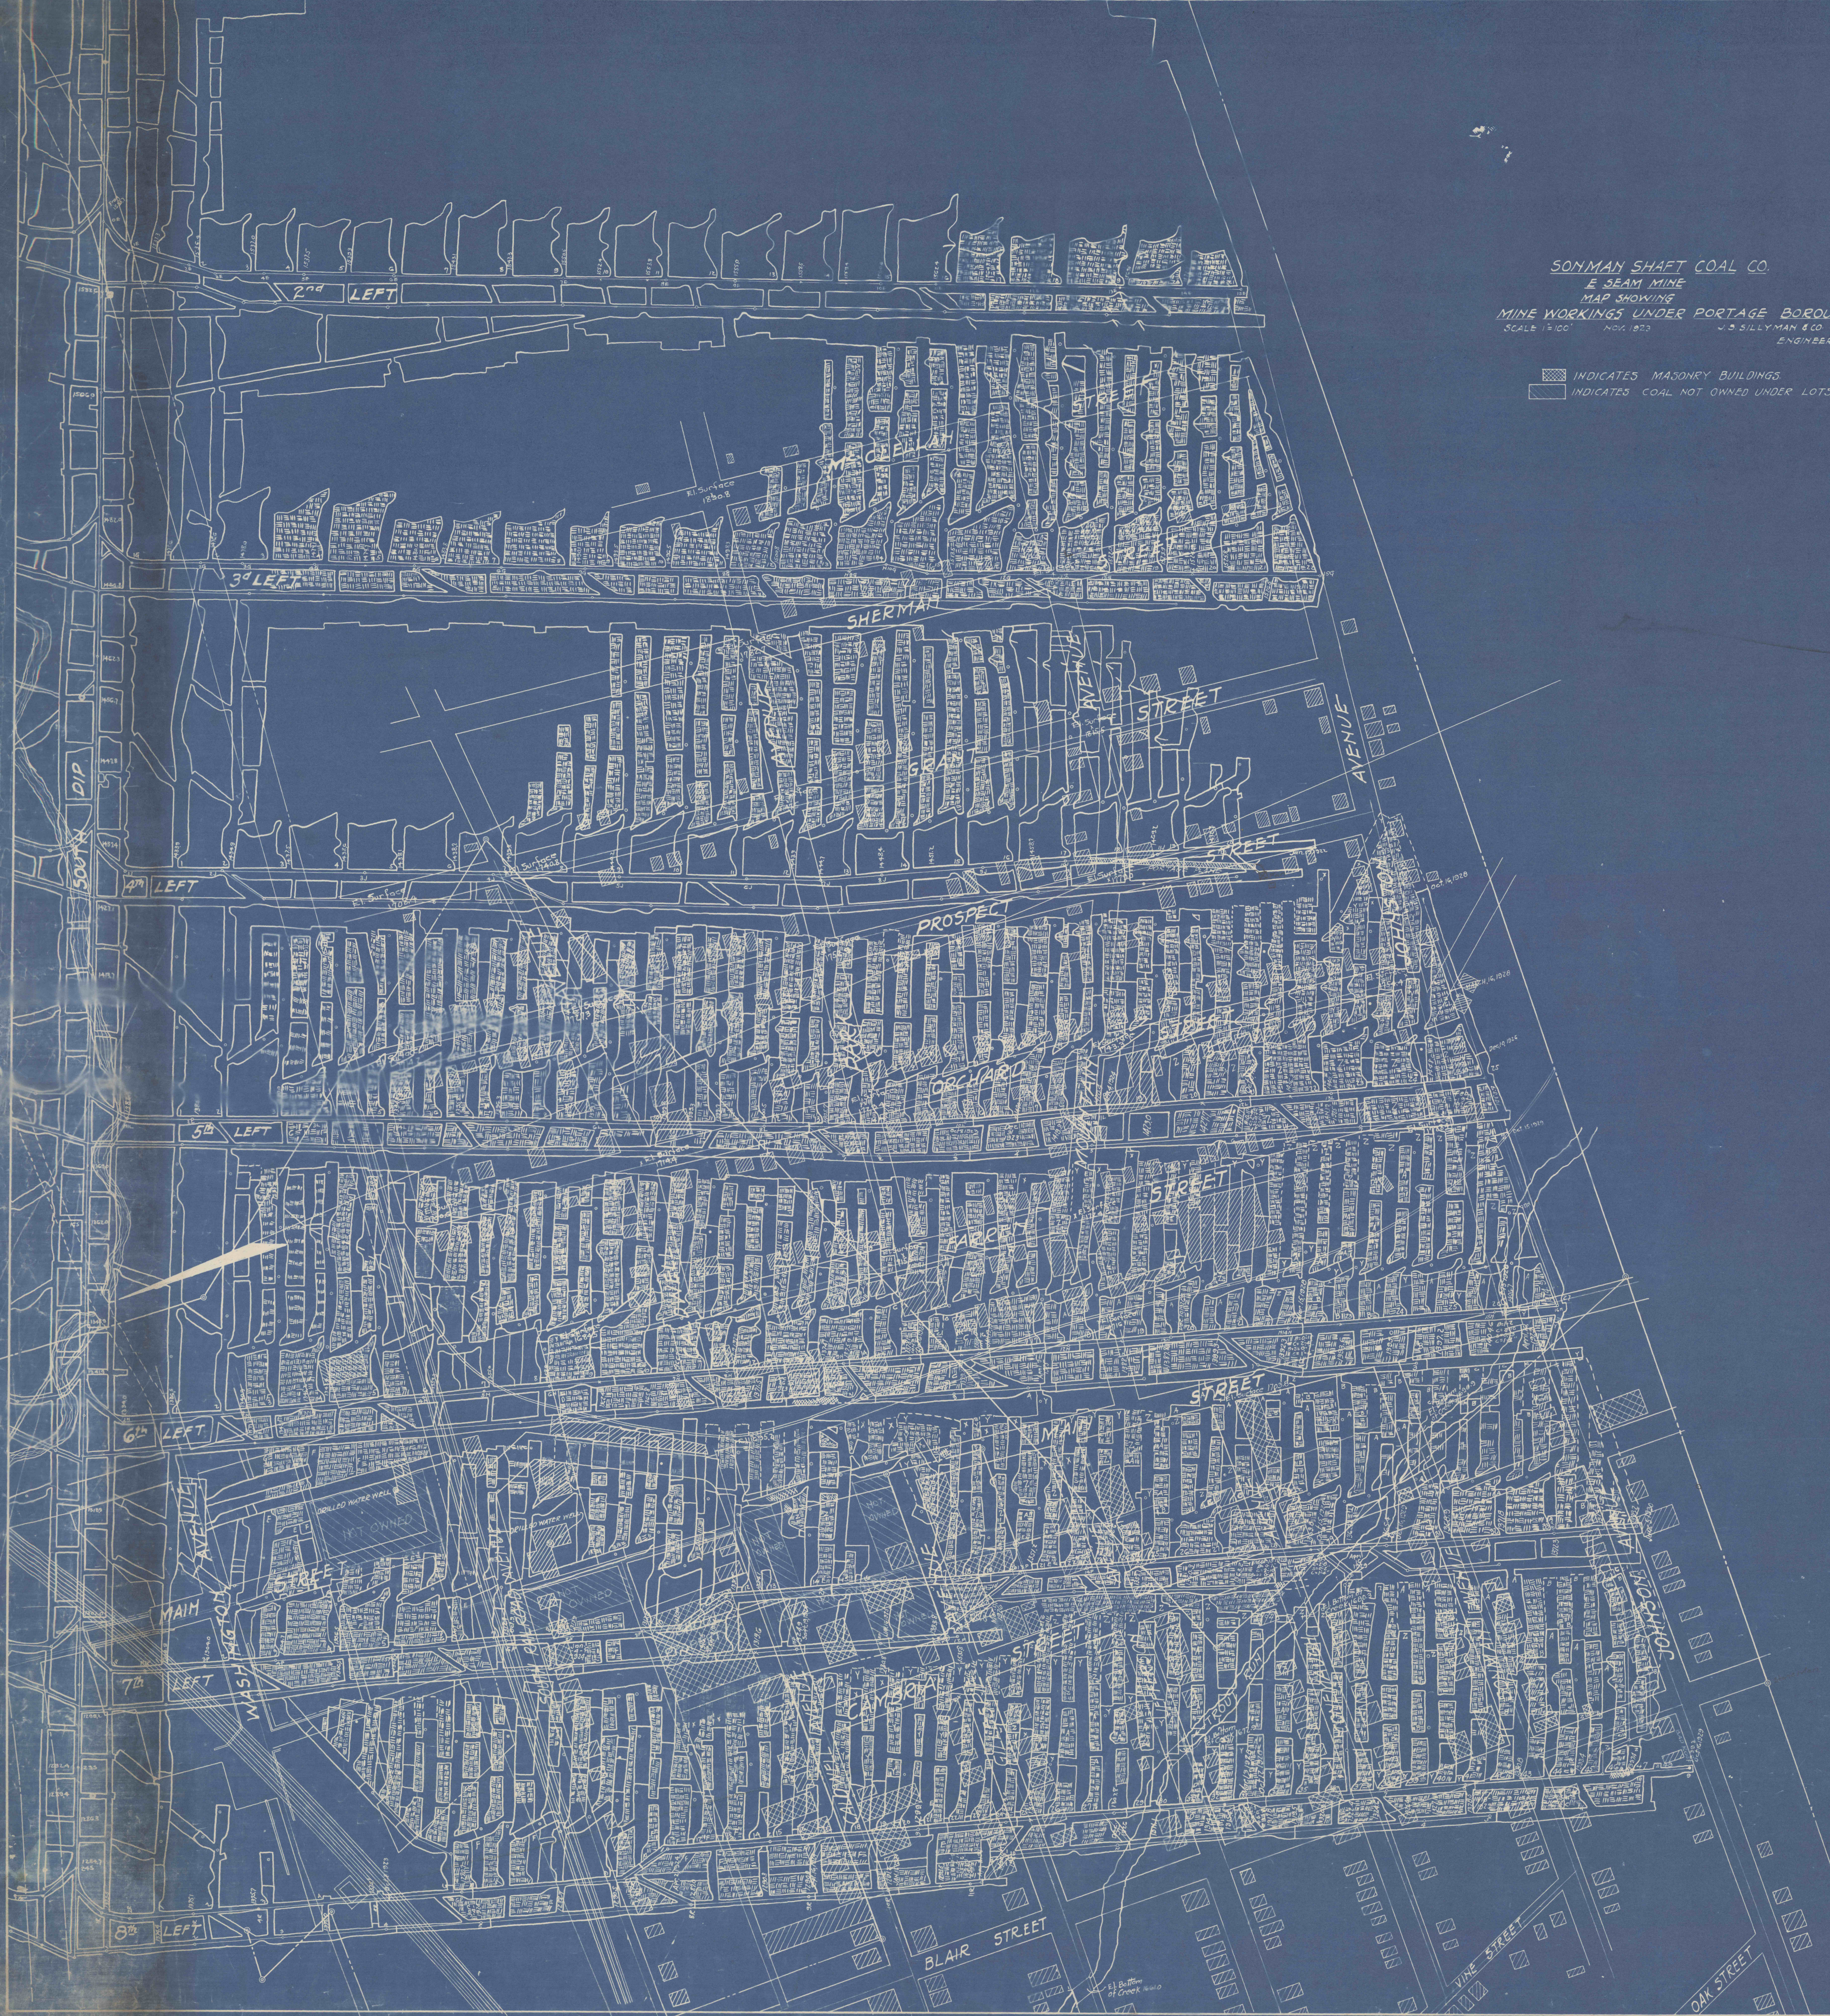

