


1870

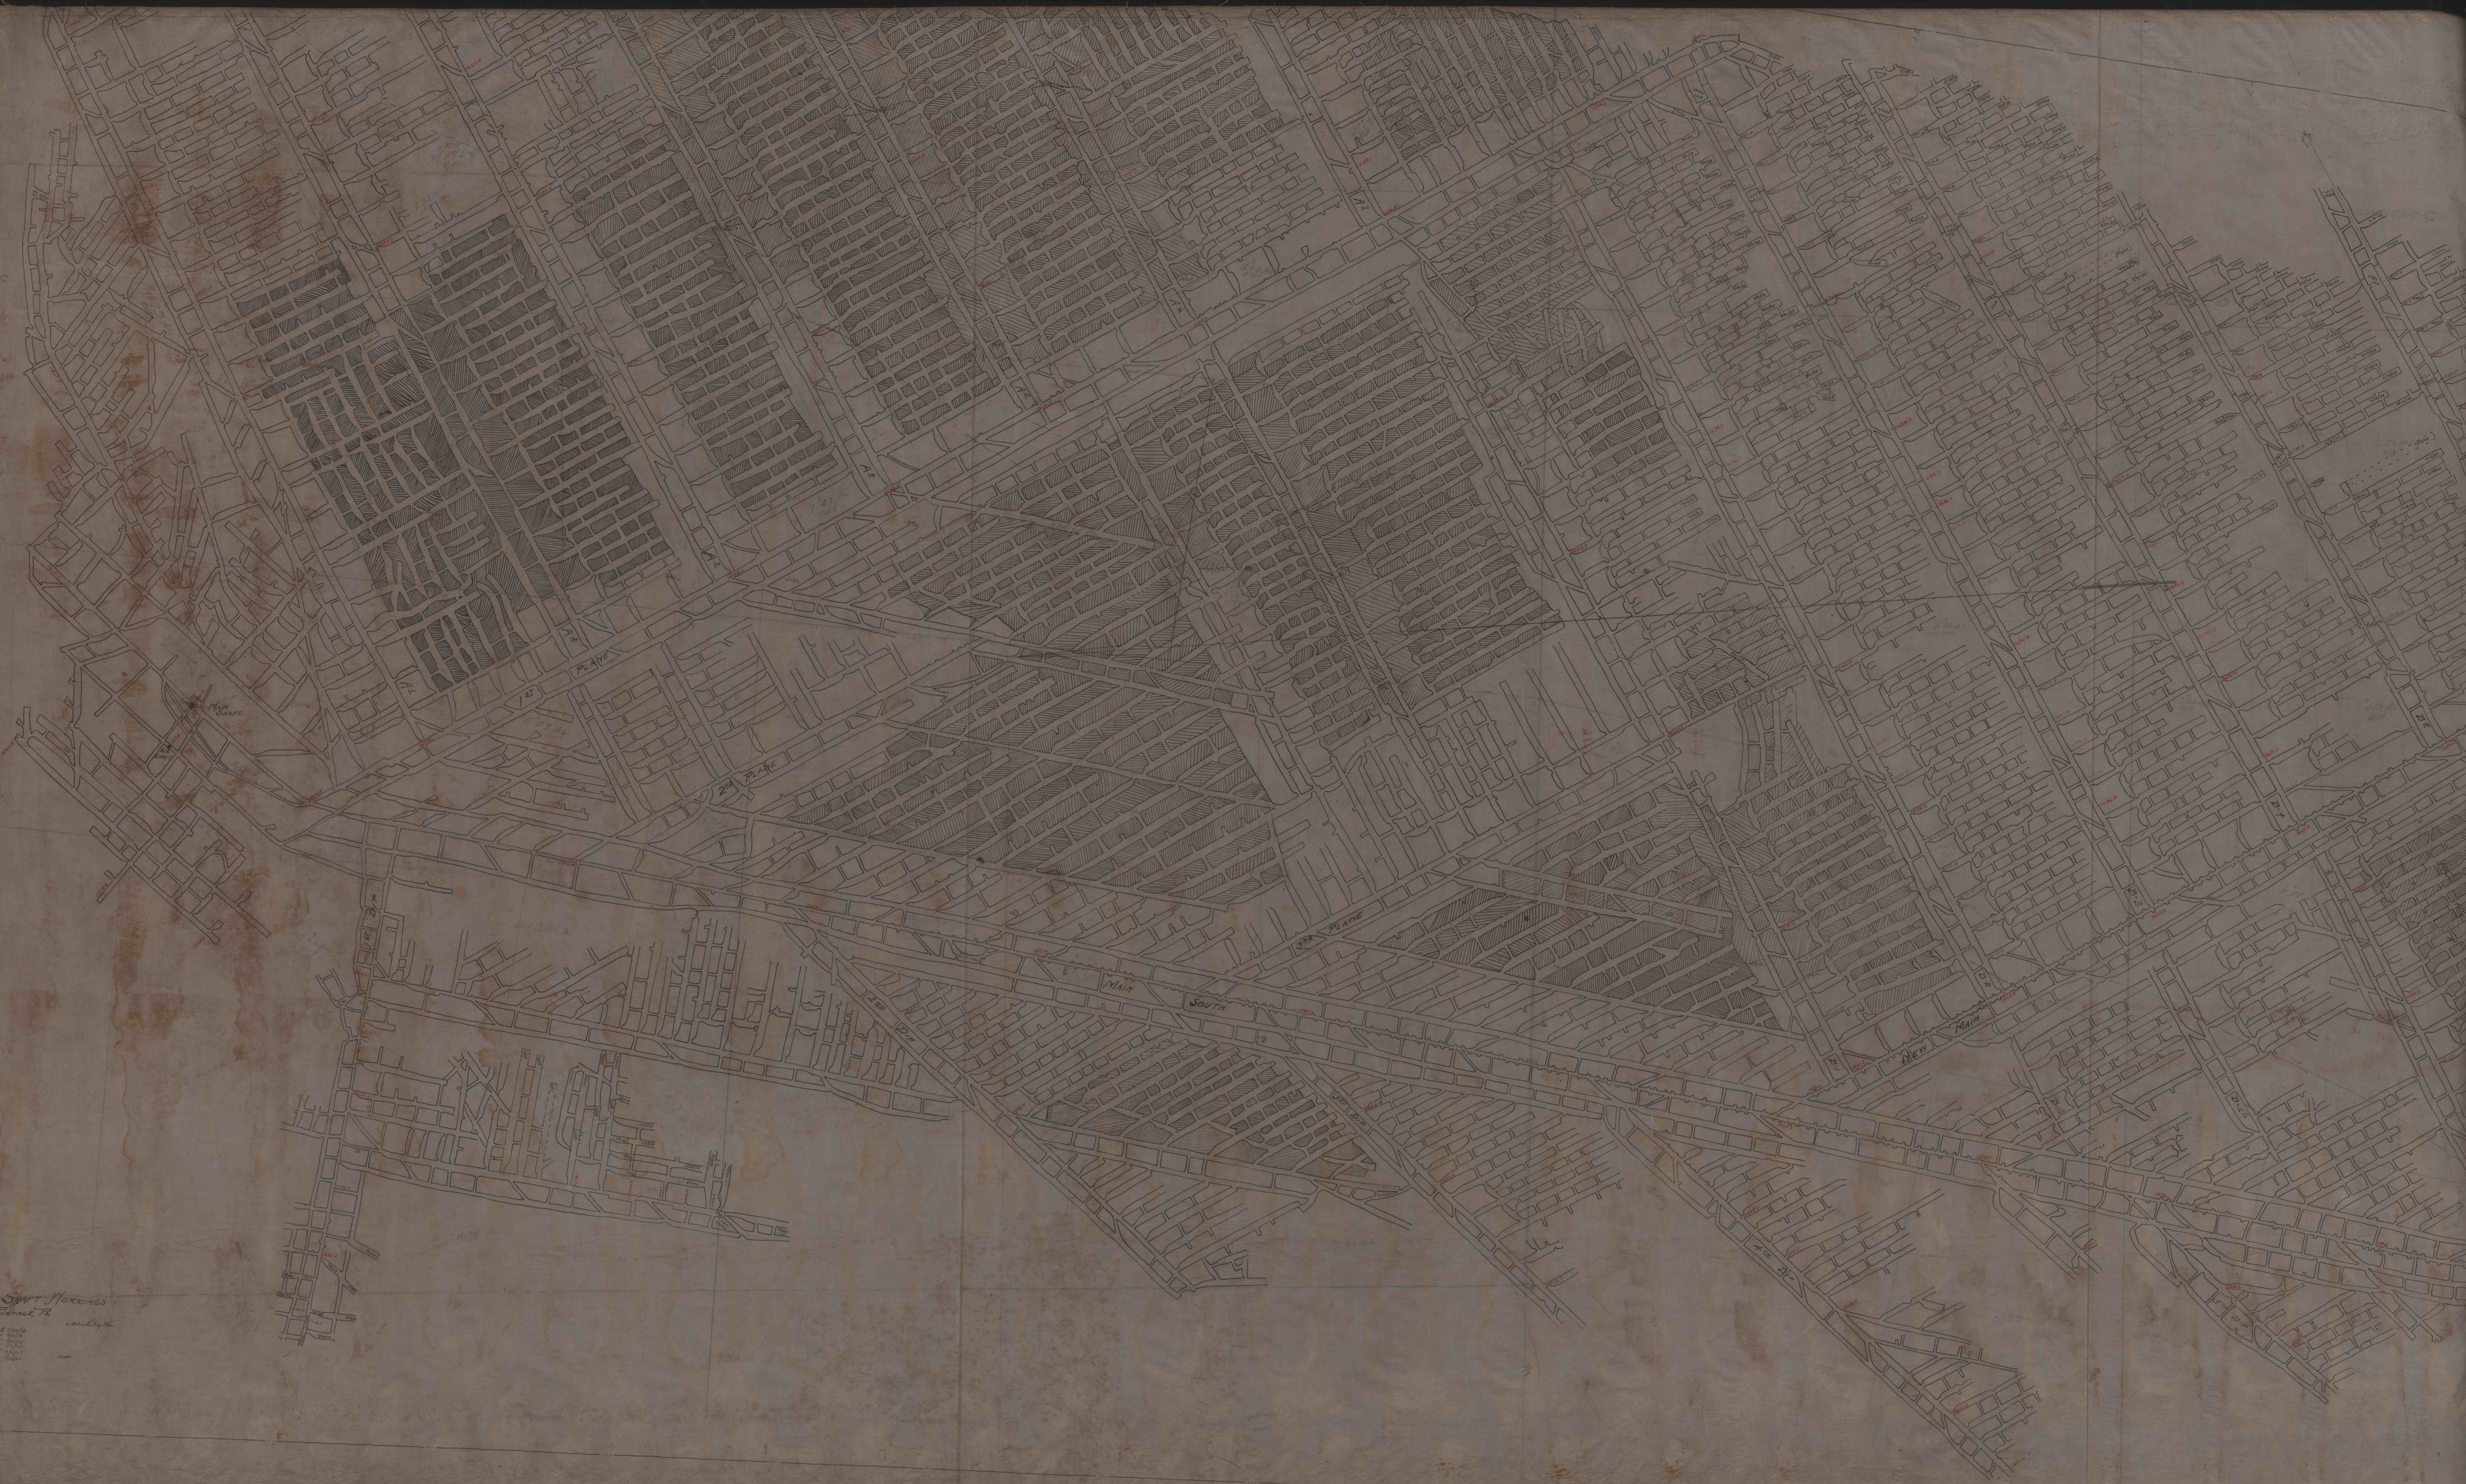

Map of
Scale 1/2 inch = 100 feet