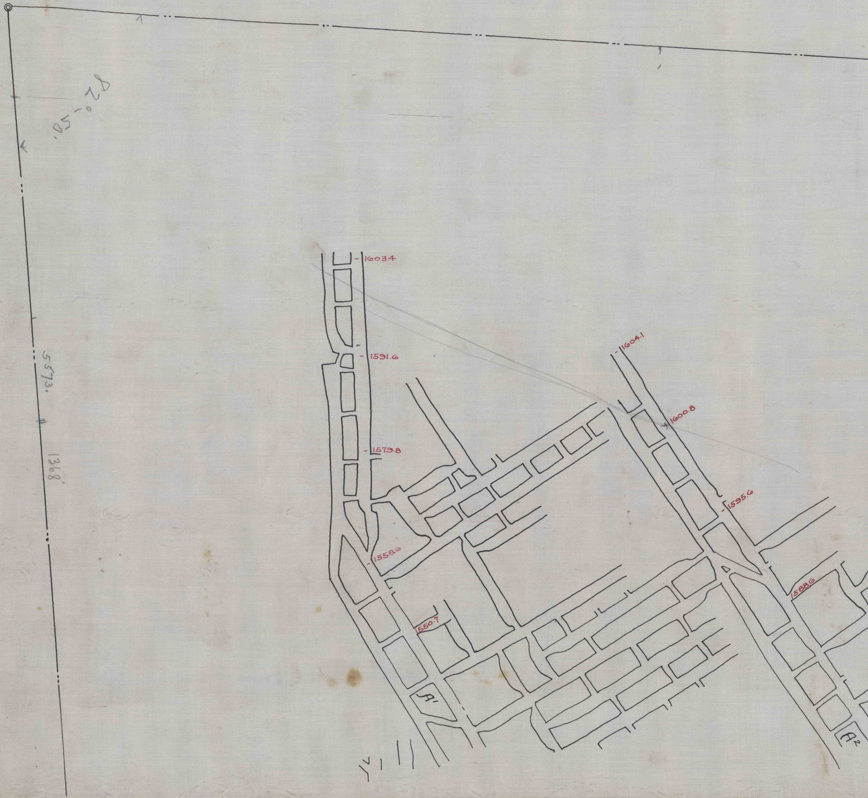
82°-58'
5573.
1368'
1603.4
1591.6
1579.8
1558.6
1550.7
1604.1
1600.8
1595.6
1588.6
A'
A²

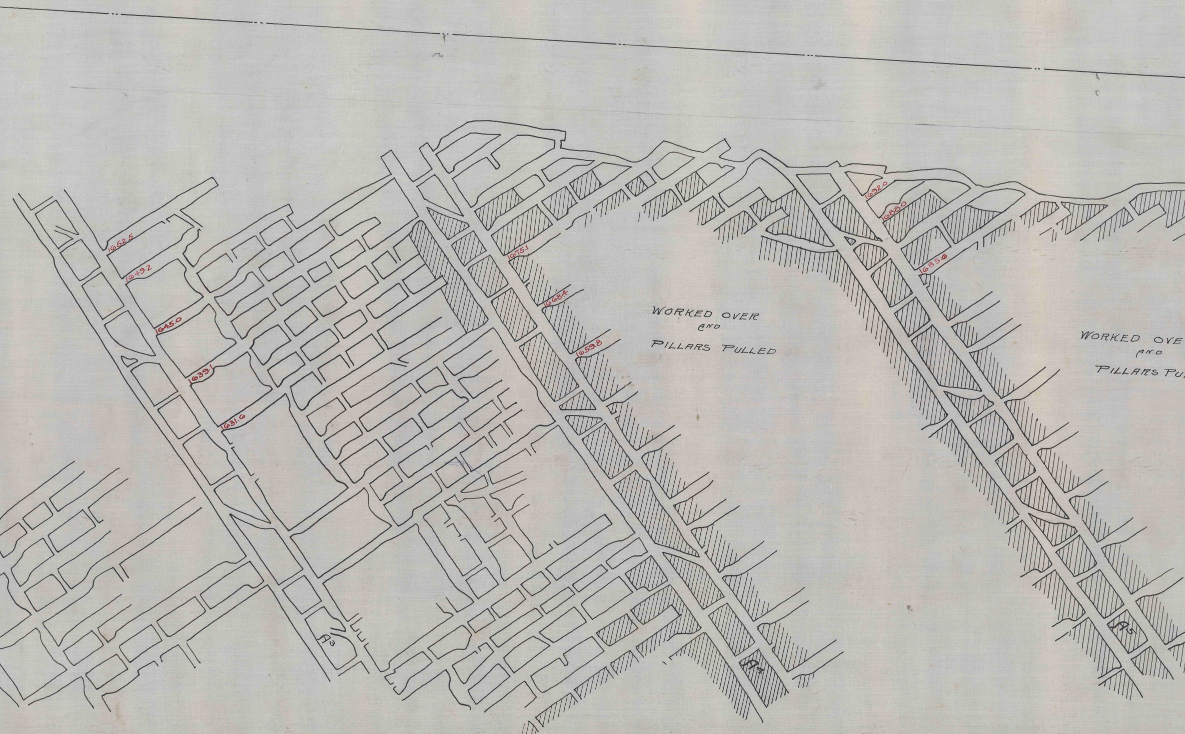
1652.5
1649.2
1645.0
1639.1
1631.6
1675.1
1668.4
1659.8
1692.0
1688.0
1685.6
WORKED OVER AND PILLARS PULLED
WORKED OVE AND PILLARS PU
A3
A4
A5

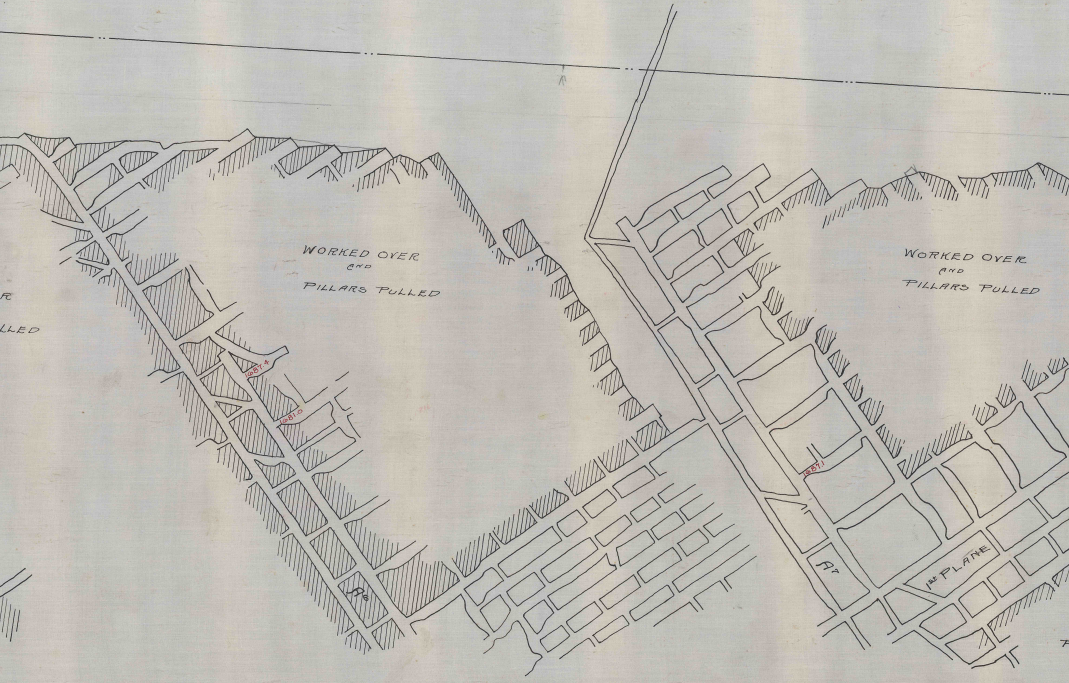
R
LLED
WORKED OVER
AND
PILLARS PULLED
687.4
681.0
A6
WORKED OVER
AND
PILLARS PULLED
687.1
A7
1st PLANE
P

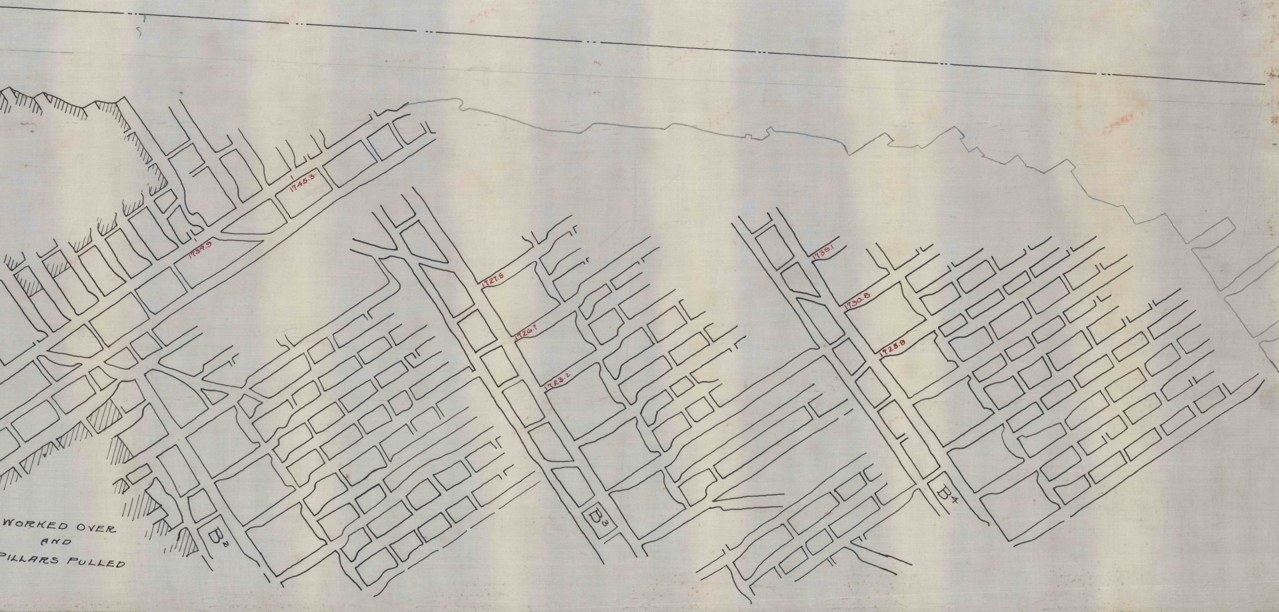
1745.3
1739.9
1727.5
1726.7
1723.2
1739.1
1730.8
1725.8
B2
B3
B4
WORKED OVER
AND
PILLARS PULLED