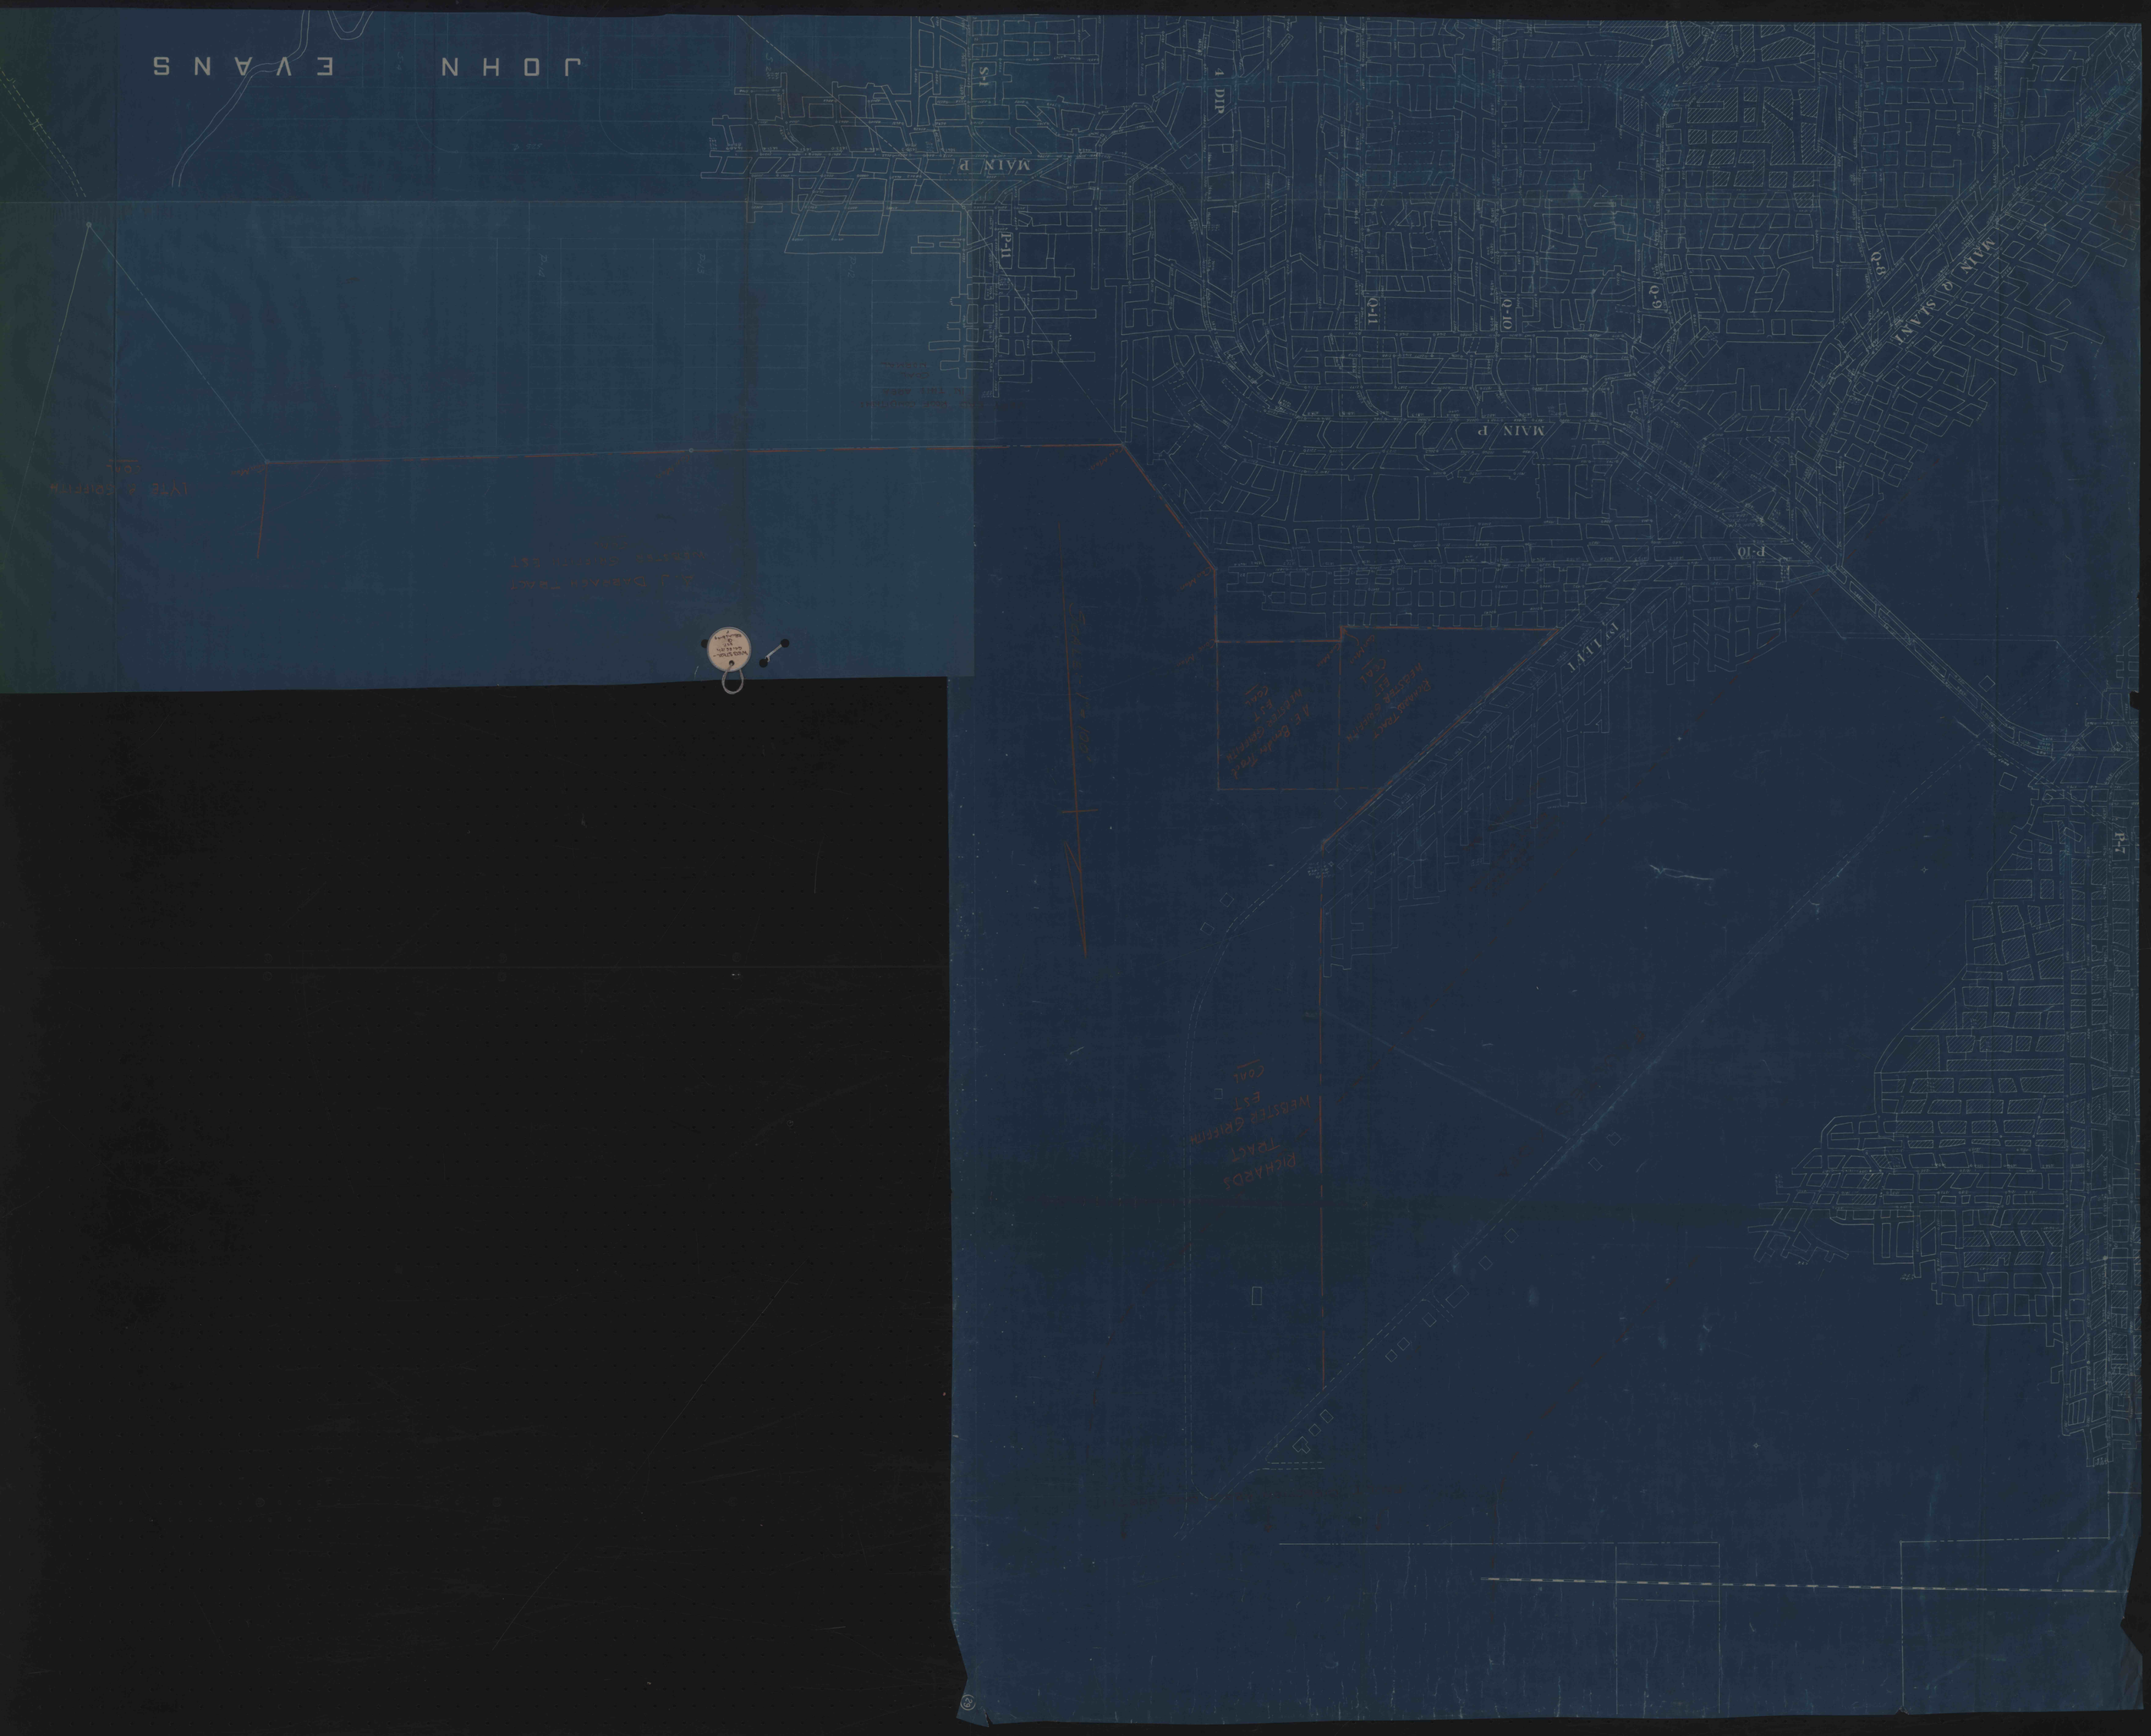
JOHN EVANS
MAIN P
MAIN P
MAIN Q SLANT
4 DIP
S-1
P-11
Q-11
Q-10
Q-9
Q-8
P-10
P-7