


600

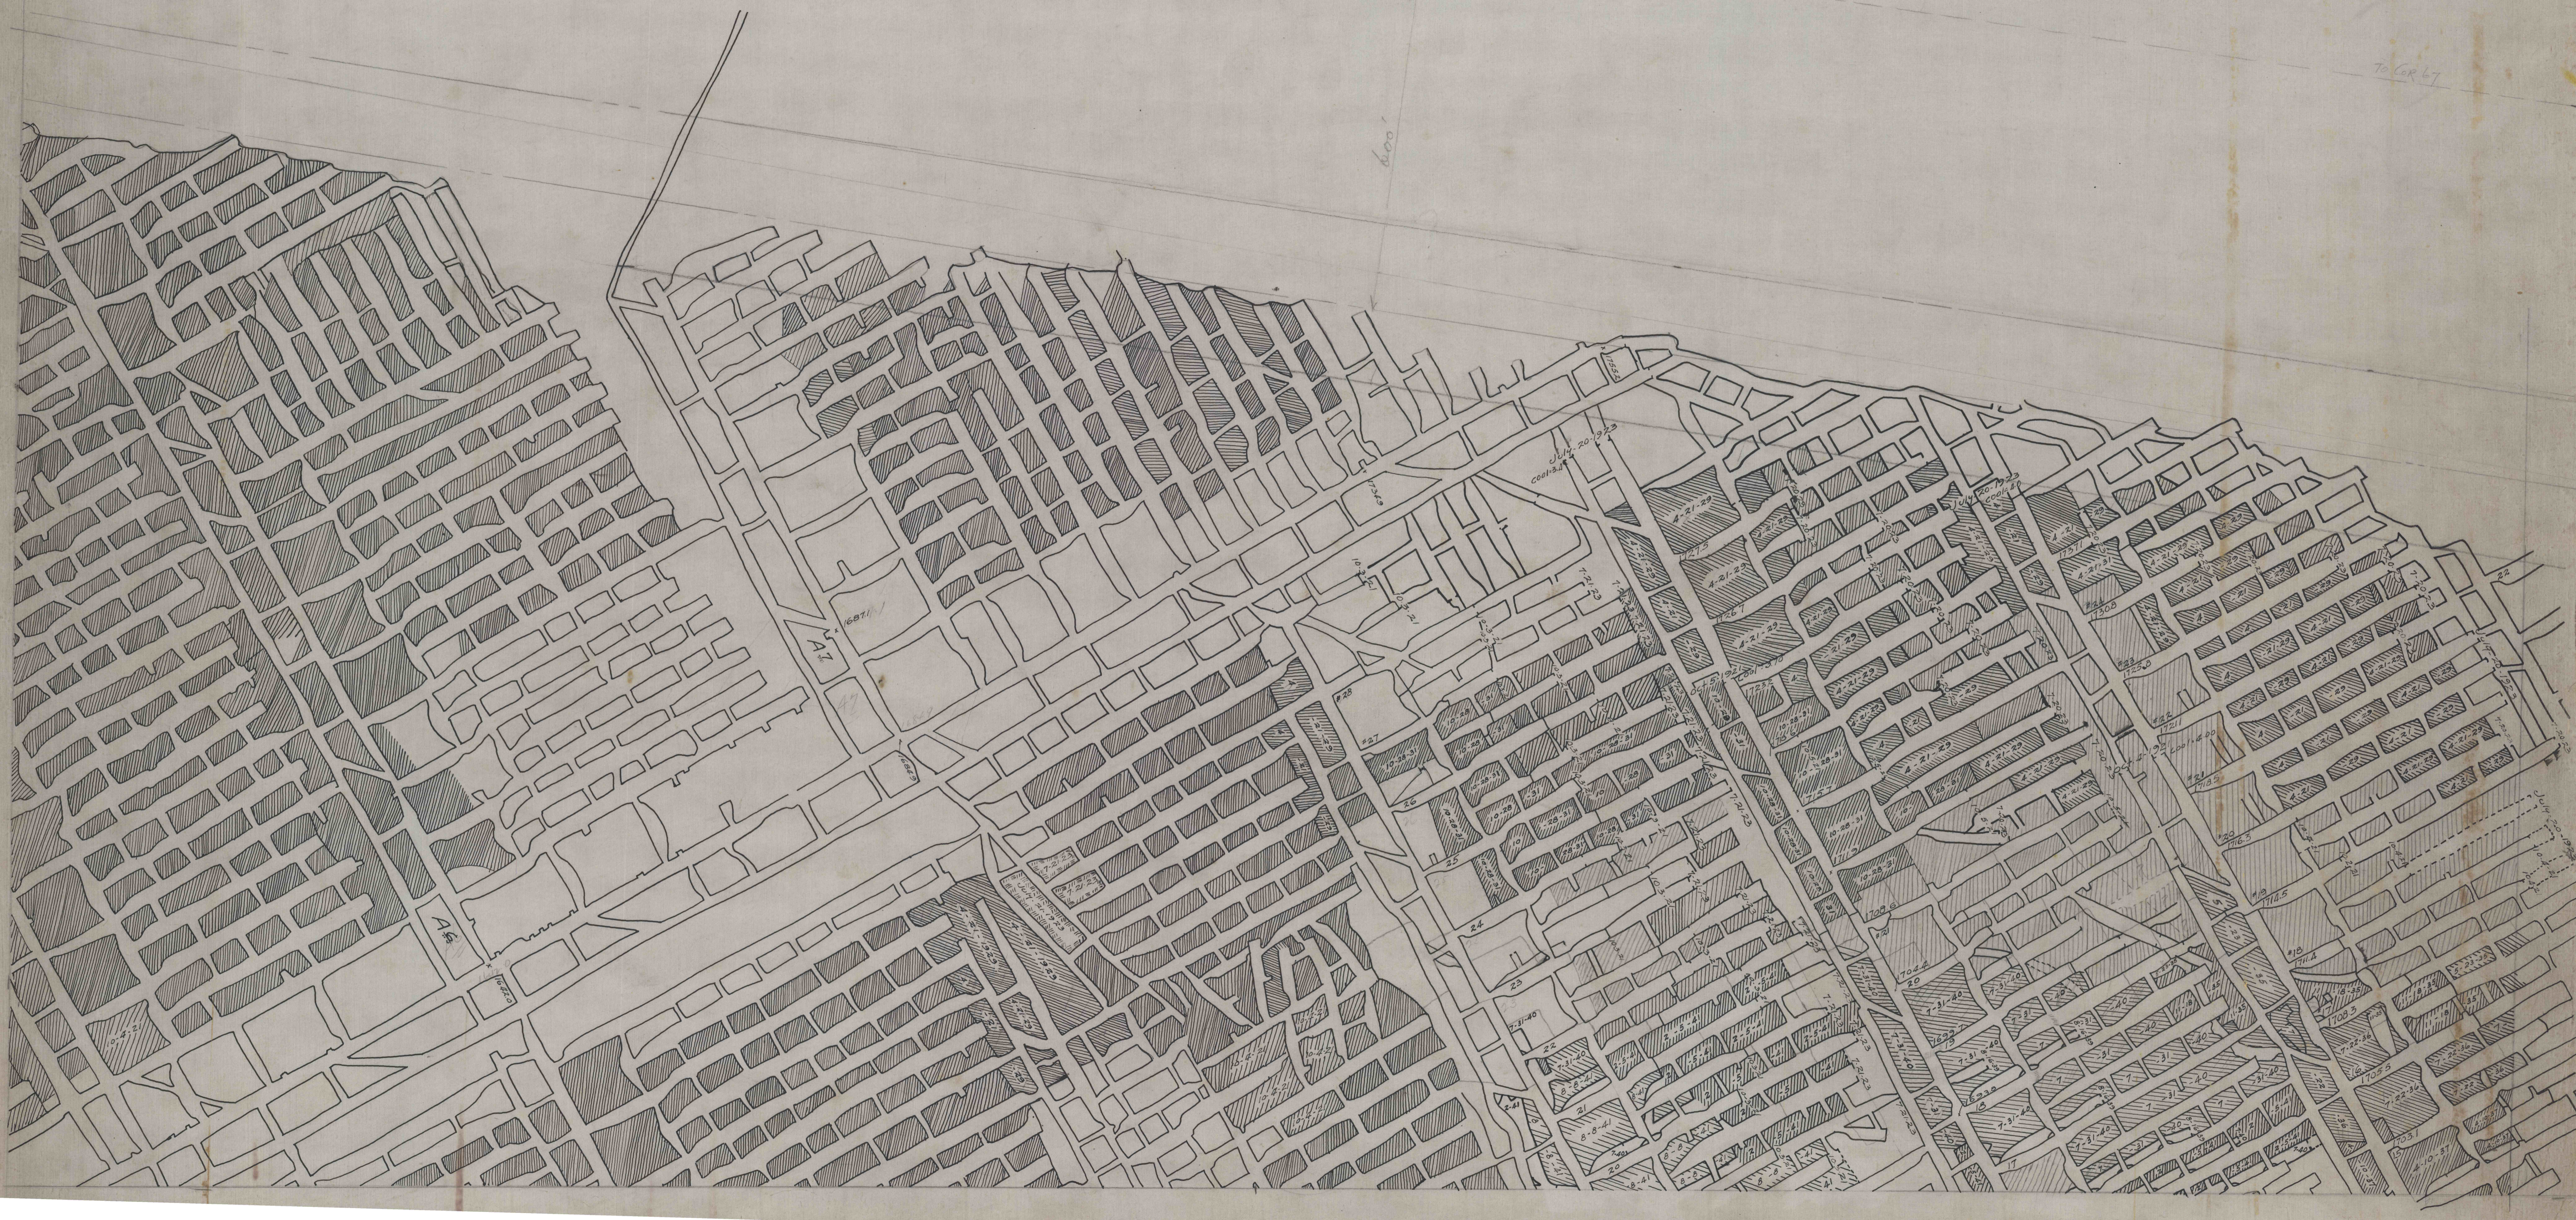

1687.1

July 20 1923

July 20 1923
COOLIDGE


1048
20

1003

1031