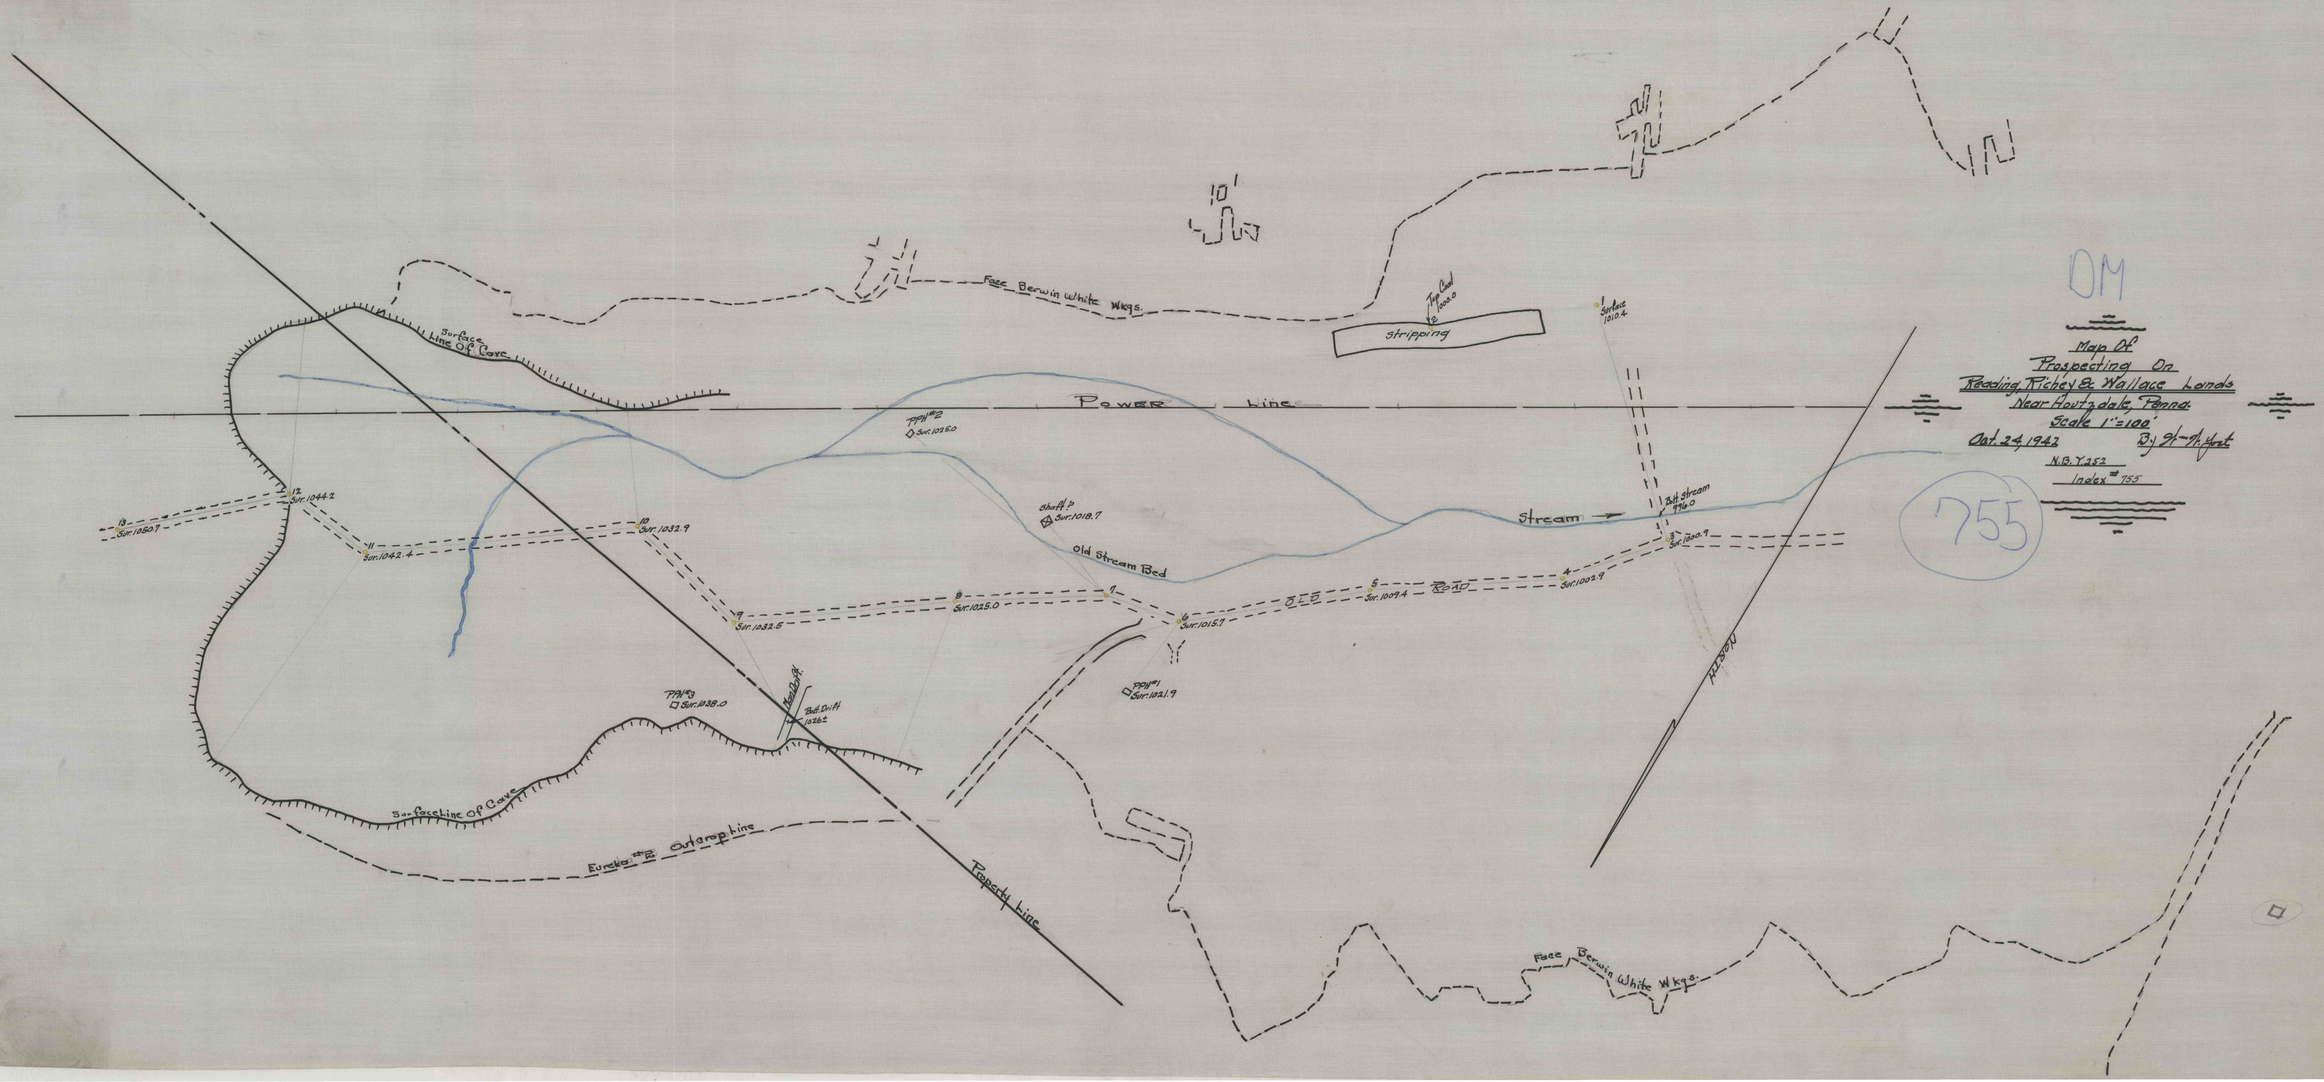
Map Of
Prospecting On
Reading, Richey & Wallace Lands
Near Houtzdale, Penna.
Scale 1"=100'
Oct. 24, 1942
By H. Yost
N.B. Y.252
Index # 755
755
DM
Face Berwin White Wkgs.
Surface Line Of Cave
Power Line
Stripping
Top Coal 1000.0
Surface 1010.4
Stream
Bott. Stream 996.0
Old Stream Bed
Shaft? Sur. 1018.7
PPH #2 Sur. 1025.0
PPH #1 Sur. 1021.9
PPH #3 Sur. 1038.0
Bott. Drift 1026±
Surface Line Of Cave
Eureka #2 Outcrop Line
Property Line
Face Berwin White Wkgs.
Old Road
North
Sur. 1050.7
Sur. 1044.2
Sur. 1042.4
Sur. 1032.9
Sur. 1032.5
Sur. 1025.0
Sur. 1015.7
Sur. 1009.4
Sur. 1002.9
Sur. 1000.9
Sur. 1010.4

1077

1077