


130

B911

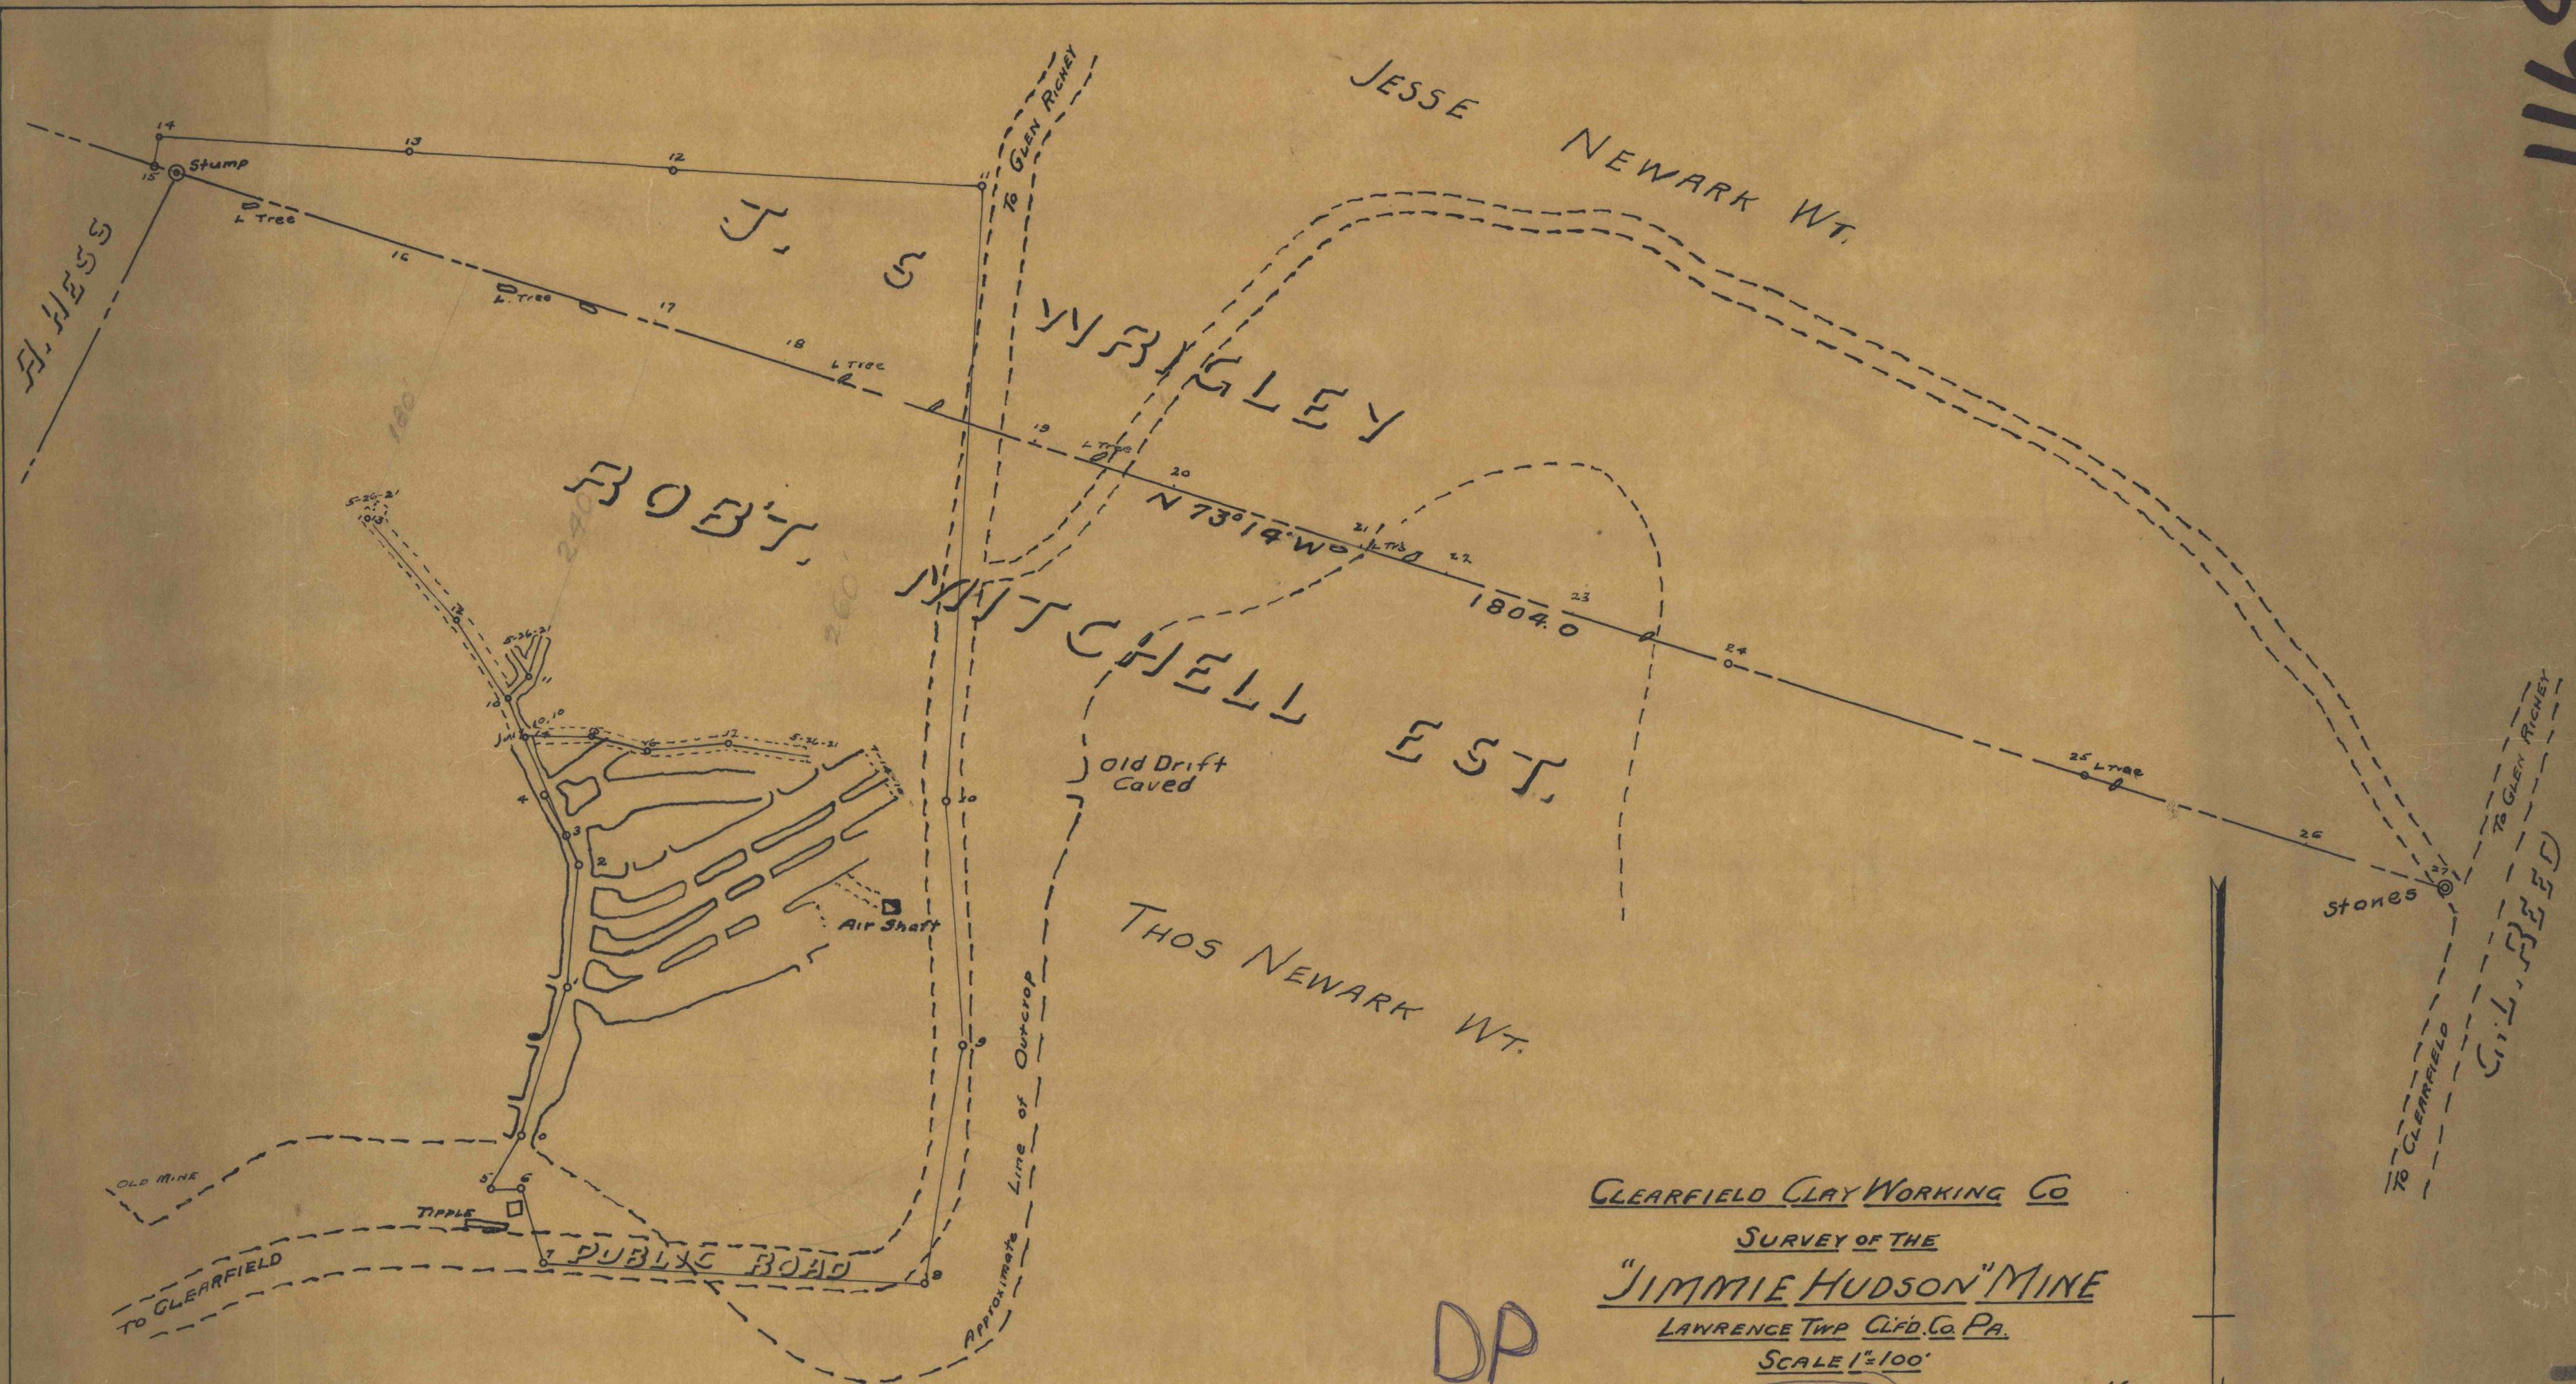

CLEARFIELD CLAY WORKING CO

SURVEY OF THE

"JIMMIE HUDSON" MINE

LAWRENCE TWP. CLFD. CO. PA.

SCALE 1"=100'

DP

CLEARFIELD PA

JULY 20, 1910

RESURVEYED MAY 26, 1921.

733

OFFICE OF E. W. HESS
ENGINEER



B911