

210


210

A. F. BOYNTON, EST.

F. R. WALLACE.

F. R. WALLACE, RICHIE & WALLACE.

JOHN-M-CHASE EST.

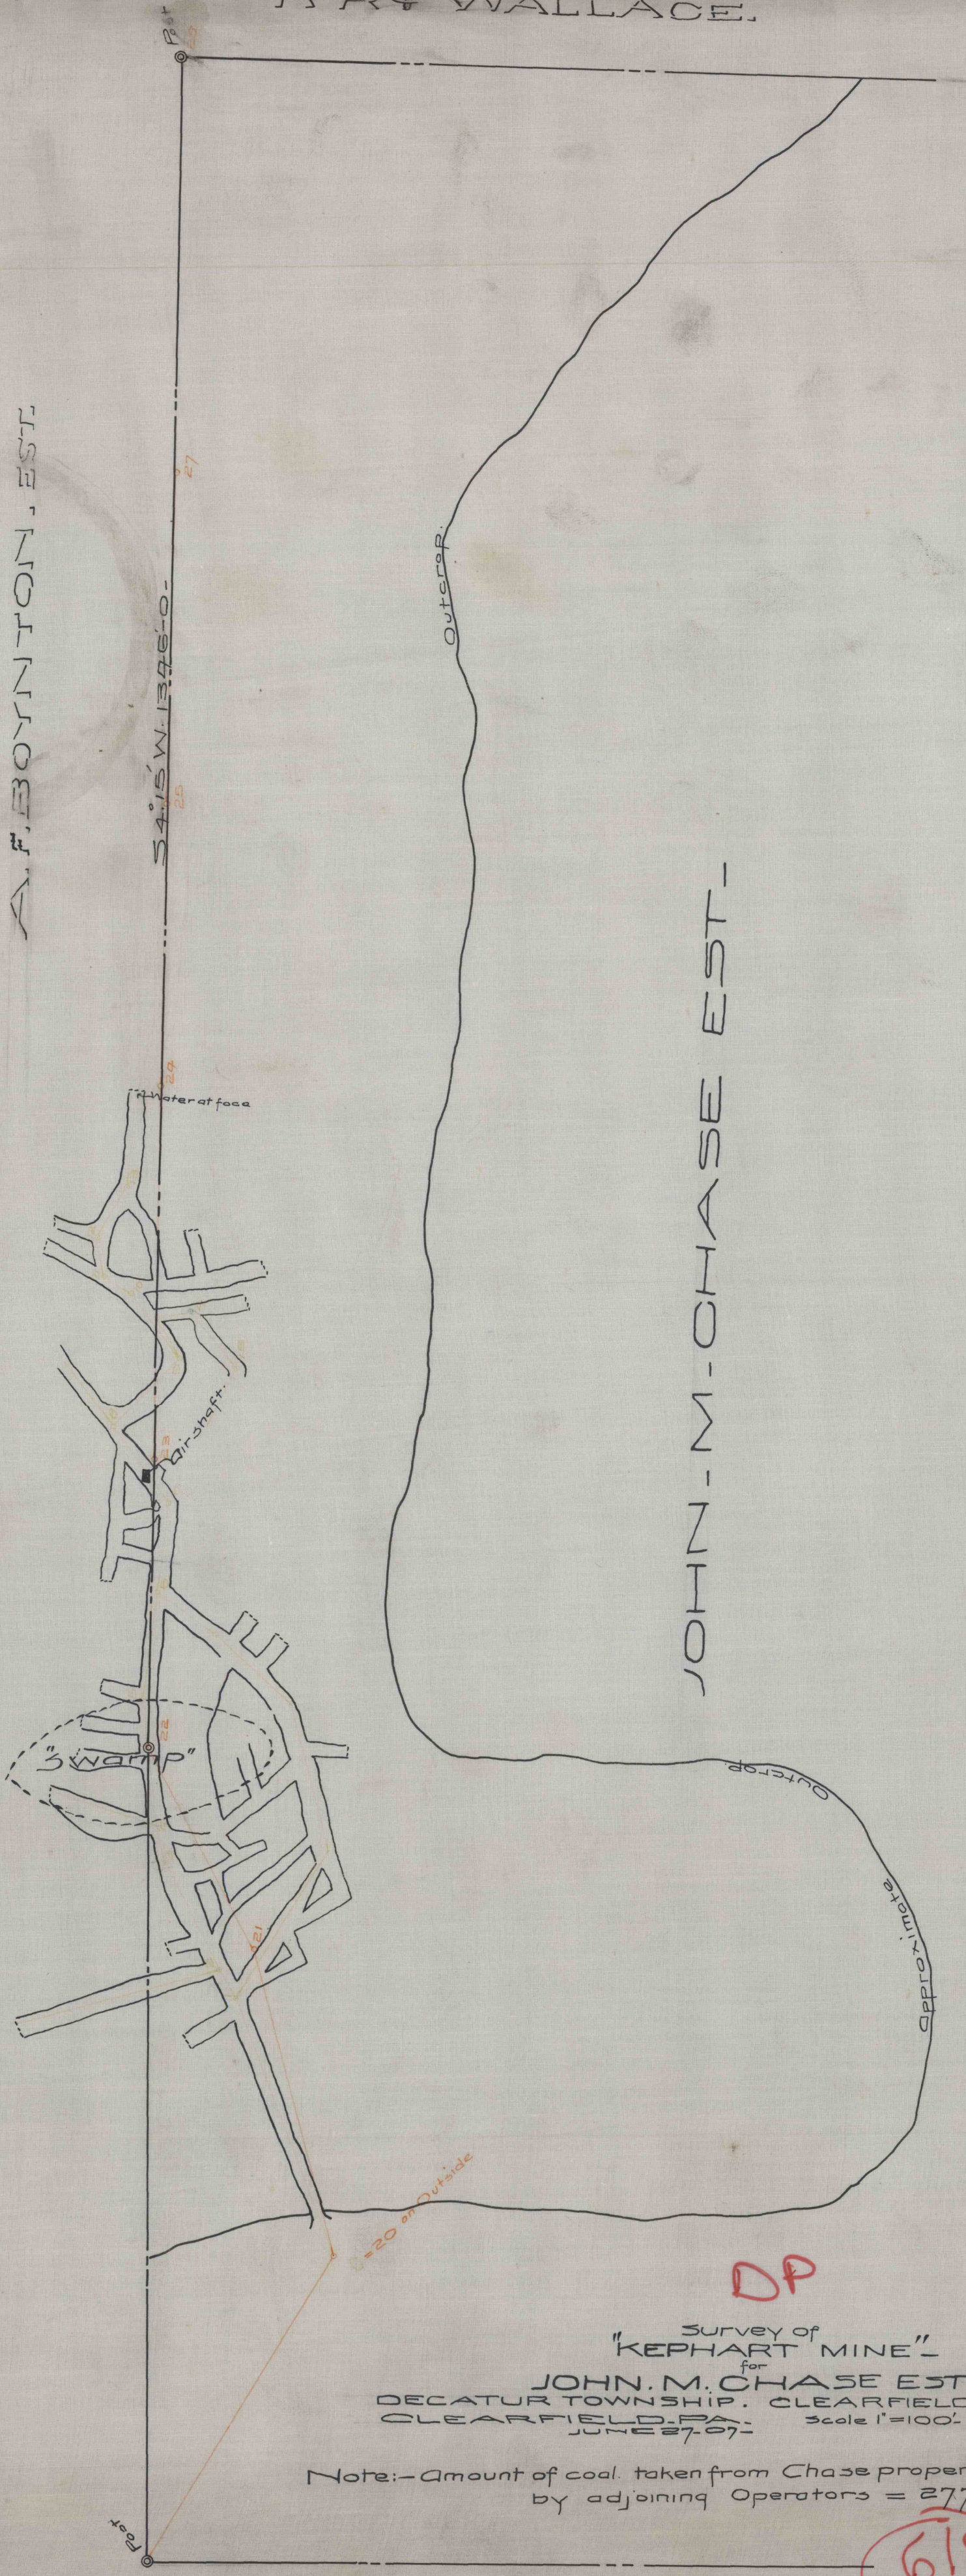

Survey of
 "KEPHART MINE"
 for
 JOHN. M. CHASE EST.
 DECATUR TOWNSHIP, CLEARFIELD COUNTY, PA.
 CLEARFIELD, PA. Scale 1"=100'. E.W. HESS
 JUNE 27, 07. Engr.

Note: - Amount of coal taken from Chase property
 by adjoining Operators = 277.5 Tons -

618

1369

812
 P. 201