

1434

EMIL DERMINER

1434

A.A. MURRAY TRACT

WORKED OUT


WORKED OUT

WORKED OUT

WORKED OUT

WORKED OUT

EDWARD DERMINER

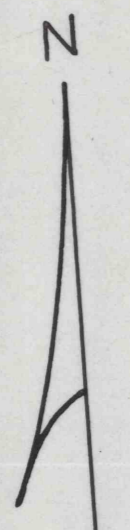

TIPPLE

1.83 ACRES

SEAM

STRIPPING

SEAM

CANNEL

CANNEL

SPILLS
COAL
5.70 ACRES

STRIPPING

SEAM

1.63 ACRES

0.25 ACRES

FANNIE DUNCAN TRACT
NOW
HAROLD WOOLRIDGE "IN FEE"

J. O. LEONARD TRACT

D

NOTE:
8-10-61 BACKFILLED & LEVELED 7.58 ACRES
AREA LEFT TO BE MINED 10.00 ACRES IN YELLOW

MAP OF "C" SEAM CANNEL COAL MINE
OPERATED BY W. B. MARTELL
GIRARD TOWNSHIP CLEARFIELD COUNTY PENNA.
SCALE 1"=100' AUG. 10, 1961
C.D. 414 BERNARD LUCAS ASSOCIATES

HOWE ESTATE

E. MEROT ROAD

TO ROUTE NO. 879

TWP ROAD NO. 11 T. 633

TOWNSHIP ROAD

TO ROUTE NO. 879

TO ROUTE NO. 879

MINE ROAD

SPILLING ROAD

ROAD

HIGH WALL 2-17-63

APPROX. LOCATION HIGH WALL COVERED BY "D" SEAM STRIPPING SPILLS

HIGH WALL 8-7-63

HIGH WALL 8-7-63

