


1470


JAMES WHITTAKER TRACT
L. V. C. CO. COAL & SURFACE

J. WHITTAKER TRACT

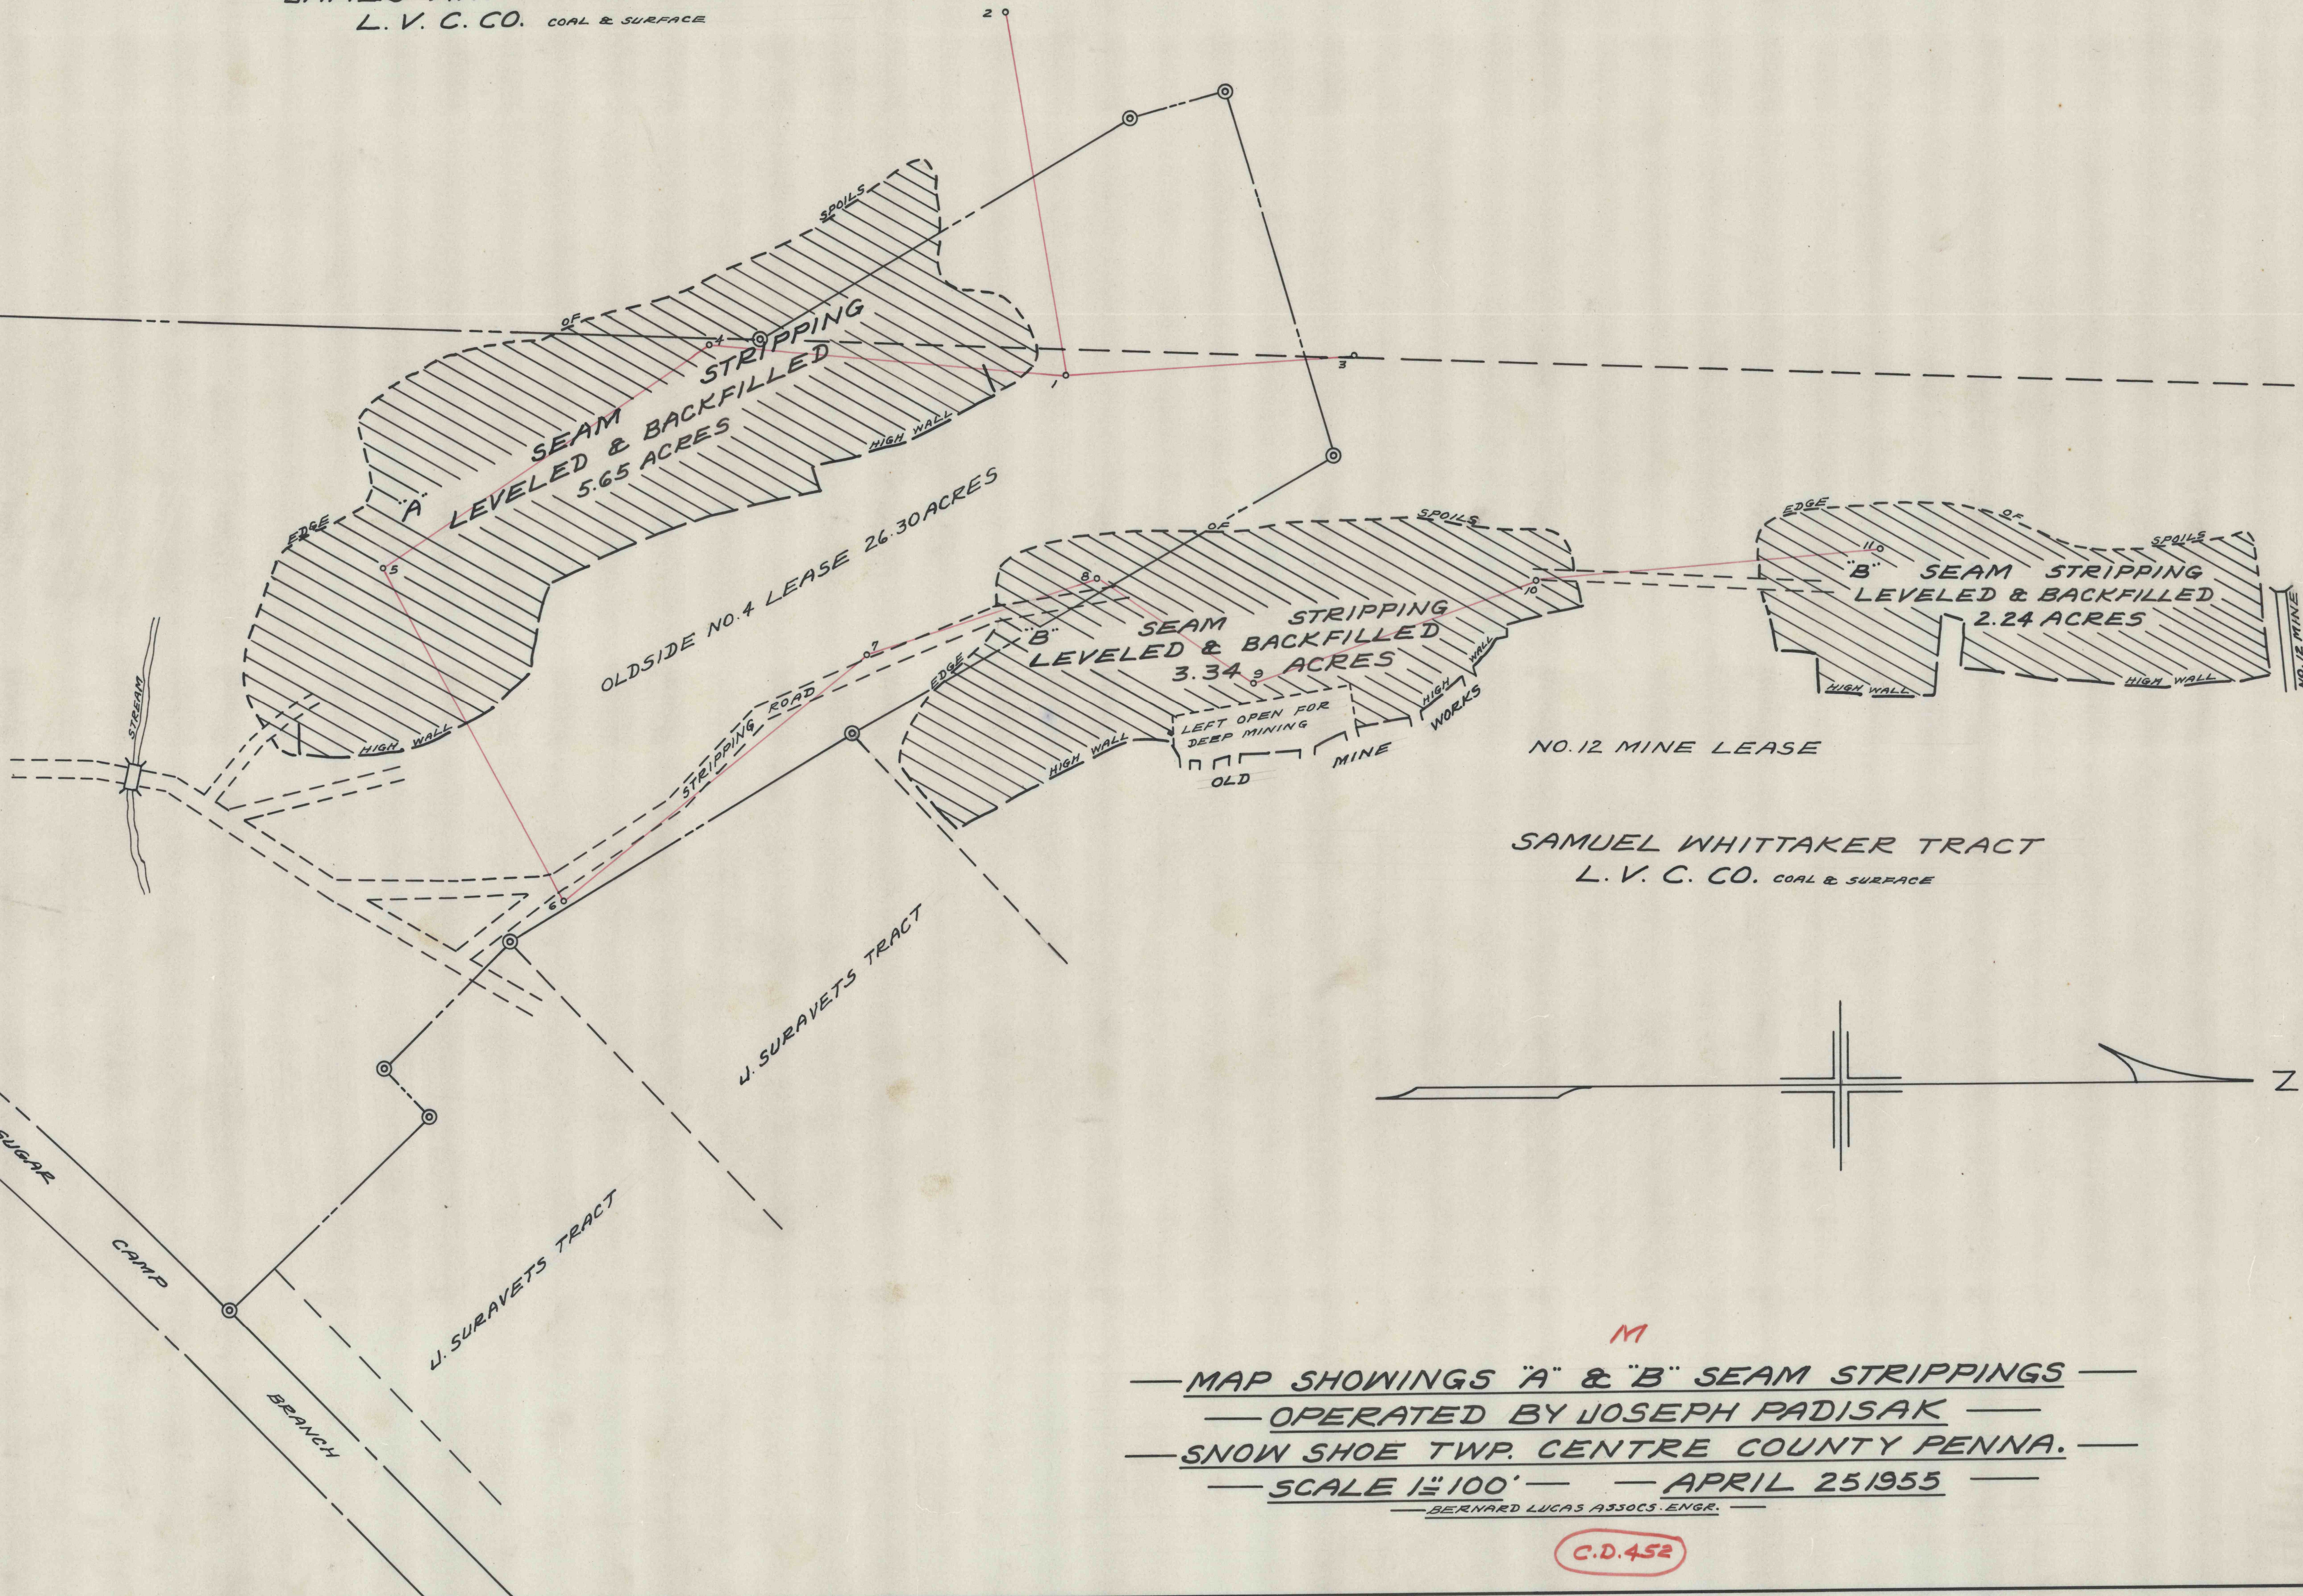

NO. 12 MINE LEASE

SAMUEL WHITTAKER TRACT
L. V. C. CO. COAL & SURFACE

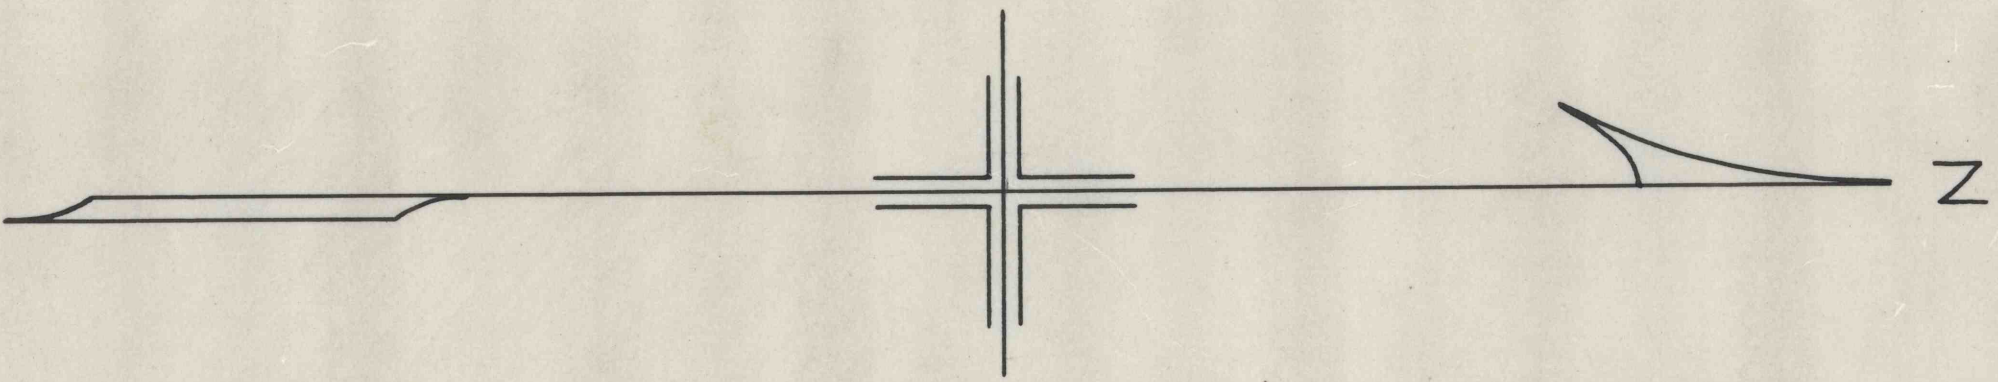

M
 — MAP SHOWINGS "A" & "B" SEAM STRIPPINGS —
 — OPERATED BY JOSEPH PADISAK —
 — SNOW SHOE TWP. CENTRE COUNTY PENNA. —
 — SCALE 1"=100' — APRIL 25 1955 —
 — BERNARD LUCAS A330C3 - ENGR. —

C.D.452

1470