

TO CLARENCE  
0.75 MILES

SUGAR CAMP  
NO. 2 B' MINE

EDGE  
D SEAM STRIPPING  
BACKFILLED & LEVELED  
5.73 ACRES  
HIGH WALL

SAMUEL WHITAKER TRACT  
LEHIGH VALLEY COAL CO.


STRIPPED  
BY OTHERS

POWER LINE

ANDREW CHAPMAN TRACT  
LEHIGH VALLEY COAL CO.

ANDY BOSOK SURF.

STRIPPED  
BY OTHERS

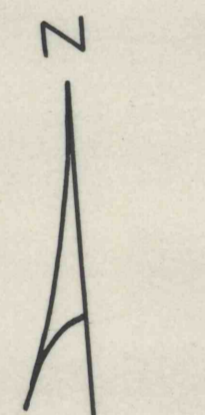

M

MAP OF "D" SEAM STRIPPING  
OPERATED BY JOSEPH PADISAK  
SNOW SHOE TWP. CENTRE COUNTY PA.  
SCALE 1" = 100' — SEPT. 28 1956  
BERNARD LUCAS ASSOC.

C.D. 452

IPA

1471