


W.M. QUICK

FRANK WILLIS

JAMES GRAY

PHILIPSBURG COAL & LAND COMPANY

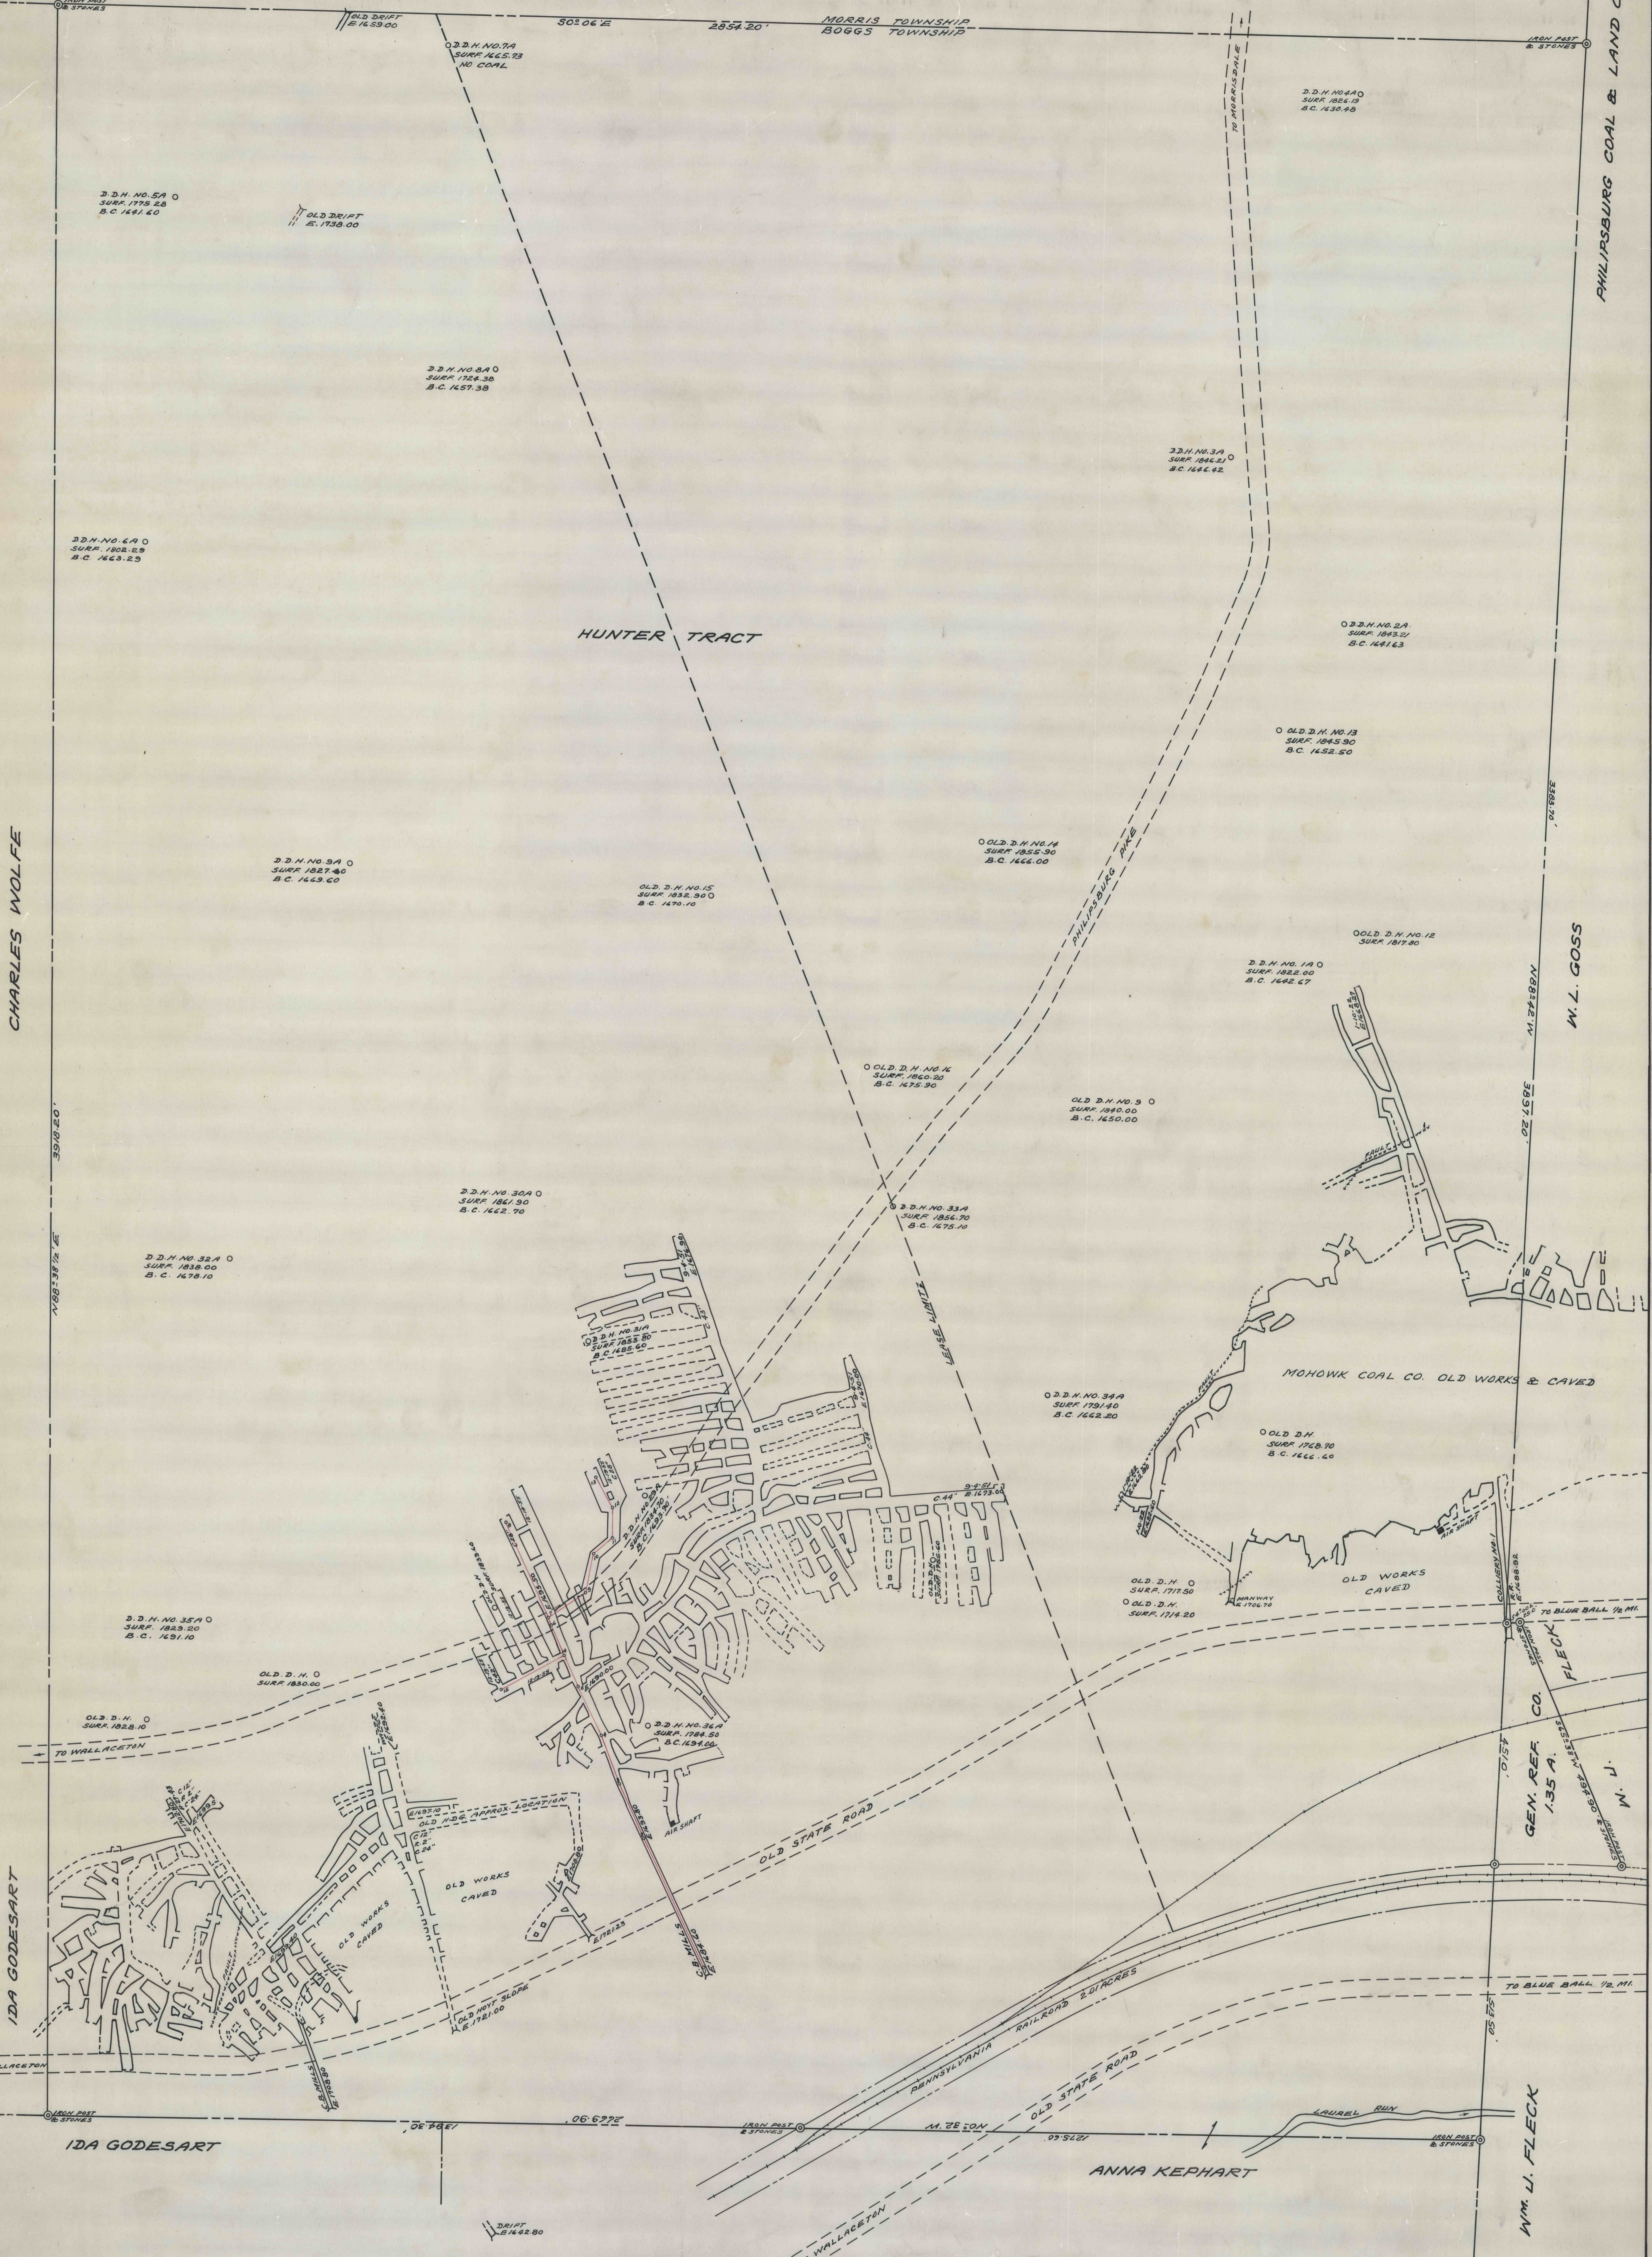

DH

MAP SHOWING JACKIE NO. 1 'A' SEAM MINE  
 OPERATED BY BANNER COAL COMPANY  
 BOGGS TWP CLEARFIELD COUNTY PENNA.  
 SCALE 1"=100' DEC. 28 1955  
 BERNARD LUCAS ASSOC. C.D. 431

1474