
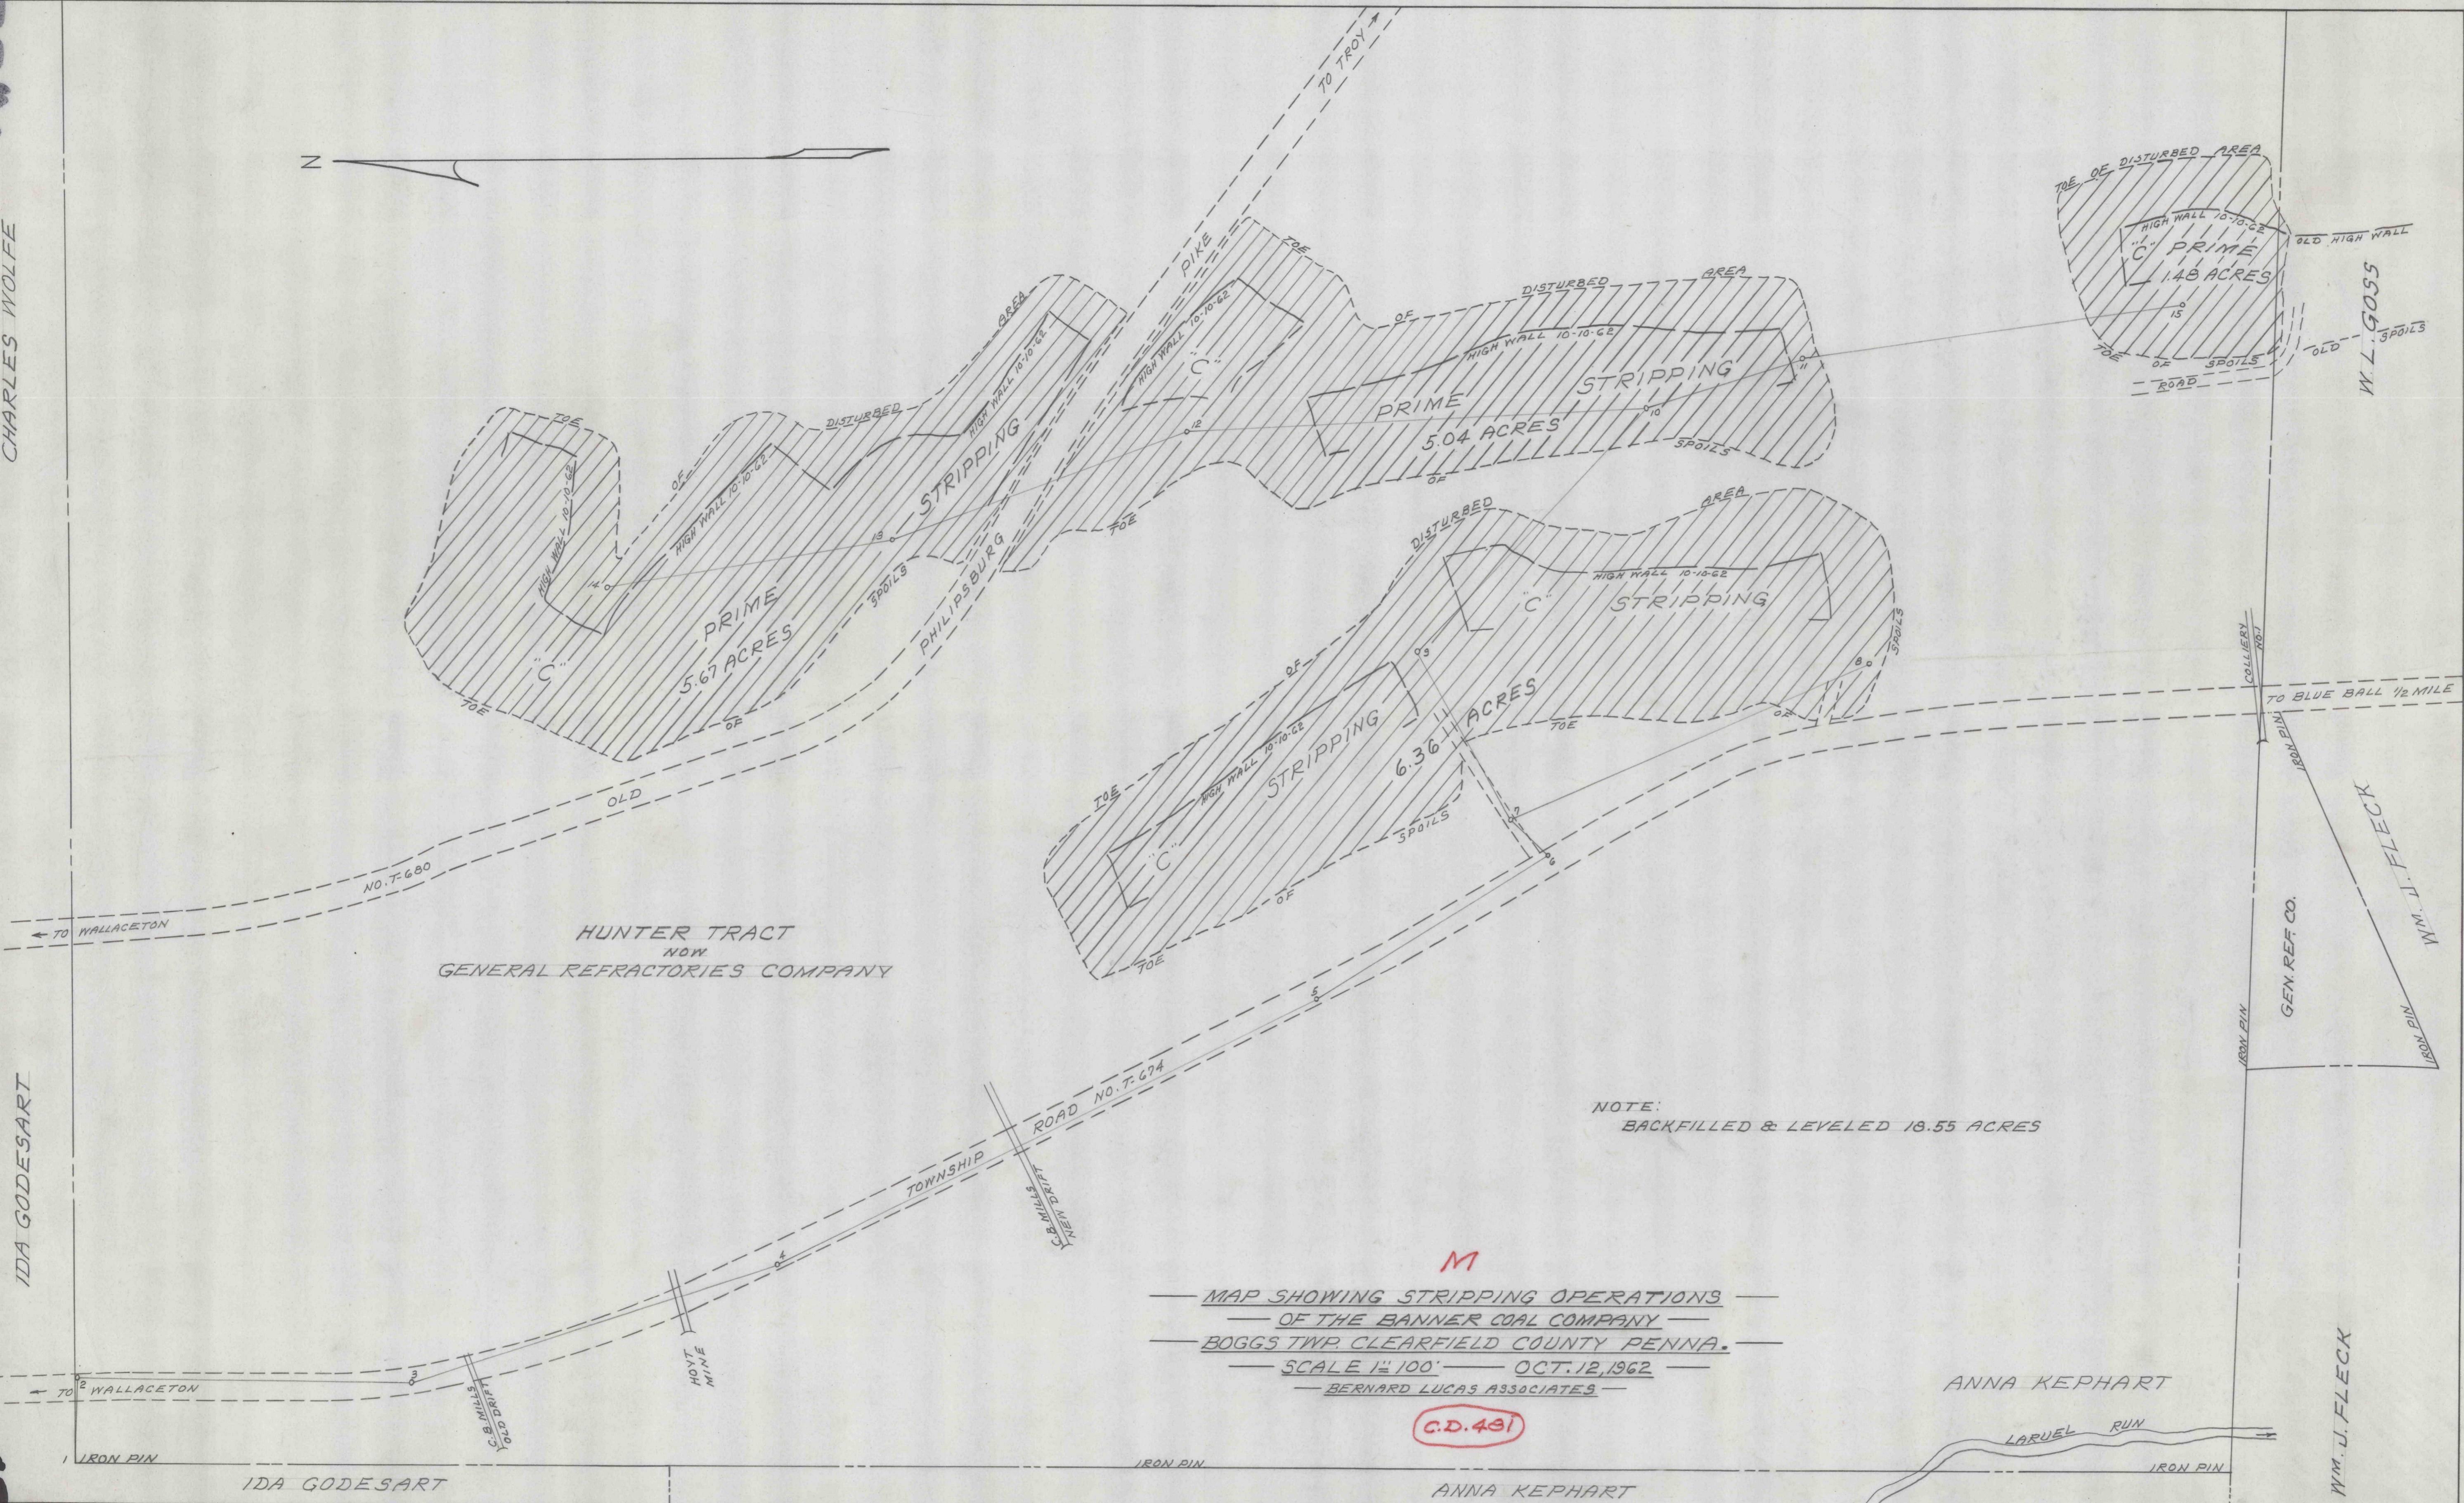


2741

CHARLES WOLFE

IDA GODESART

1475

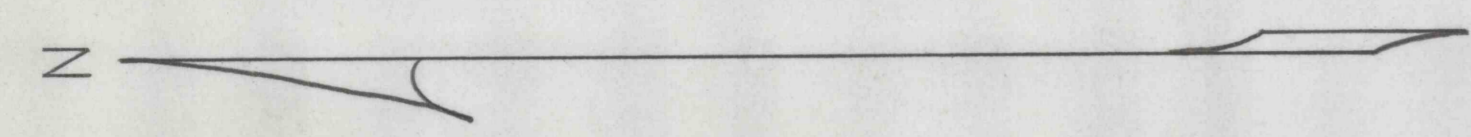

NOTE:
BACKFILLED & LEVELED 18.55 ACRES

M

— MAP SHOWING STRIPPING OPERATIONS —
 — OF THE BANNER COAL COMPANY —
 — BOGGS TWP. CLEARFIELD COUNTY PENNA. —
 — SCALE 1"=100' — OCT. 12, 1962 —
 — BERNARD LUCAS ASSOCIATES —

C.D. 481

W.M. J. FLECK