


1521

GEORGE STEINKIRCHNER
NOW
WILLIAM KNAPPER

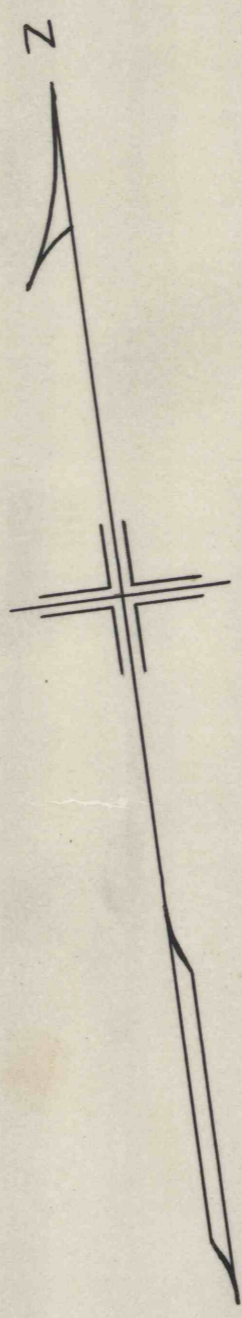

NOTE:
CAVED &/OR MINED OUT

ROBERT ROSENHAUER
NOW
JOE MOSSBARGER

CHRISTIAN HARTLE
NOW
JOHN MICKNEY

D
— MAP OF "B" SEAM MINE —
— OPERATED BY DRIFTING COAL COMPANY —
— COOPER TWP. CLEARFIELD CO. PA. —
— SCALE 1"=100' SEPT. 25 1953 —
— GUNNARD CARLSON —

C.D.488

MICHAEL RADER
NOW
MIKE FRANEK

1520

