


MELVIN WILKINSON TRACT

MEEK ESTATE

REMIZZA ESTATE

TO ROUTE 350 0.25 MILES

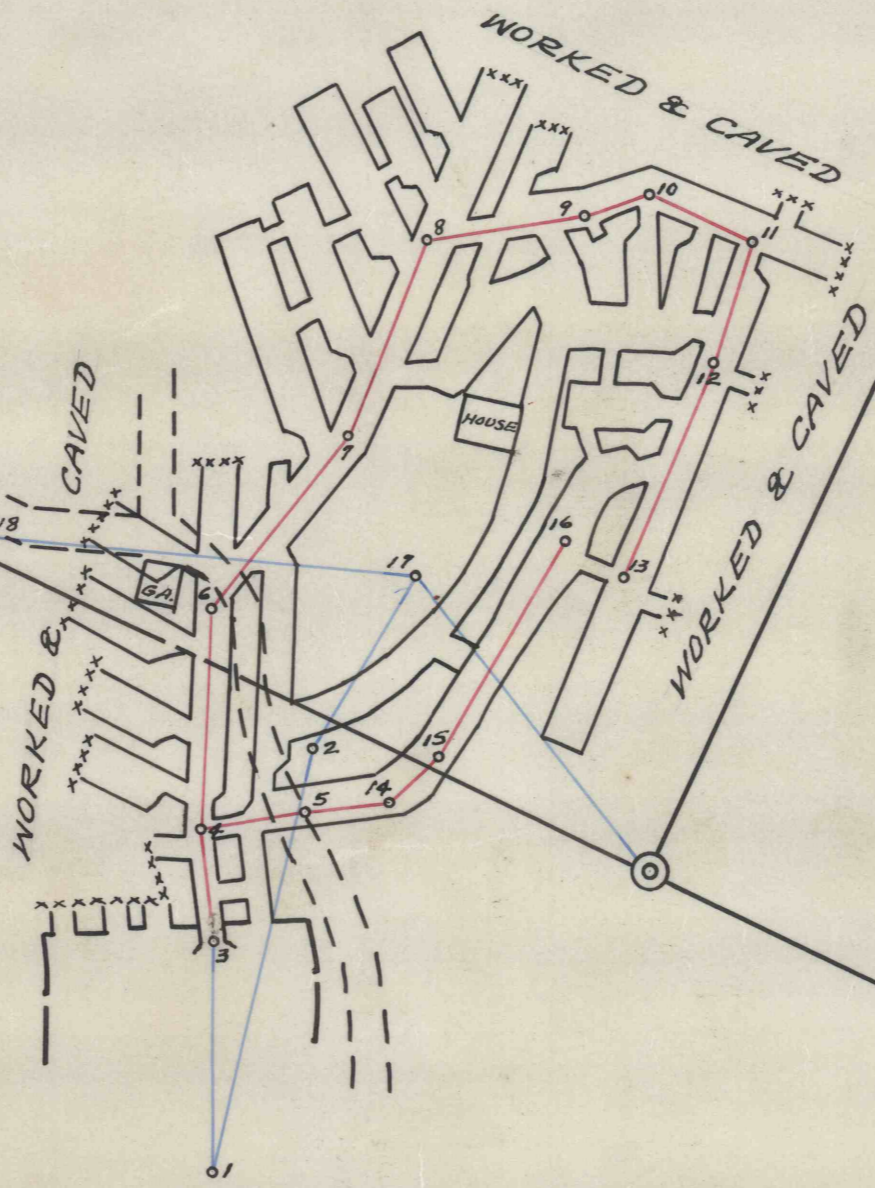

D

— MAP SHOWING "B" SEAM MINE —  
— OPERATED BY GEORGE WILKINSON —  
— RUSH TOWNSHIP CENTRE COUNTY PA —  
— SCALE 1"=100' — — JUNE 6 1955 —  
— BERNARD LUCAS ASSOC. —

1285

C.D.482

1586