
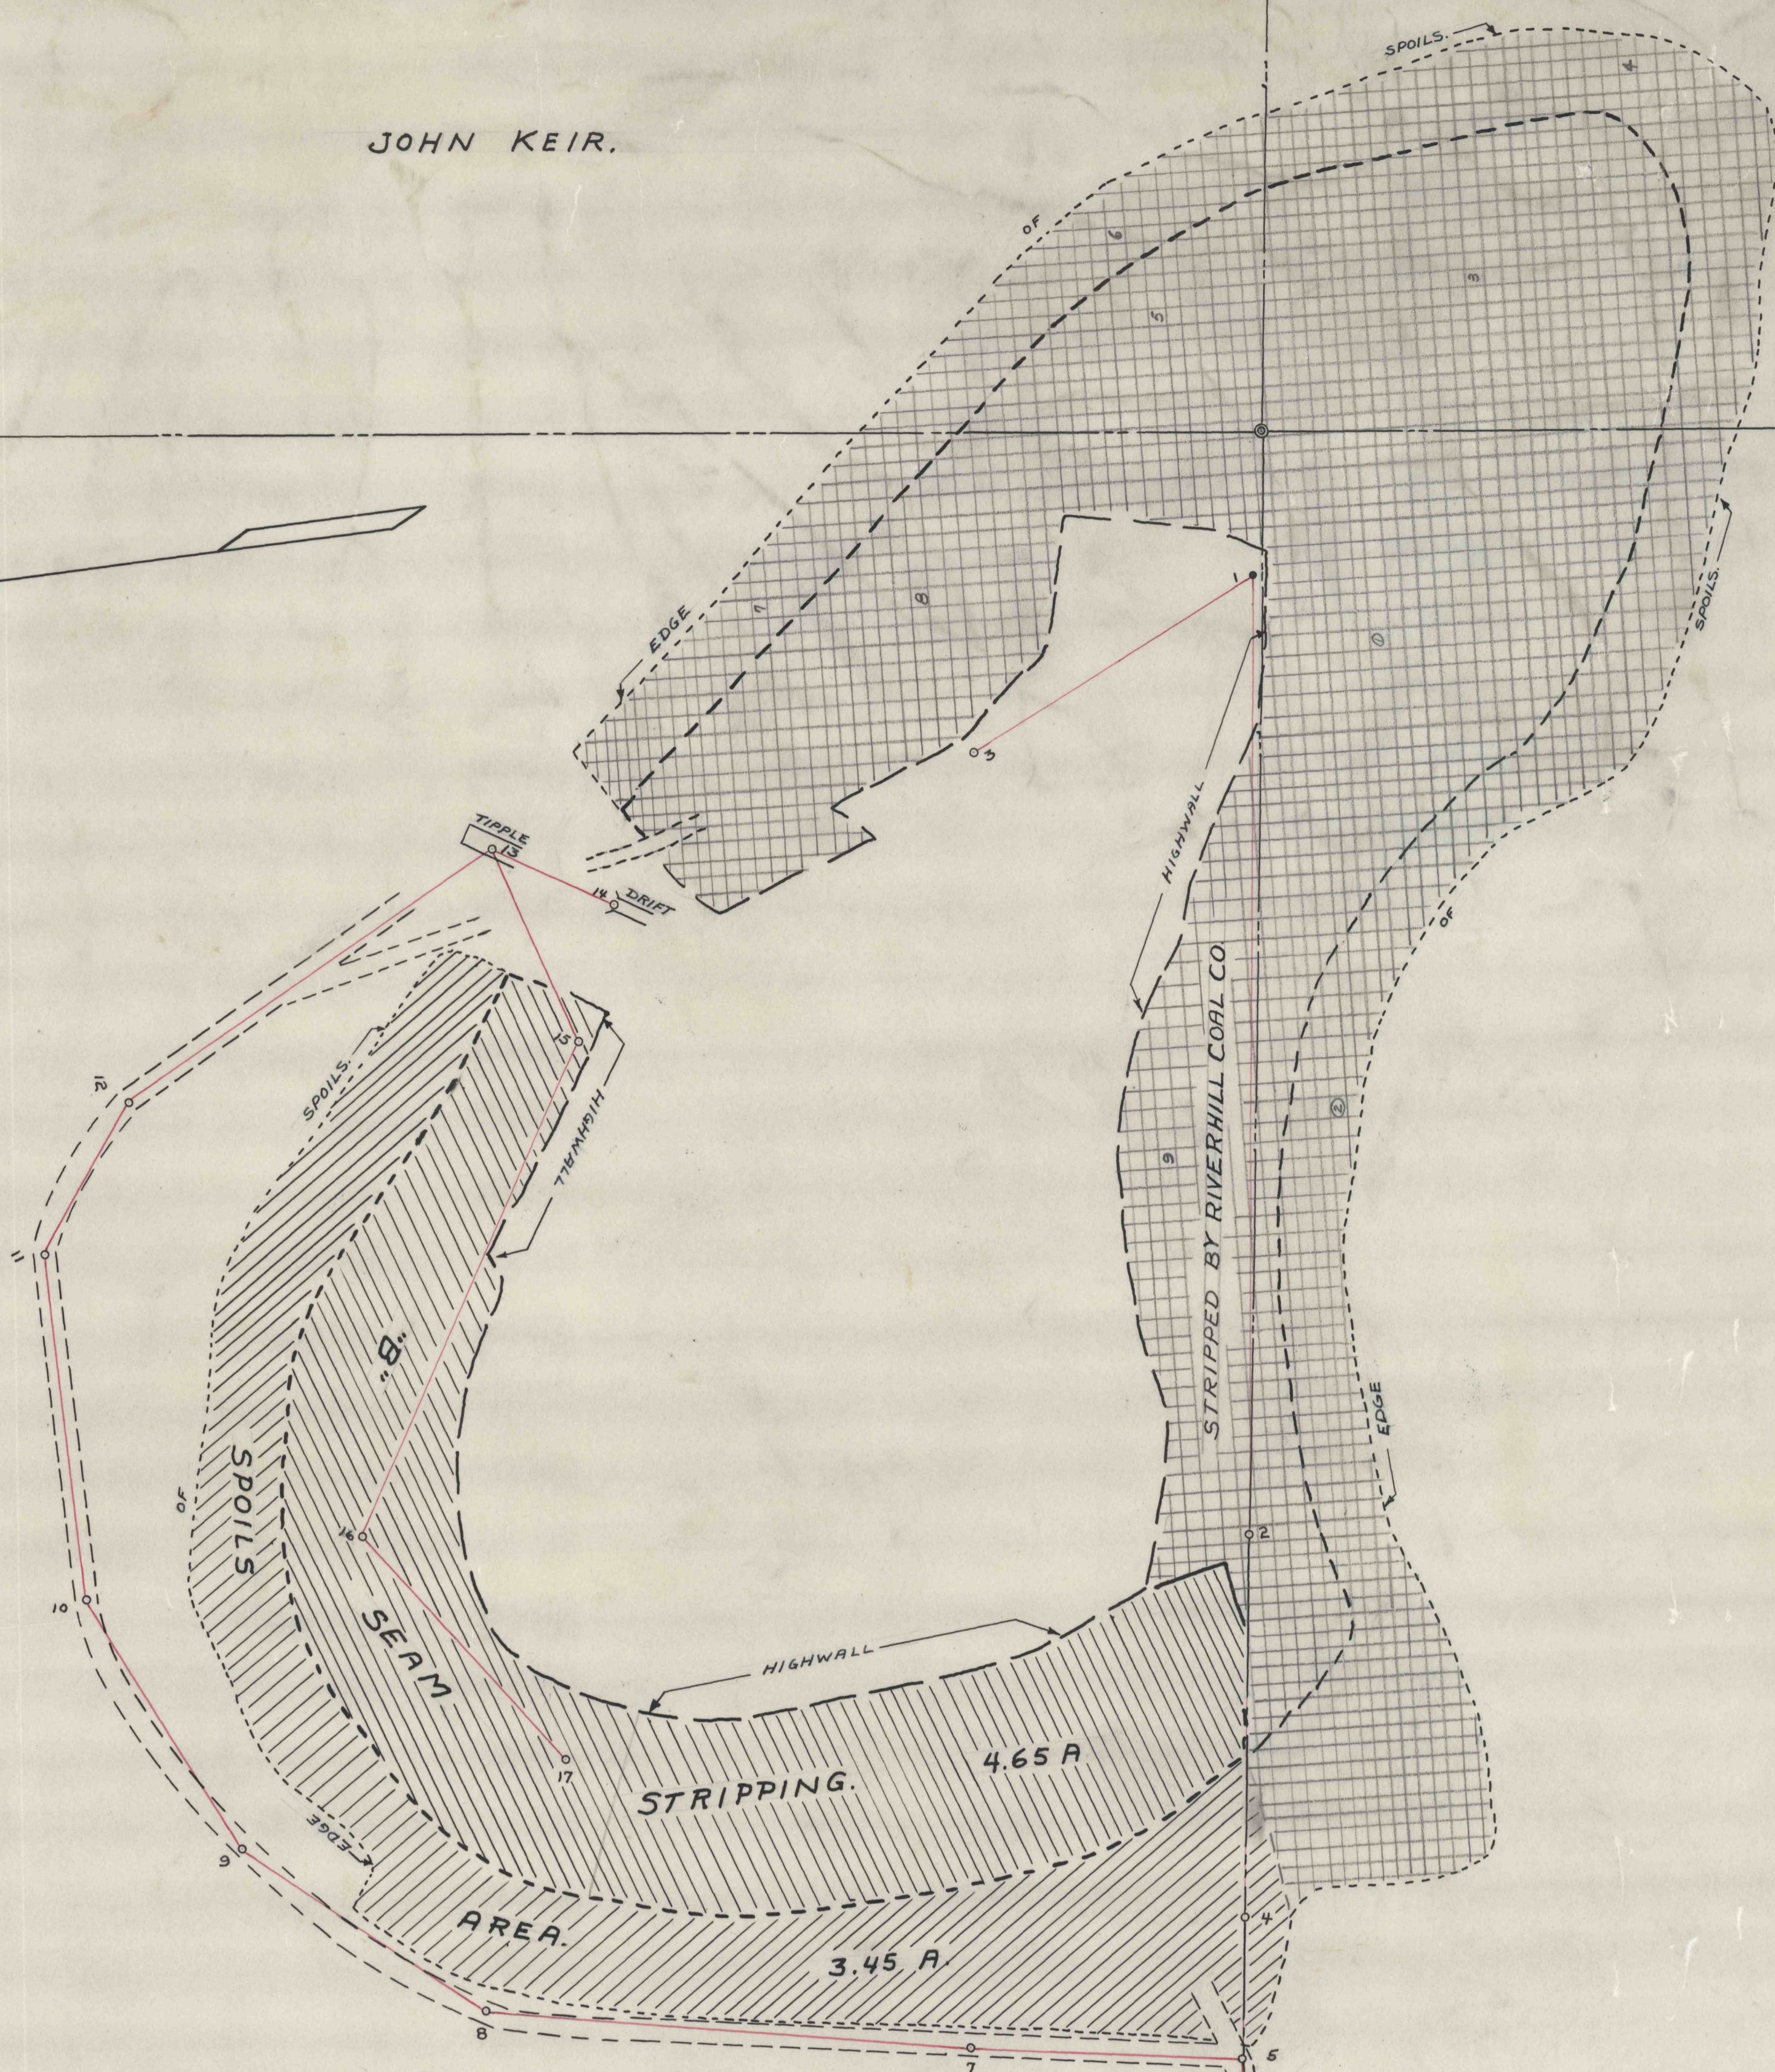


JOHN KEIR.

GILBERT HOOVER.

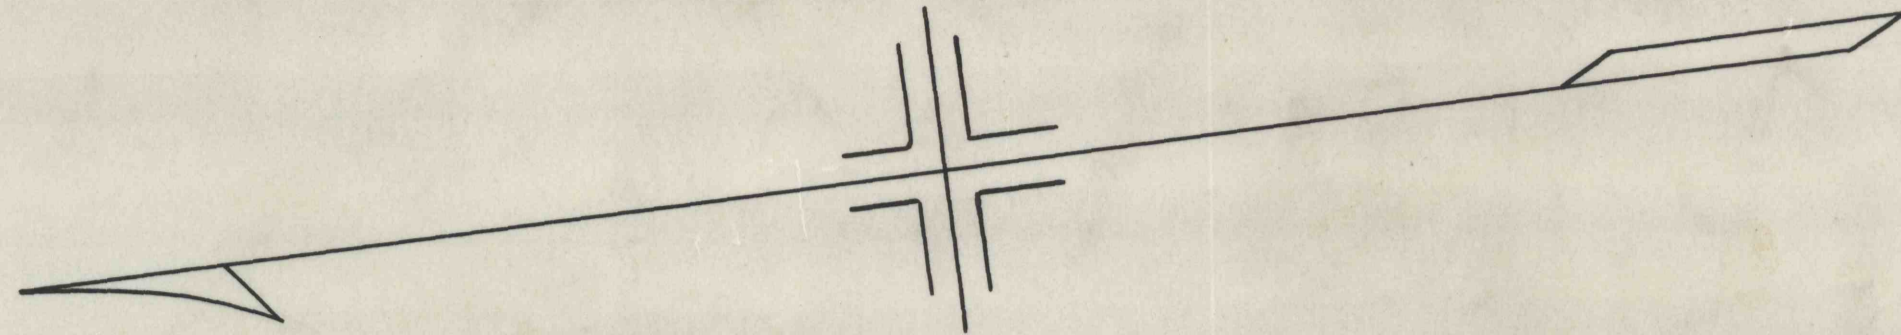

HARRY HARTER.

RIVERHILL COAL CO.

NOTE.
 KRISTIANSON & JOHNSON COAL CO.
 HARRY HARTER. 8.10
 TOTAL ACRES. 8.10

NOTE.
 RIVERHILL COAL MINING CO.
 JOHN KIER. 1.36
 HARRY HARTER. 4.11
 GILBERT HOOVER. 3.24
 RIVERHILL COAL CO. 5.76
 TOTAL ACRES. 14.47

TO ROLLING STONE STATE ROAD TO KYLERTOWN

M
 — MAP SHOWING "B" SEAM STRIPPING. —
 — OPERATED BY K. & J. COAL CO. —
 — COOPER TWP. CLEARFIELD CO. PENNA. —
 — SCALE. 1" = 100'. MAR. 10, 1952. —

C.D. 487

PCW

1634