
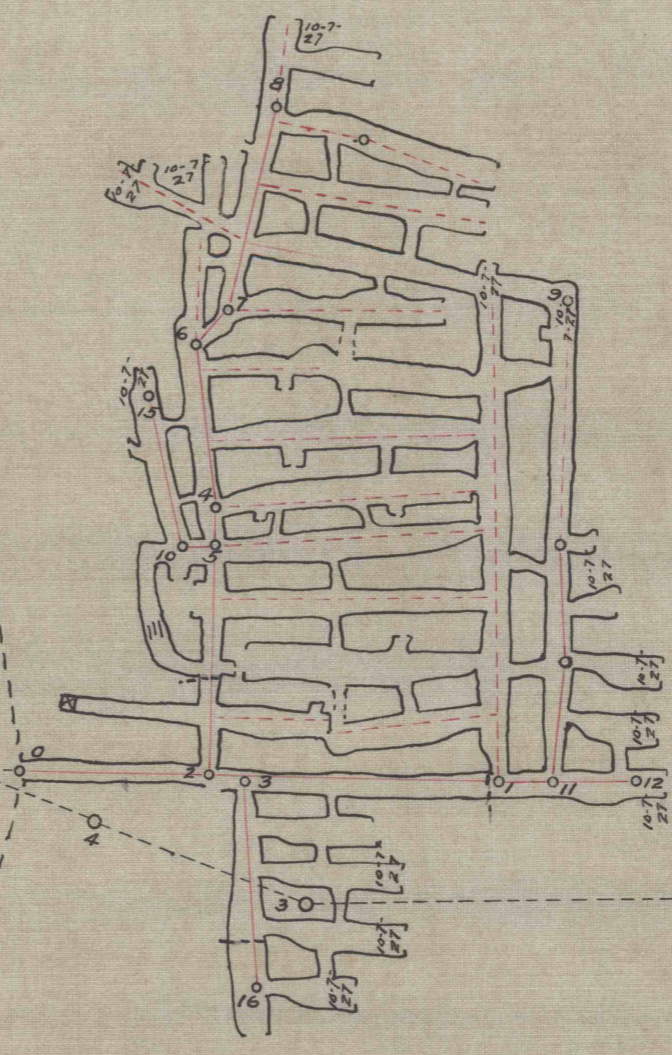


JEMIMA BAILEY LAWHEAD

S. D. BAILEY ESTATE  
J. ORVIS & BOYD F. WOOLRIDGE LEASE

ISAAC HANCOCK

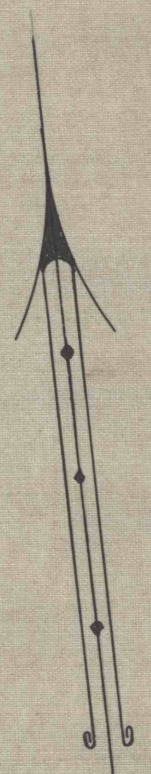

Field

Woods  
Z. A. F.  
WORKABLE EST.  
COAL - EST.

Z. BLOOM

H. B. POWELL TRUSTEE  
S. D. BAILEY ESTATE  
MAP OF COAL LANDS  
PIKE TWP, CLFD CO. PA.  
SCALE 1" = 100'  
CLEARFIELD, PA. OFFICE OF E. W. HESS  
NOVEMBER 3, 1927  
ENGINEER

1144-A