

HARRY GRAHAM.

JOSIAH W. SMITH, EST.

JEROME R. WILSON

FIELDS
WOODS

WOODS

FIELDS

WOODS

OUT CROP


WORKED OUT

FRANCIS JOHNSON Y.T.

TRAM ROAD

Air Shaft

EDWIN JURY

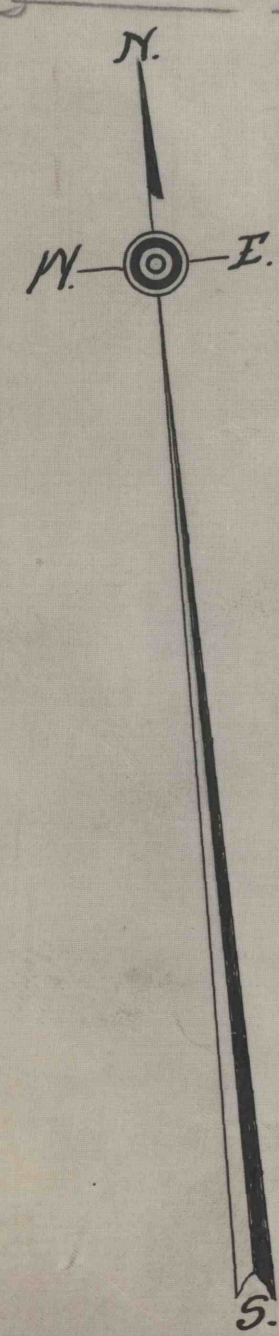

A. B. LANDSBERRY

MAP OF
COAL LANDS AND MINES IN
BRADFORD TOWNSHIP, CLEARFIELD CO. PENNA.

SCALE 1"=100'

CLEARFIELD, PA. AUG. 4-1913

OFFICE OF E. W. HESS, ENGINEER.

SURVEY EXTENDED
AUGUST-16-18-1915.

JOHN H. STEWART EST.

Cometary