


1741

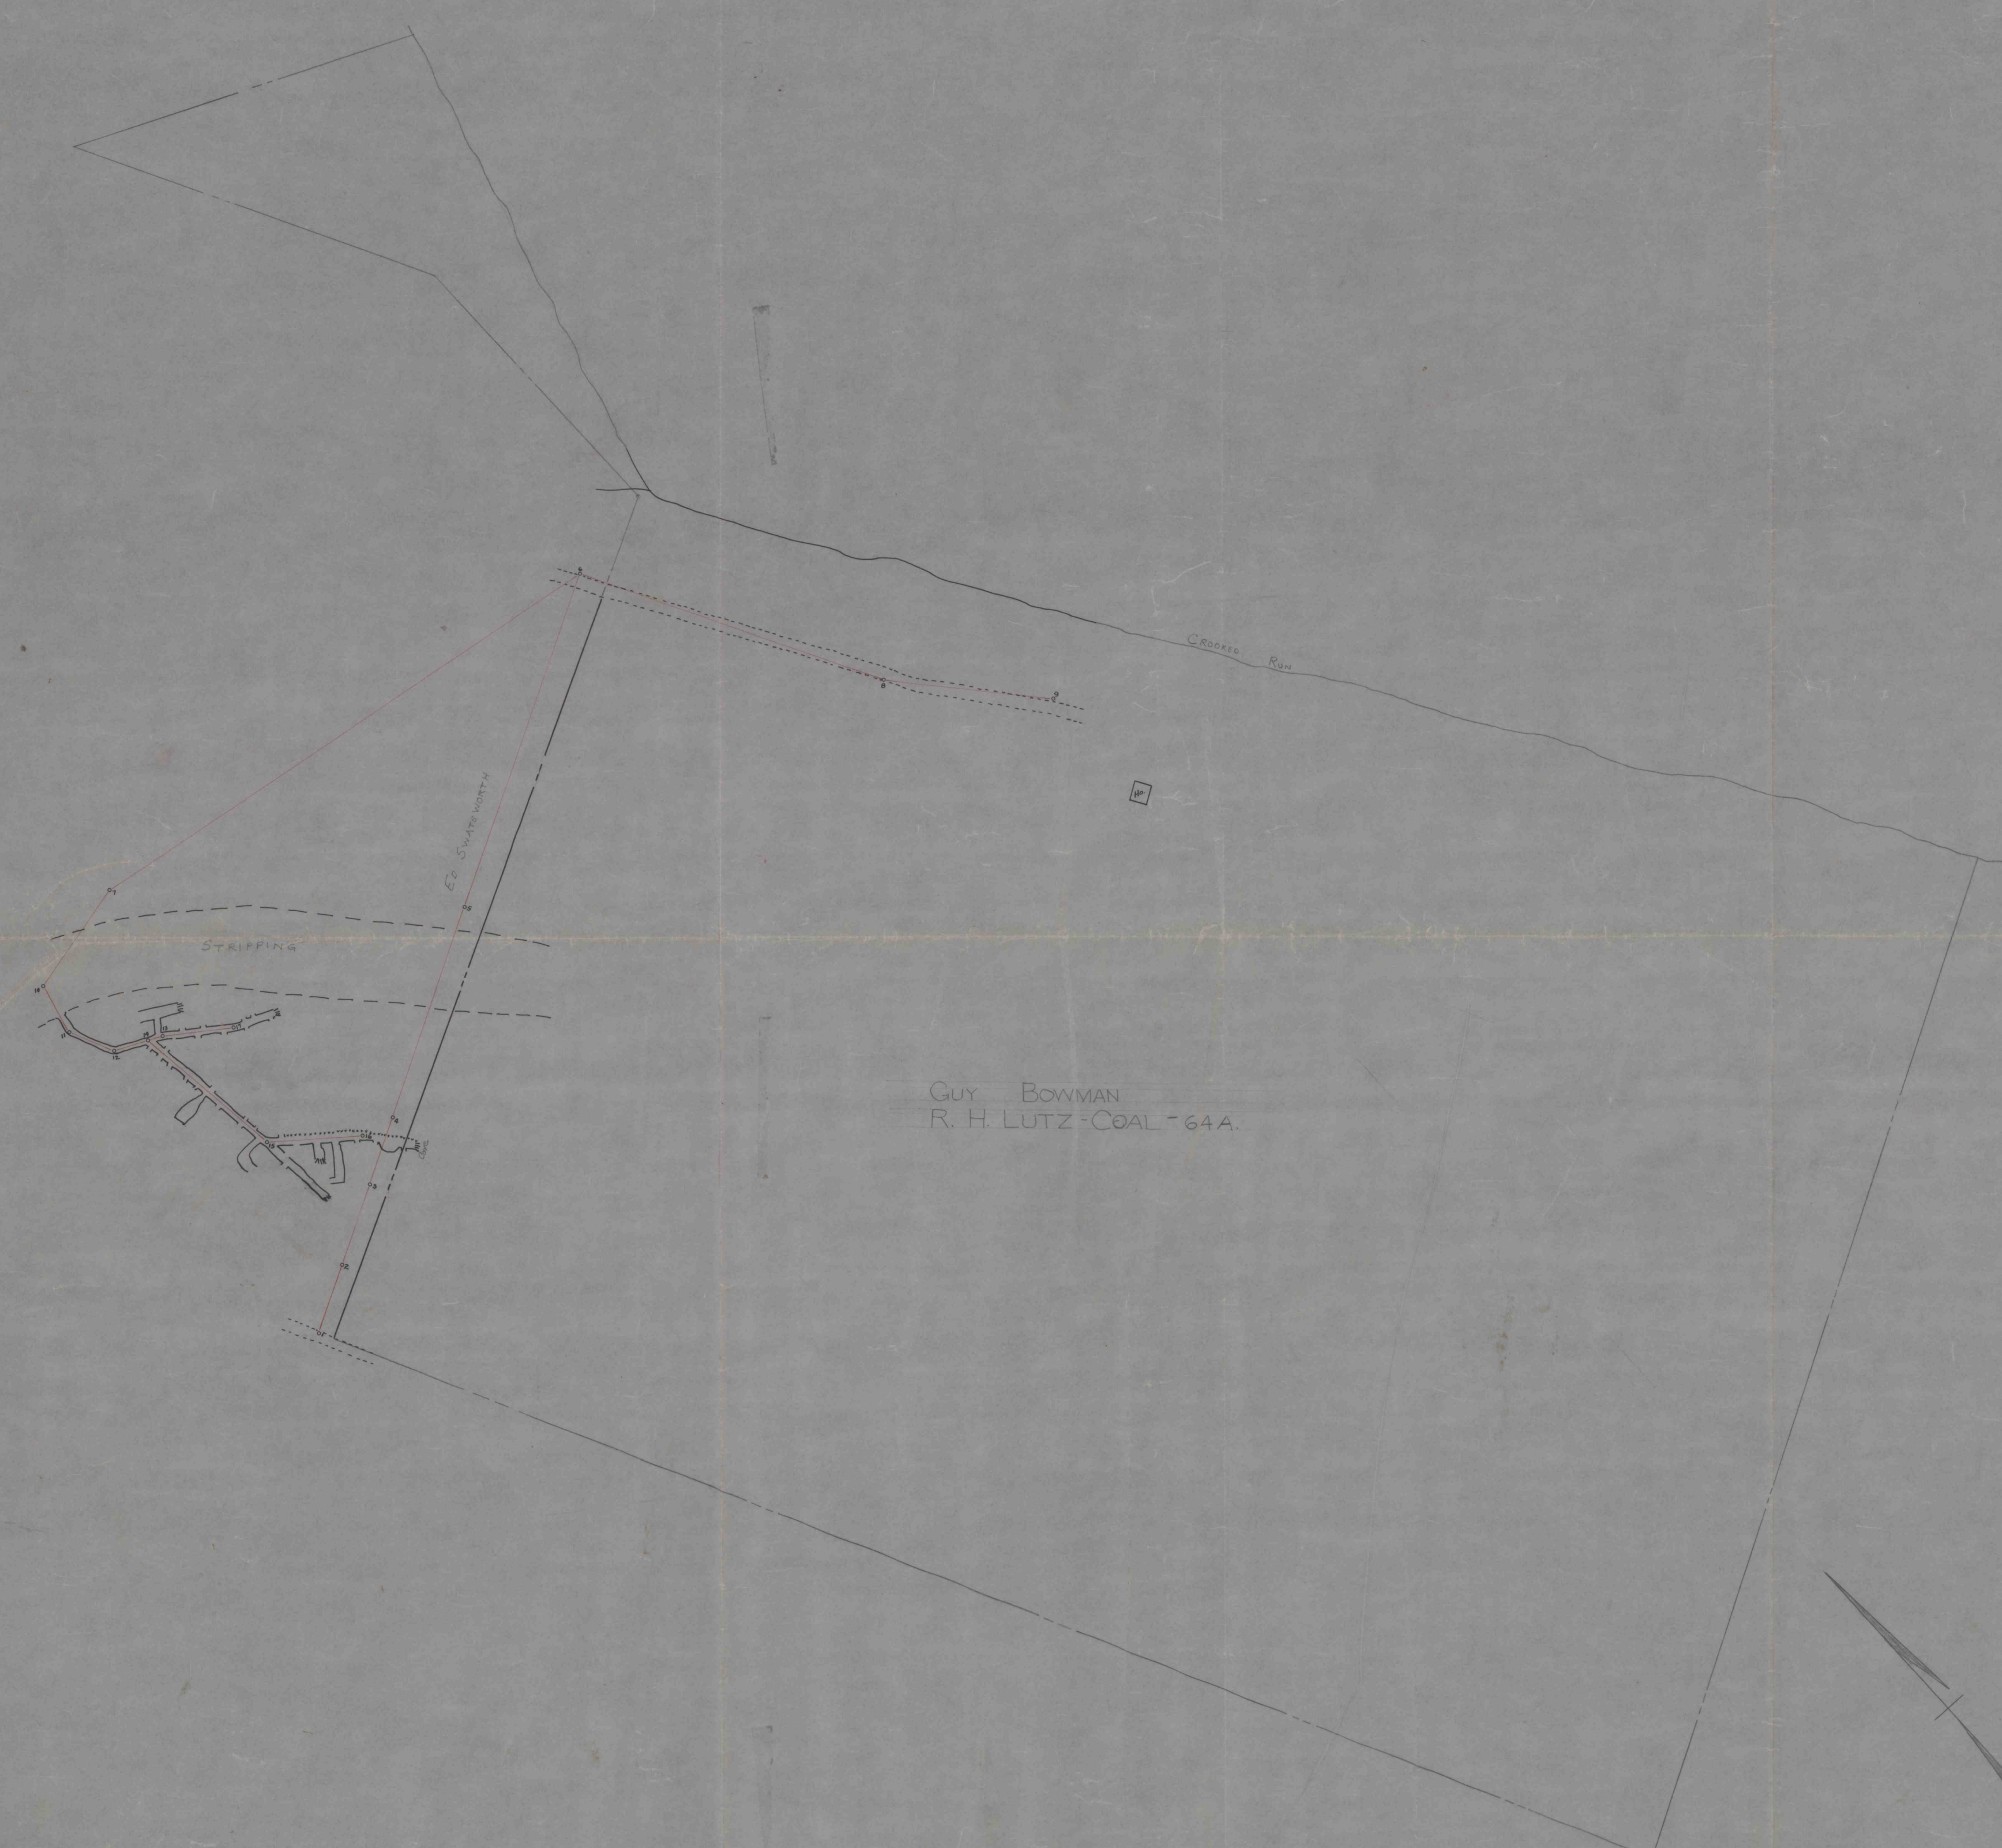

GUY BOWMAN
 R. H. LUTZ - COAL - 64A.

D
 R. H. LUTZ
 COAL PROPERTY

SCALE - 1" = 100'

YOST, BROMFIELD & HESS, ENGRS.
 CLEARFIELD, PA.

1183-A

1741