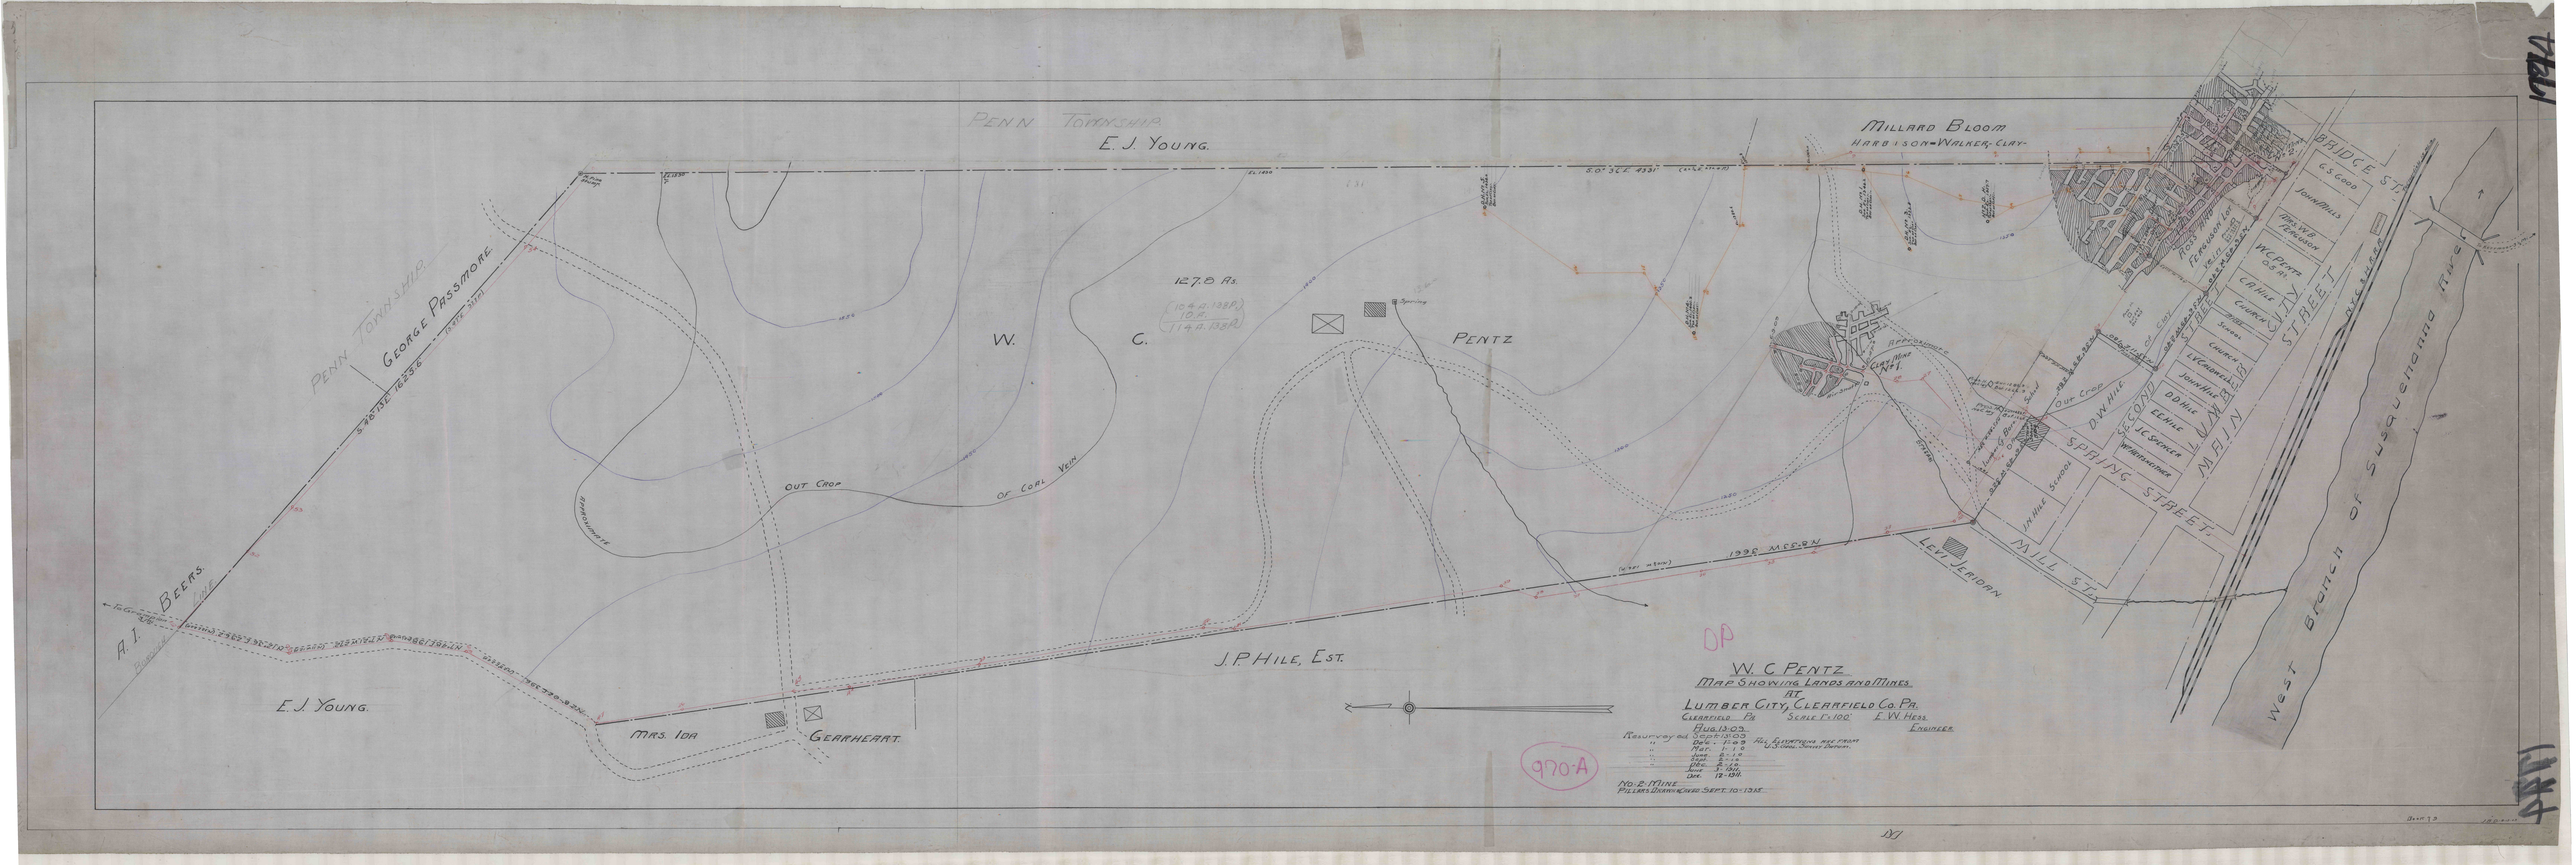

W. C. PENTZ
MAP SHOWING LANDS AND MINES
AT
LUMBER CITY, CLEARFIELD CO. PA.
CLEARFIELD PA. SCALE 1" = 100' E. W. HESS ENGINEER

RESURVEY ON PLAT 13-03.
" " PLAT 1-08
" " PLAT 2-12
" " SEPT. 2-14
" " DEC. 7-15
" " OCT. 12-1911

FILL ELEVATIONS ARE FROM U.S. COAL SURVEY BUREAU.

NO. 2 MINE
FILLERS WORK CARD SEPT. 10-1915

DY