

DW
PLAN SHOWING
WORKINGS OF
THE BEACON COAL CO.
IN THE UPPER KITTANNING COAL
UNDER LANDS OF
SARAH M. TROXELL

IN
REED TOWNSHIP
CAMBRIA CO.,
PENNA.

SCALE 1 IN. = 100 FT. AUG. 6, 1927

H. F. VANVALZAH
MINING ENGR.
CLEARFIELD,
PA.

REVISED 7-28-42 by the OFFICES OF EM. & O. HESS, ENGRS.
CLEARFIELD, PENNA.

NB Y252 P149

1170


BEACON COAL CO.
IN FEE

SARA M. TROXELL 3/4 INT.
BEACON COAL CO. 1/4 INT.
444.21 A. SURF. & COAL

SARAH TROXELL
SAM'L TROXELL

SAM'L TROXELL
SURFACE ENCROACHMENT
3.28 A.

FRUGALITY COAL & COKE CO.

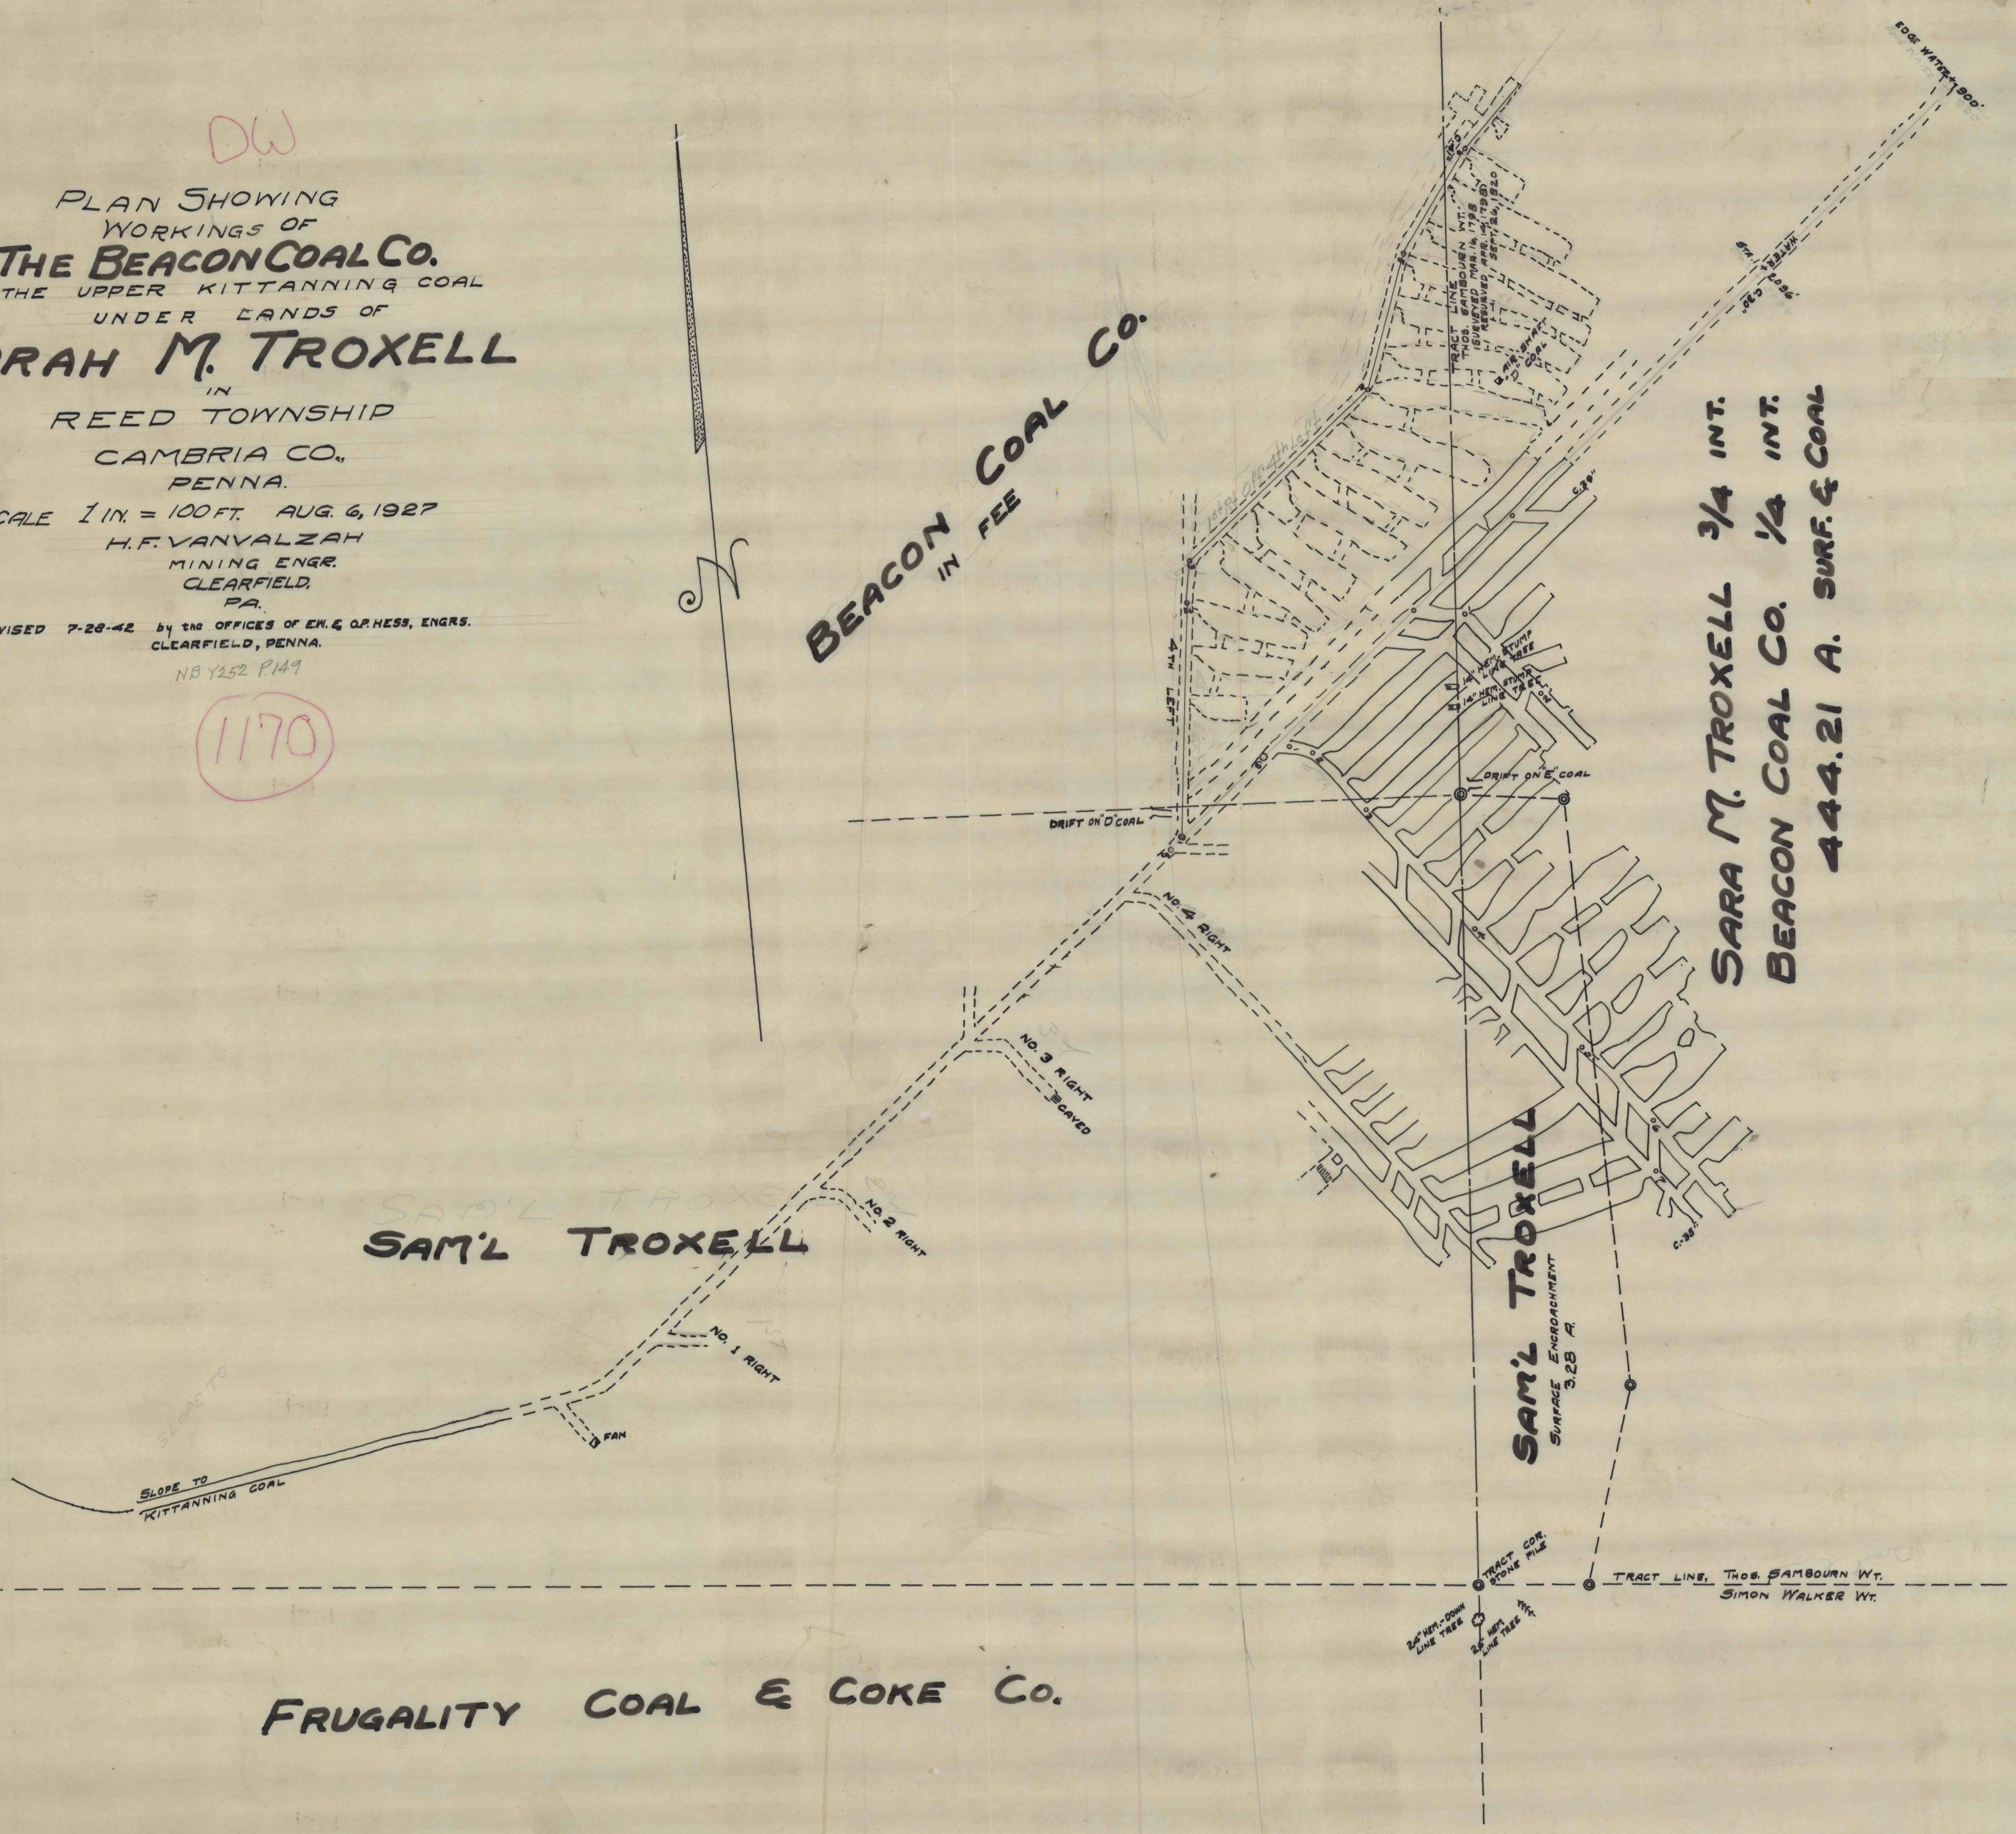

0511
PTT1

0511

0511
6779

0511