

JOHN R. DUNLAP.

CEMETERY.

GRANT CATHCART.

TODD BROS.

H. FAGAN ROWLES.




DP
TODD BROTHERS
 PHILIPSBURG, PA.
 MAP SHOWING RELATION OF WORKINGS
 OF
"OLANTA MINE"
 TO WEST PROPERTY LINE
 SCALE: 1" = 100'

CLEARFIELD, PA.
 SEPT. 27 - 1919.

63
 SURVEYED
 AUGUST - 19 - 1919.

OFFICE E.W. HESS.
 ENGINEER.

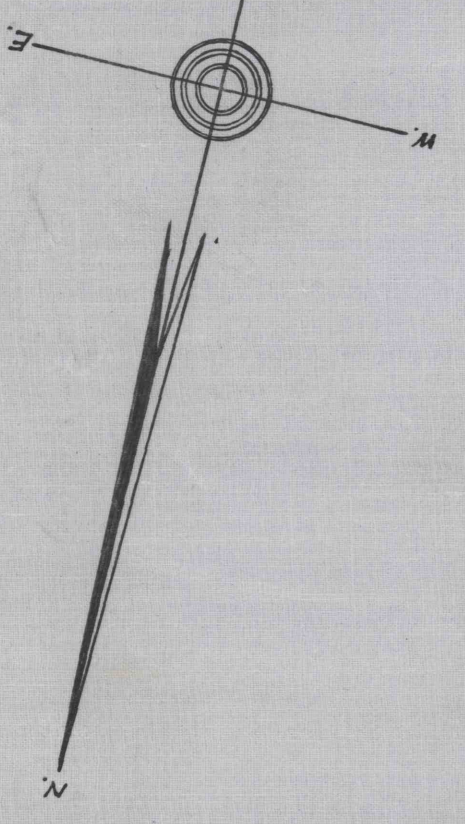

Hood N° 2
 MINE.

KELLY BROS
 MINES.

N° 1.

081

180