

M P  
TWP UNK  
**MAP OF**  
**WILLIAMS GROVE BRICK CO'S**


**MINE AT WILLIAMS GROVE**  
CLEARFIELD CO, PA

SCALE " 1"=100' **1905.** Geo. H. Ayres, Eng'r

Surveyed to Dec-21 1911  
" " Apr-12 1912  
" " Oct-8 1912

**MAP**  
**COPIED AND EXTENDED**  
**JANUARY 17,**  
**1919.**

**CLEARFIELD, PA. OFFICE OF E. W. HESS,**  
**JAN. 14-15, 1919. ENGINEER.**

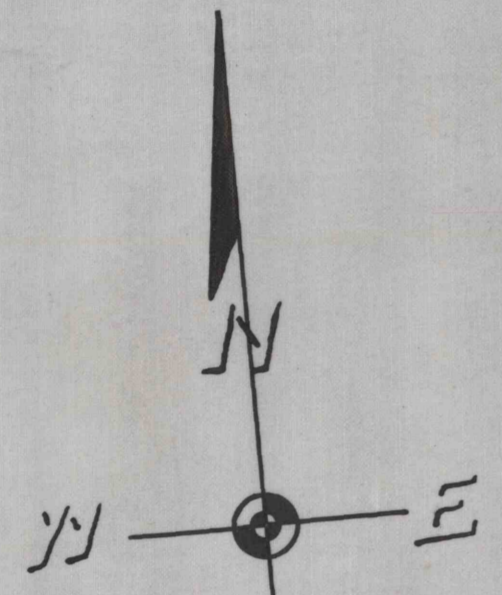

PEARCE HEARS

Williams Grove Brick Co.  
50 Acre Lease.

PATRICK HURLEY

W. DIXON

HENRY SMEAL HEARS

