


JAMES FURST

ESTHER R. BRIDGENS

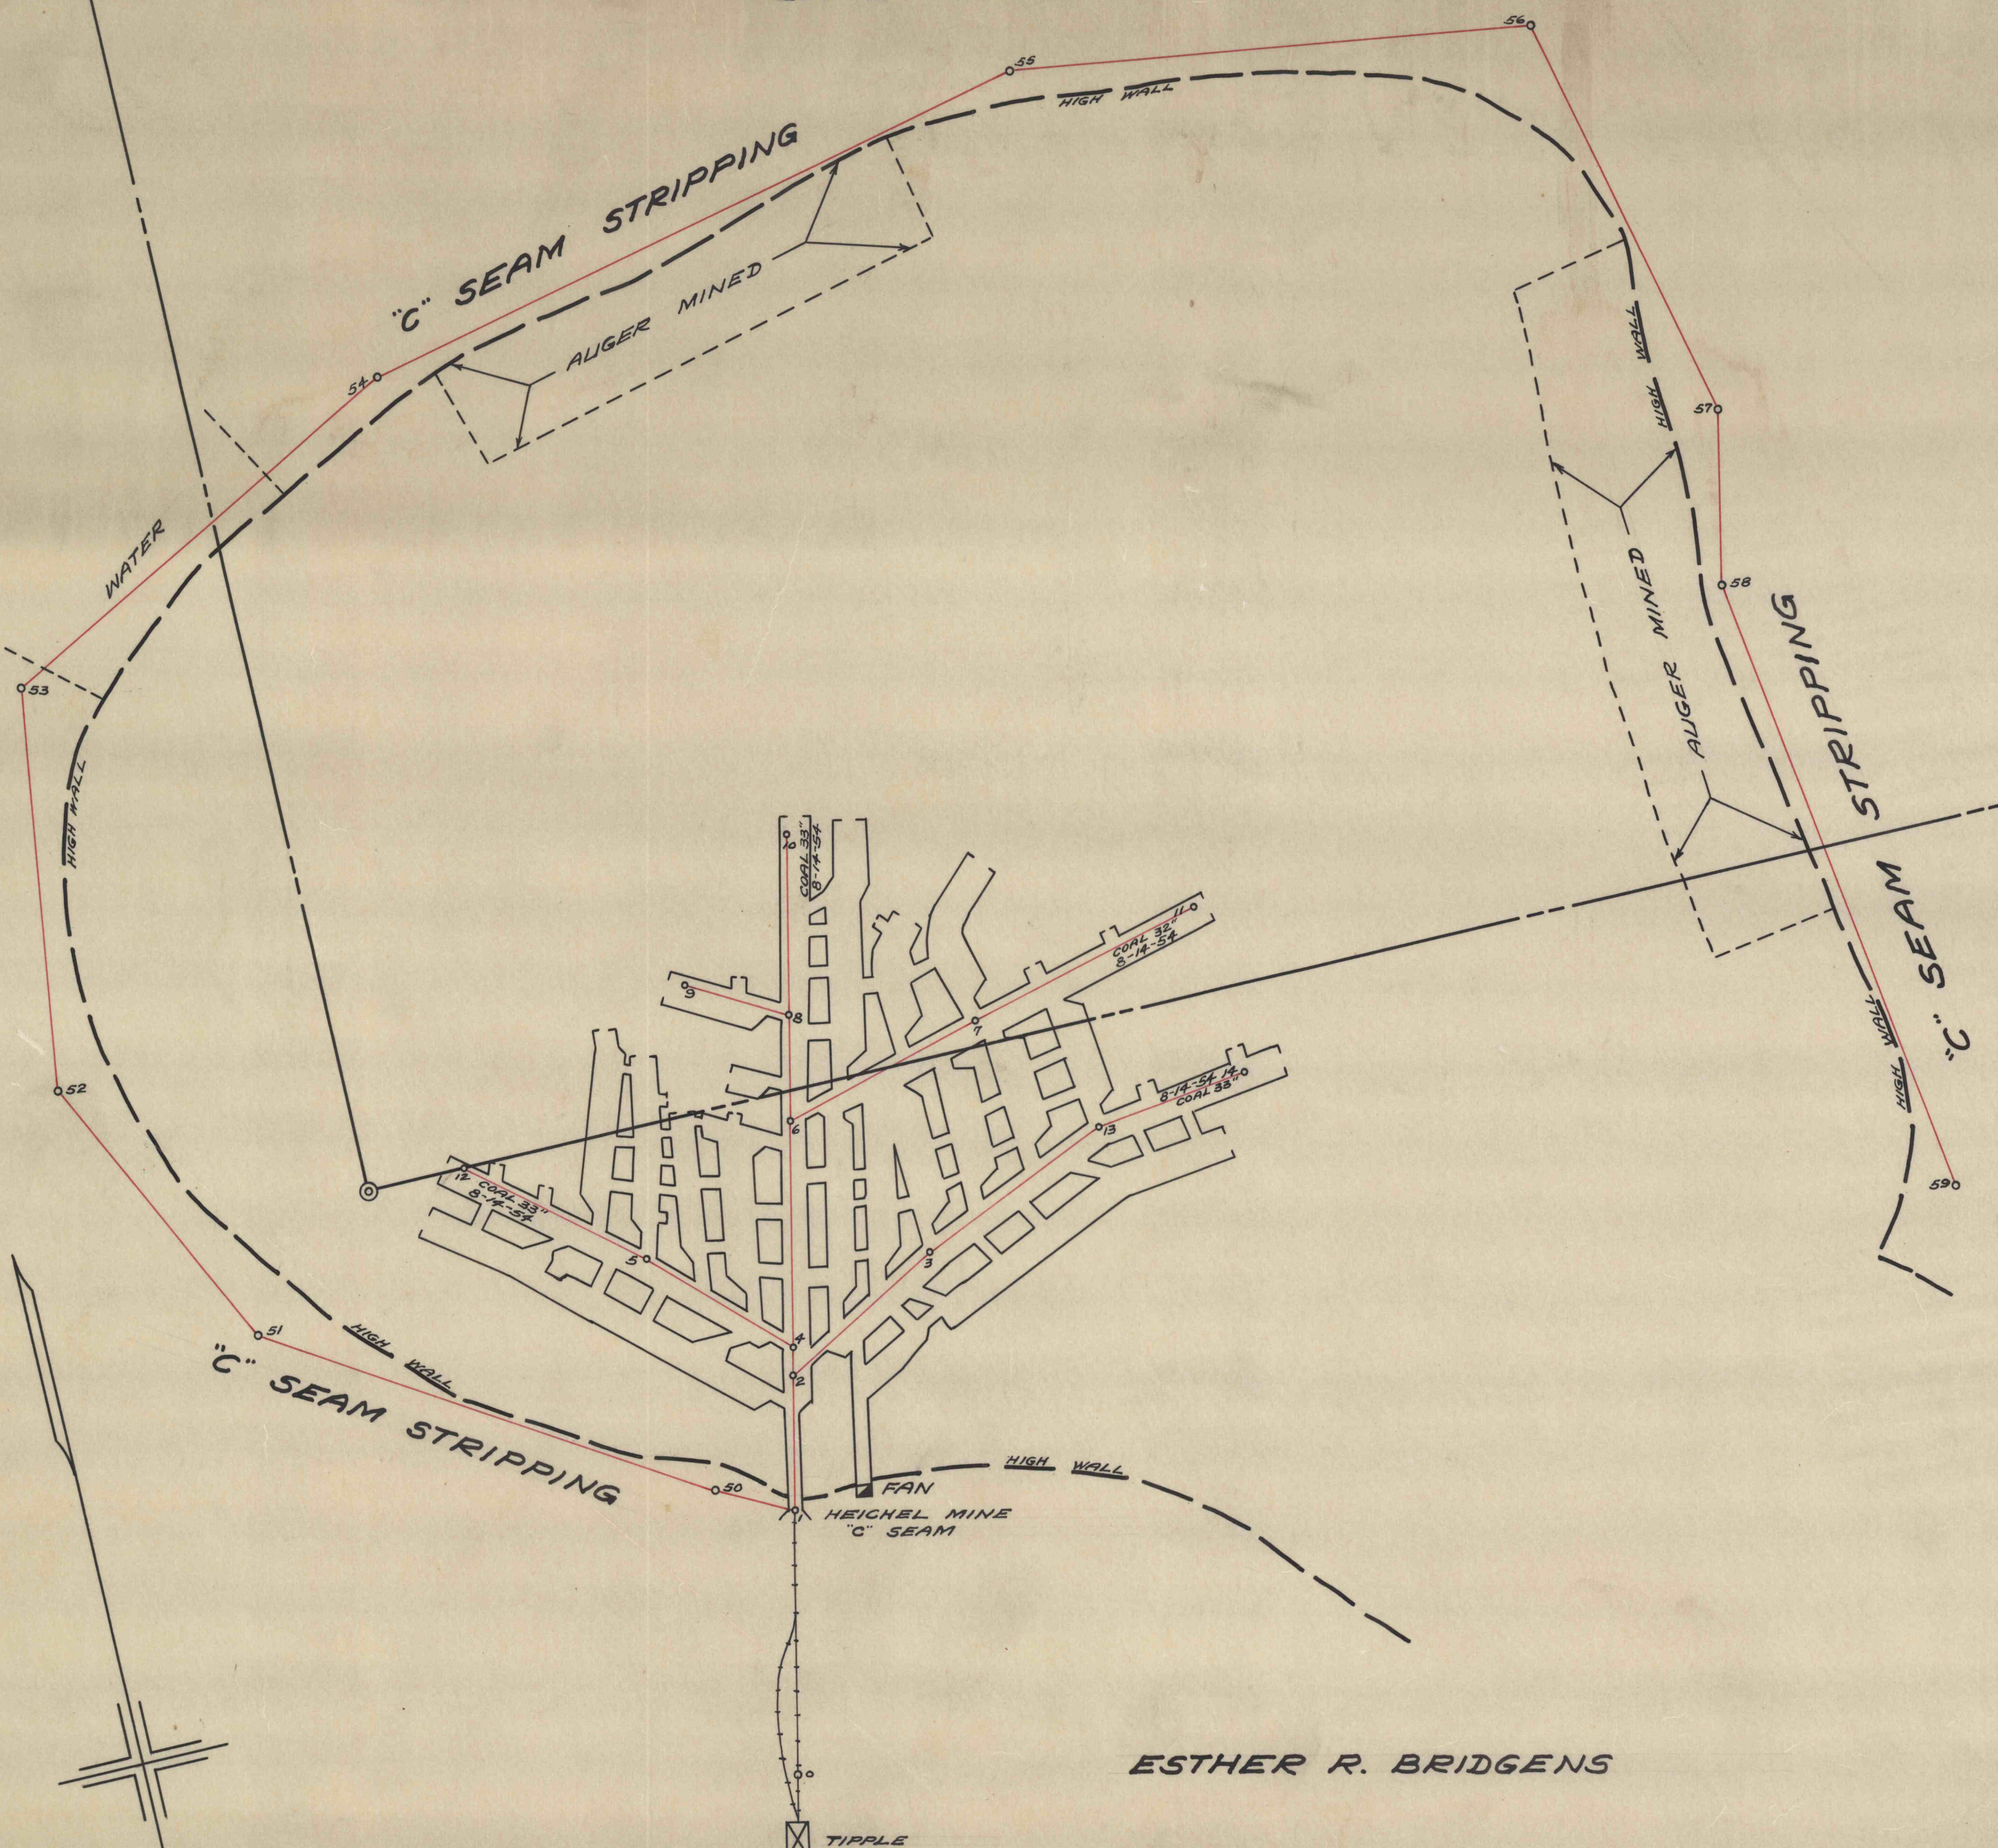

ESTHER R. BRIDGENS

D

— MAP OF HEICHEL MINE —
 — OPERATED BY BURTON & JOSEPH PETERS —
 — WEST KEATING TWP. CLINTON CO. PENNA. —
 — SCALE 1 1/2" = 100' AUG. 19, 1954 —

C.D. 490

Ed 81

1863