


5181

1872

DANIEL MOORE TRACT

CHARLES DEVROSE TRACT

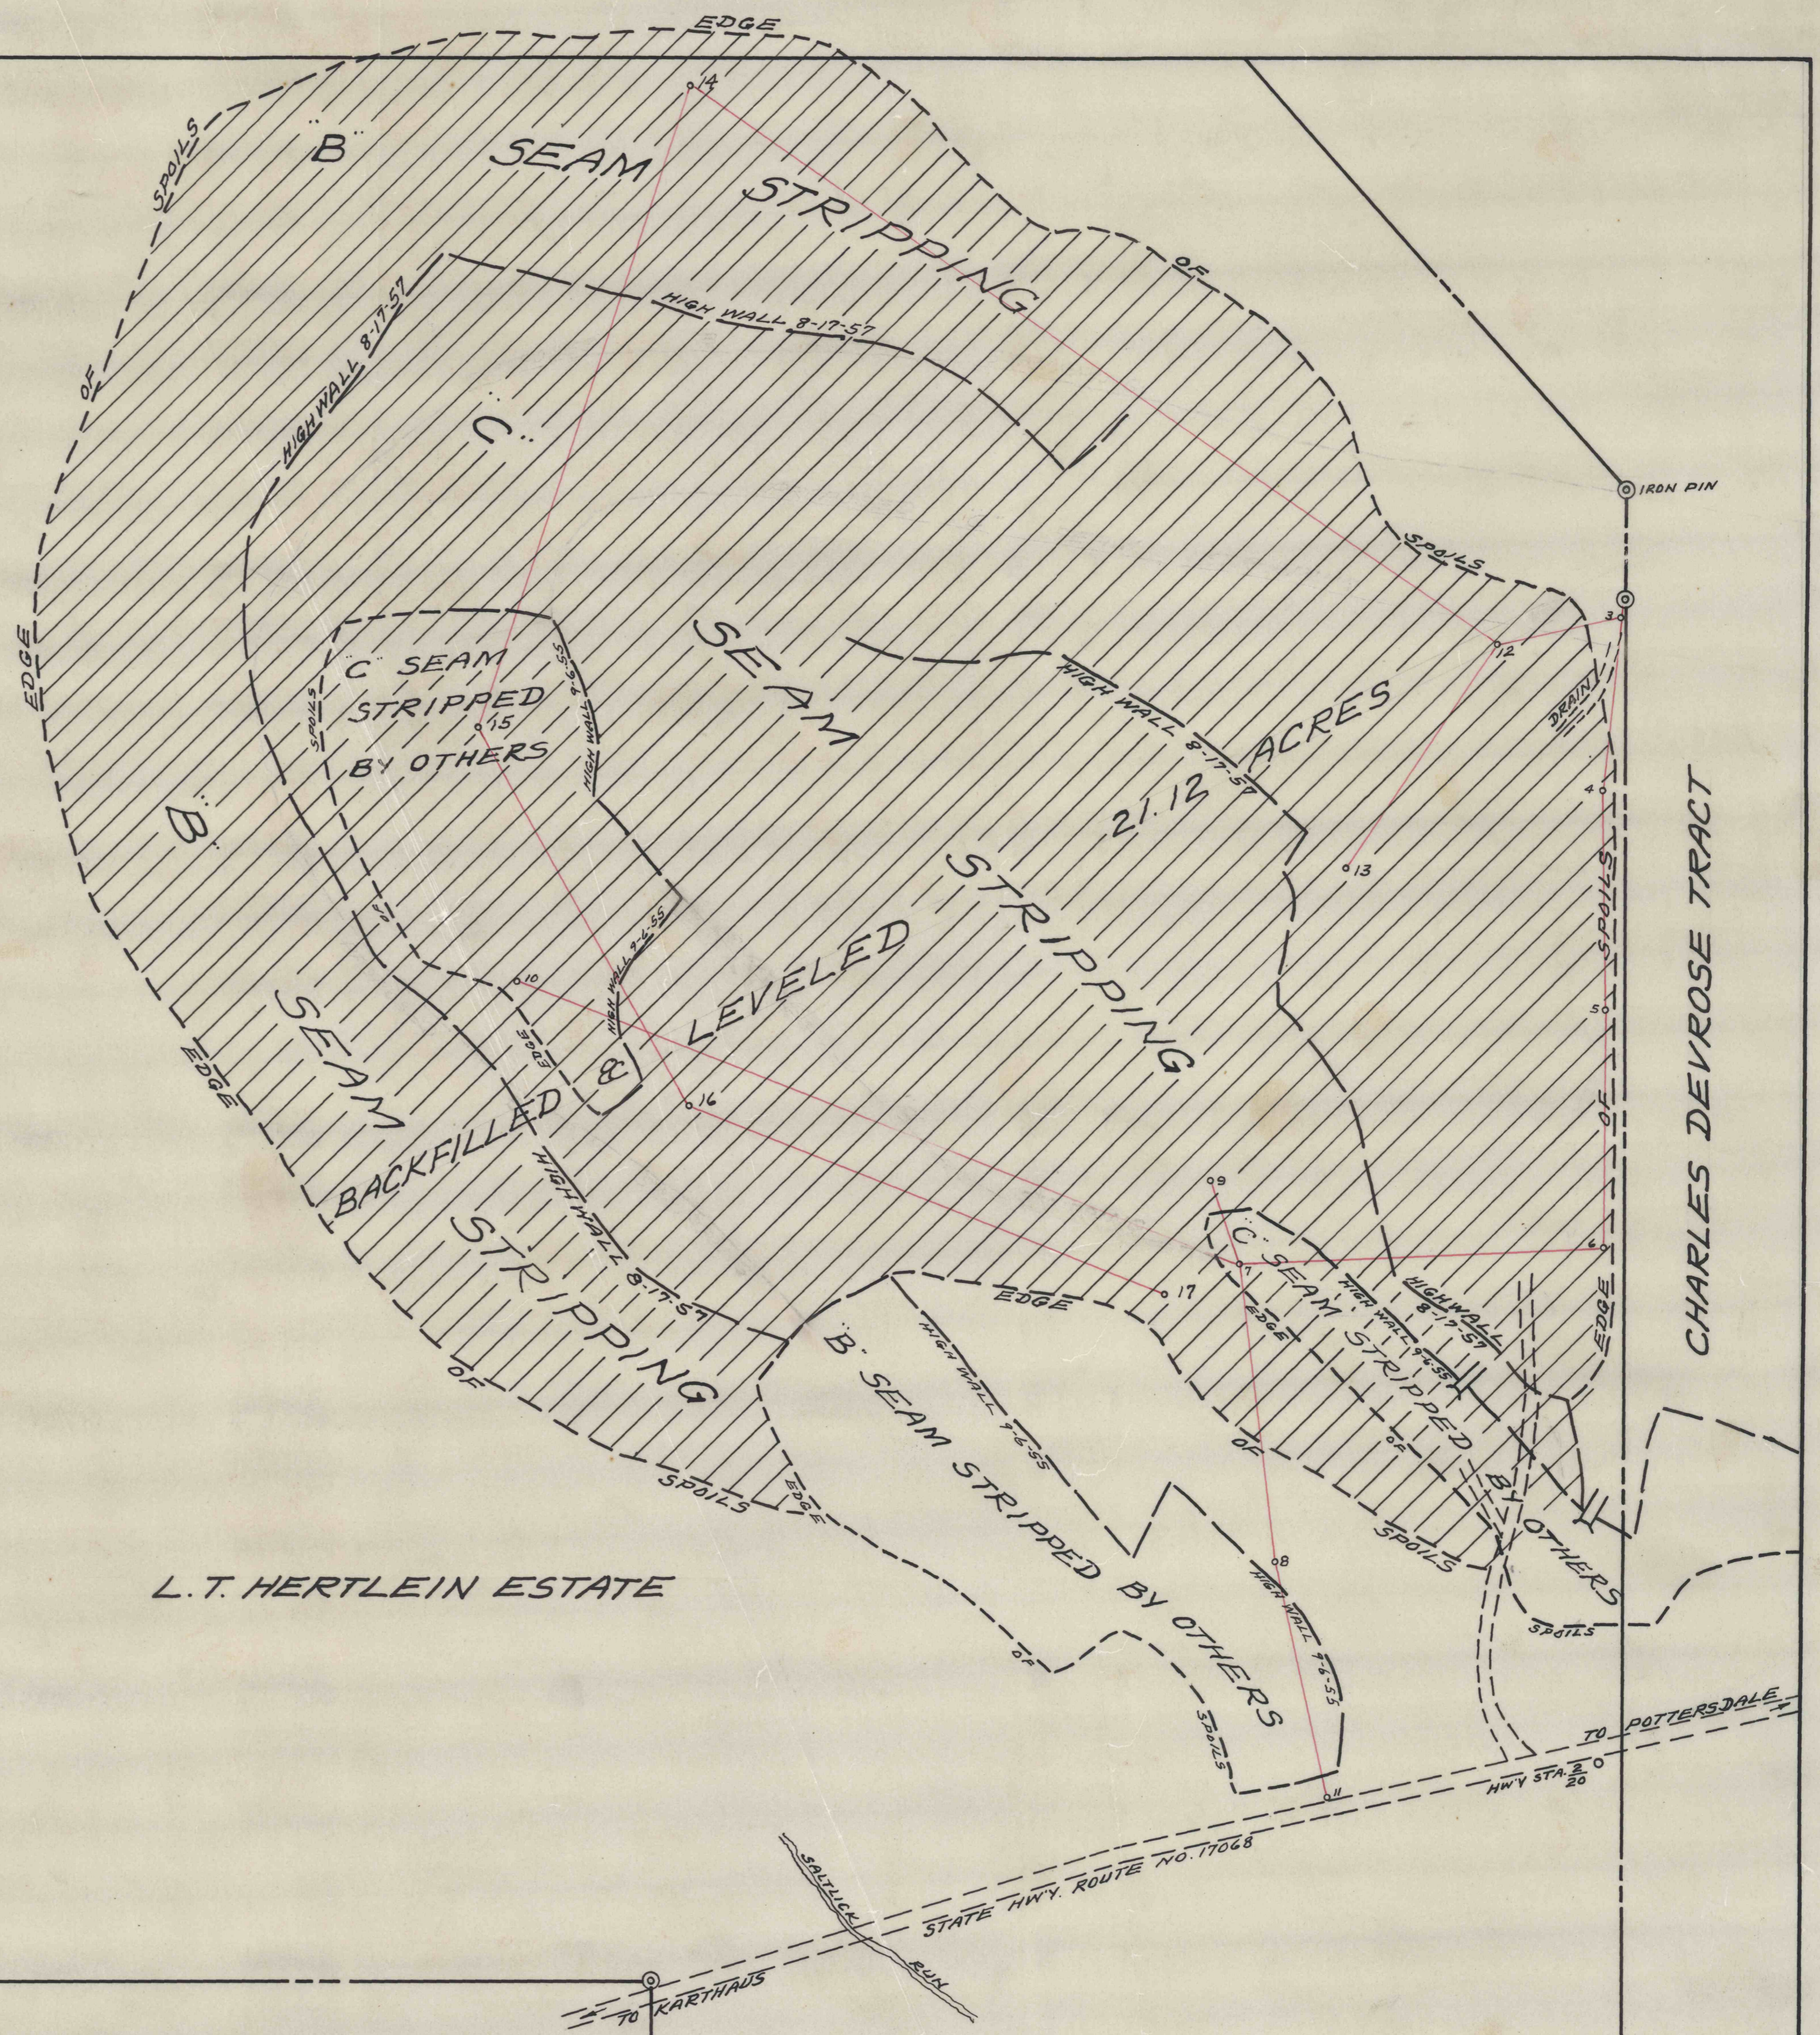

L.T. HERTLEIN ESTATE

HENRY YOTHERS TRACT

M

— MAP SHOWING "B" & "C" SEAMS STRIPPINGS —
 — OPERATED BY JOHN E. TEETER COAL CO. —
 — KARTHANS TWP. CLEARFIELD COUNTY PA. —
 — SCALE 1" = 100' — SEPT. 29/1955 —
 — BERNARD LUCAS ASSOC. —

C.D. 465