


HARBISON-WALKER REFRACTORIES CO.

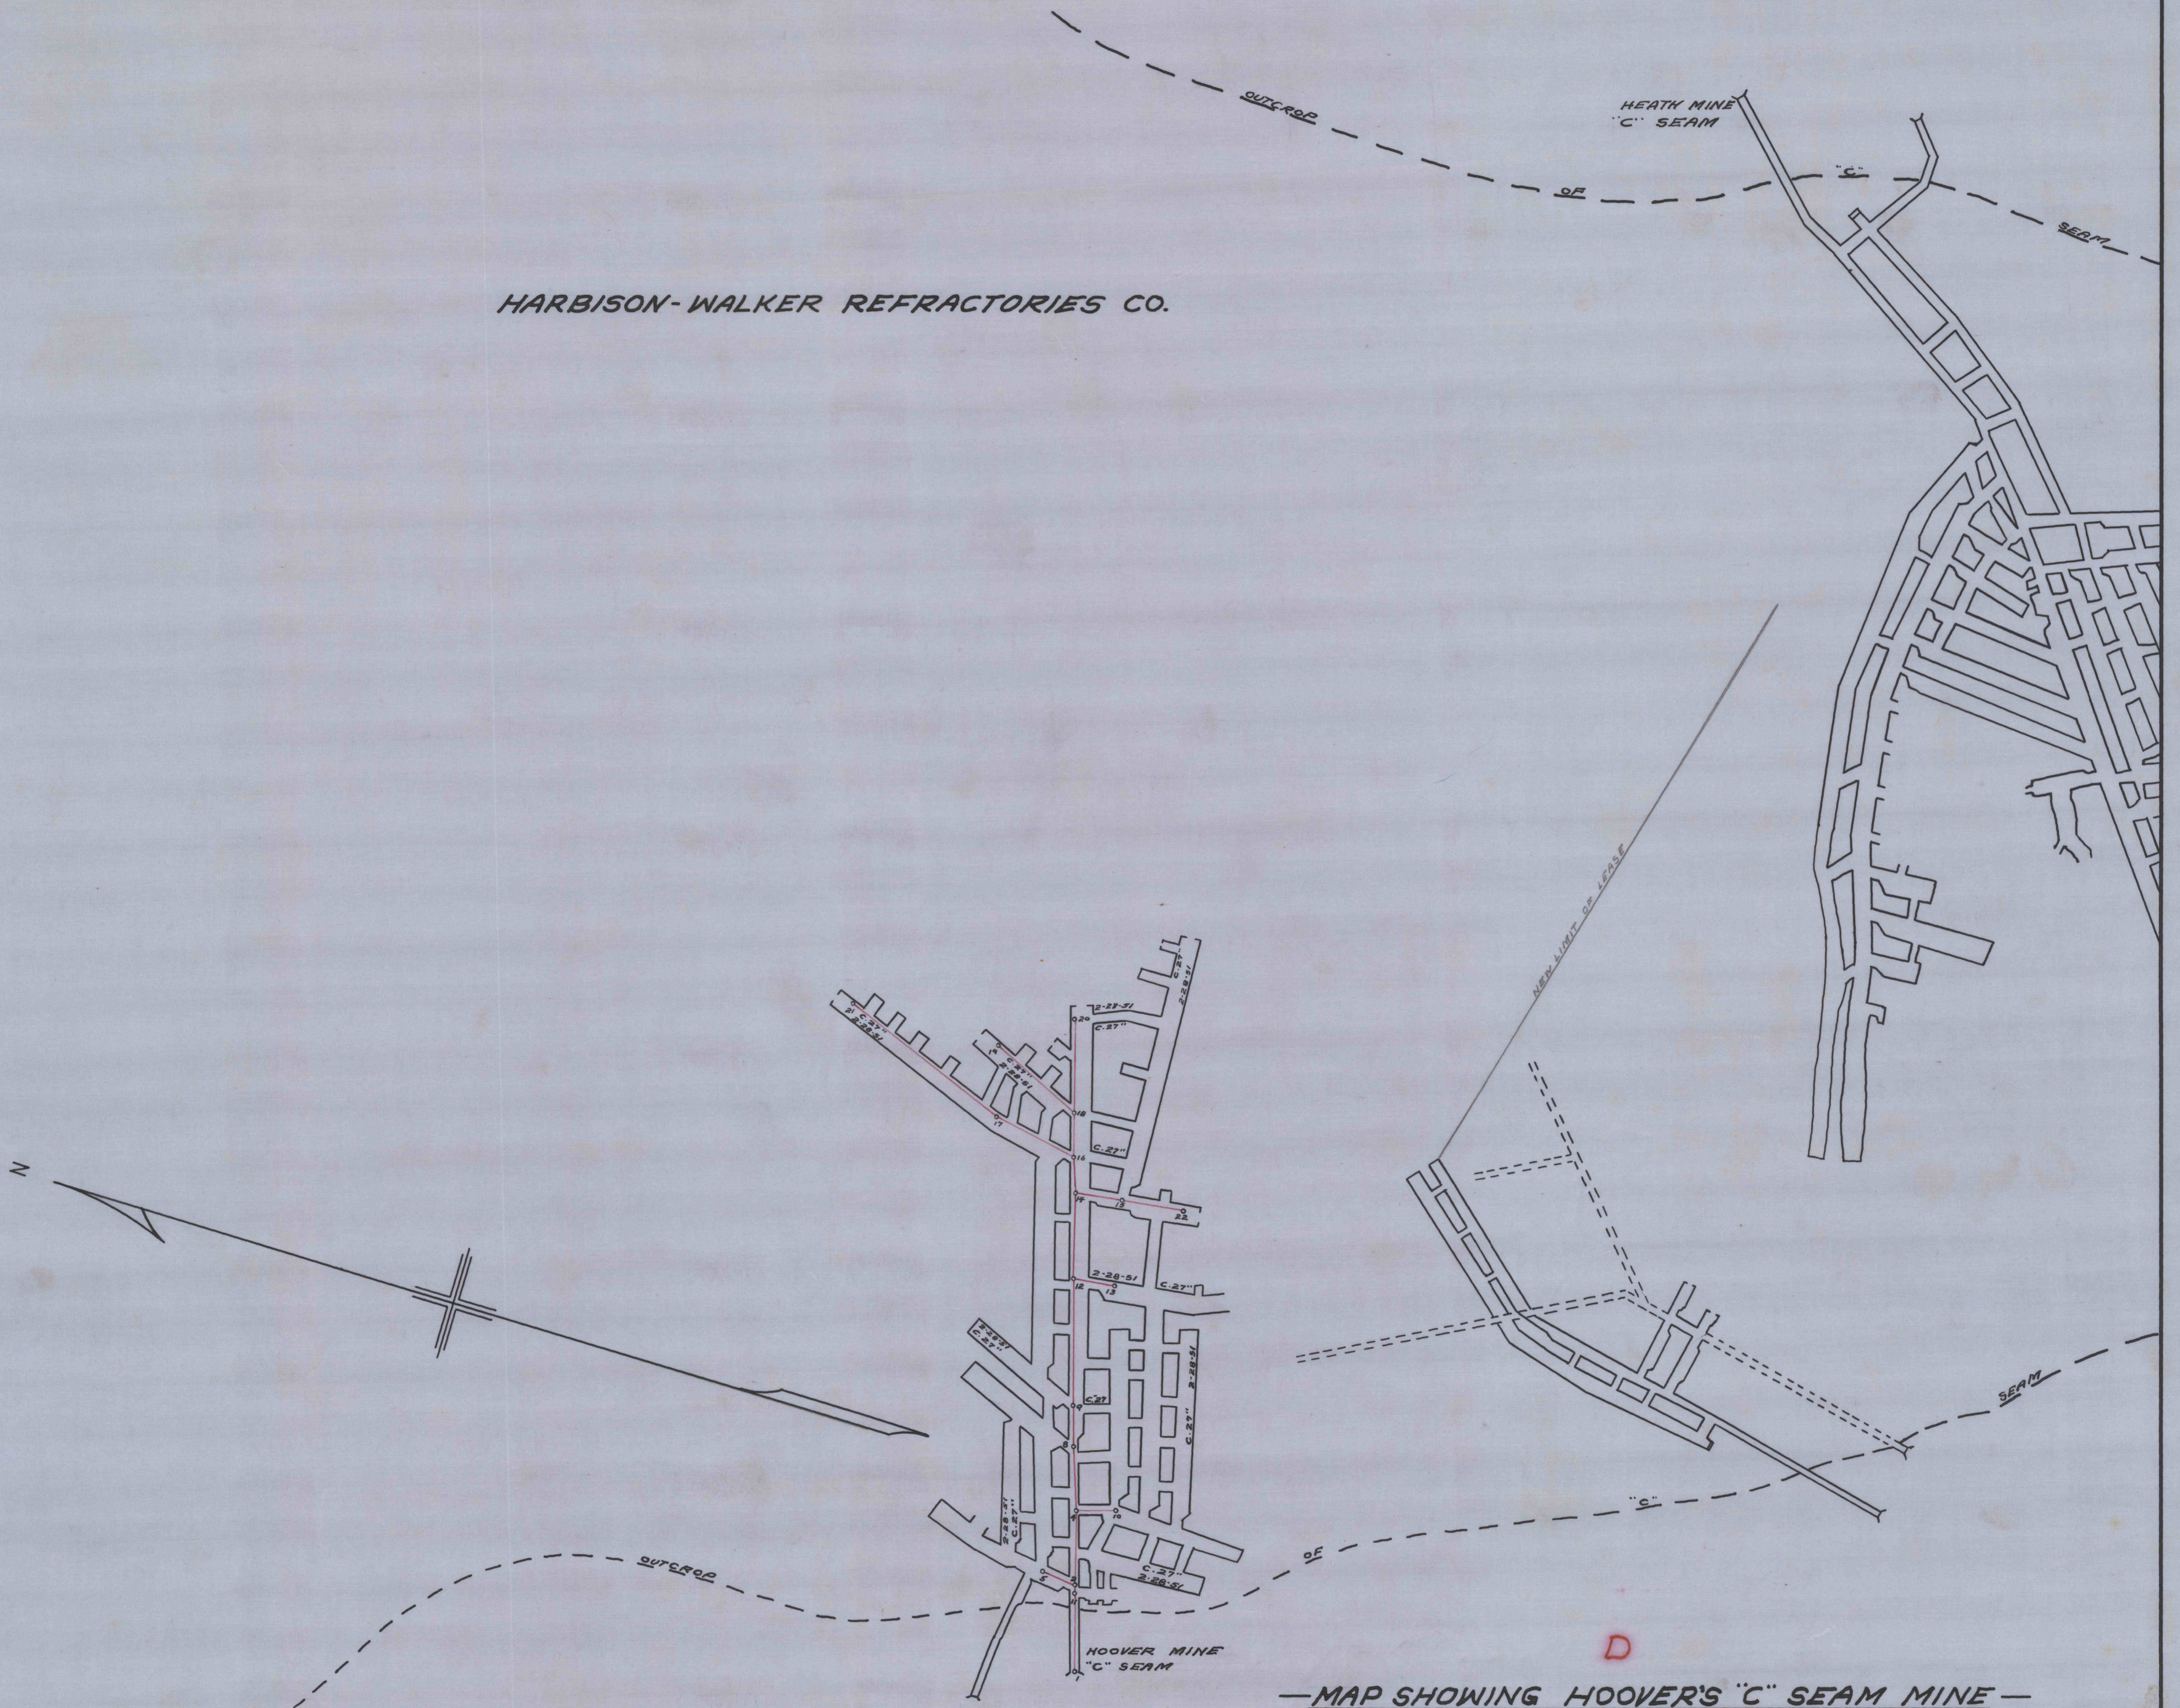

—MAP SHOWING HOOVER'S "C" SEAM MINE—
—LOCATED AT RETORT PENNA.—
—RUSH TWP. CENTRE COUNTY PA.—
—SCALE 1"=100'— MARCH 2, 1951—

—BERNARD LUCAS ENGR.—

G.D. 356

1818

1878