


108

1889

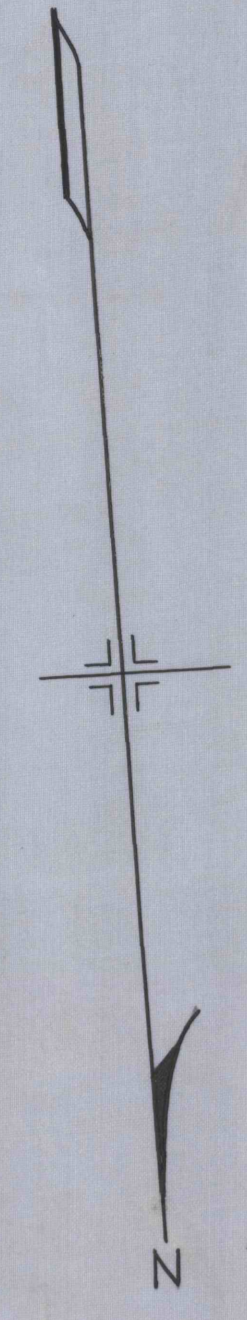

RIVER HILL COAL CO. 'B' SEAM

LUCUS ESTATE

PROPERTY LINE 7


PROPERTY LINE 7

POWER LINE 1

OLD WORKINGS

LIGHT RAIL

STRIPPING

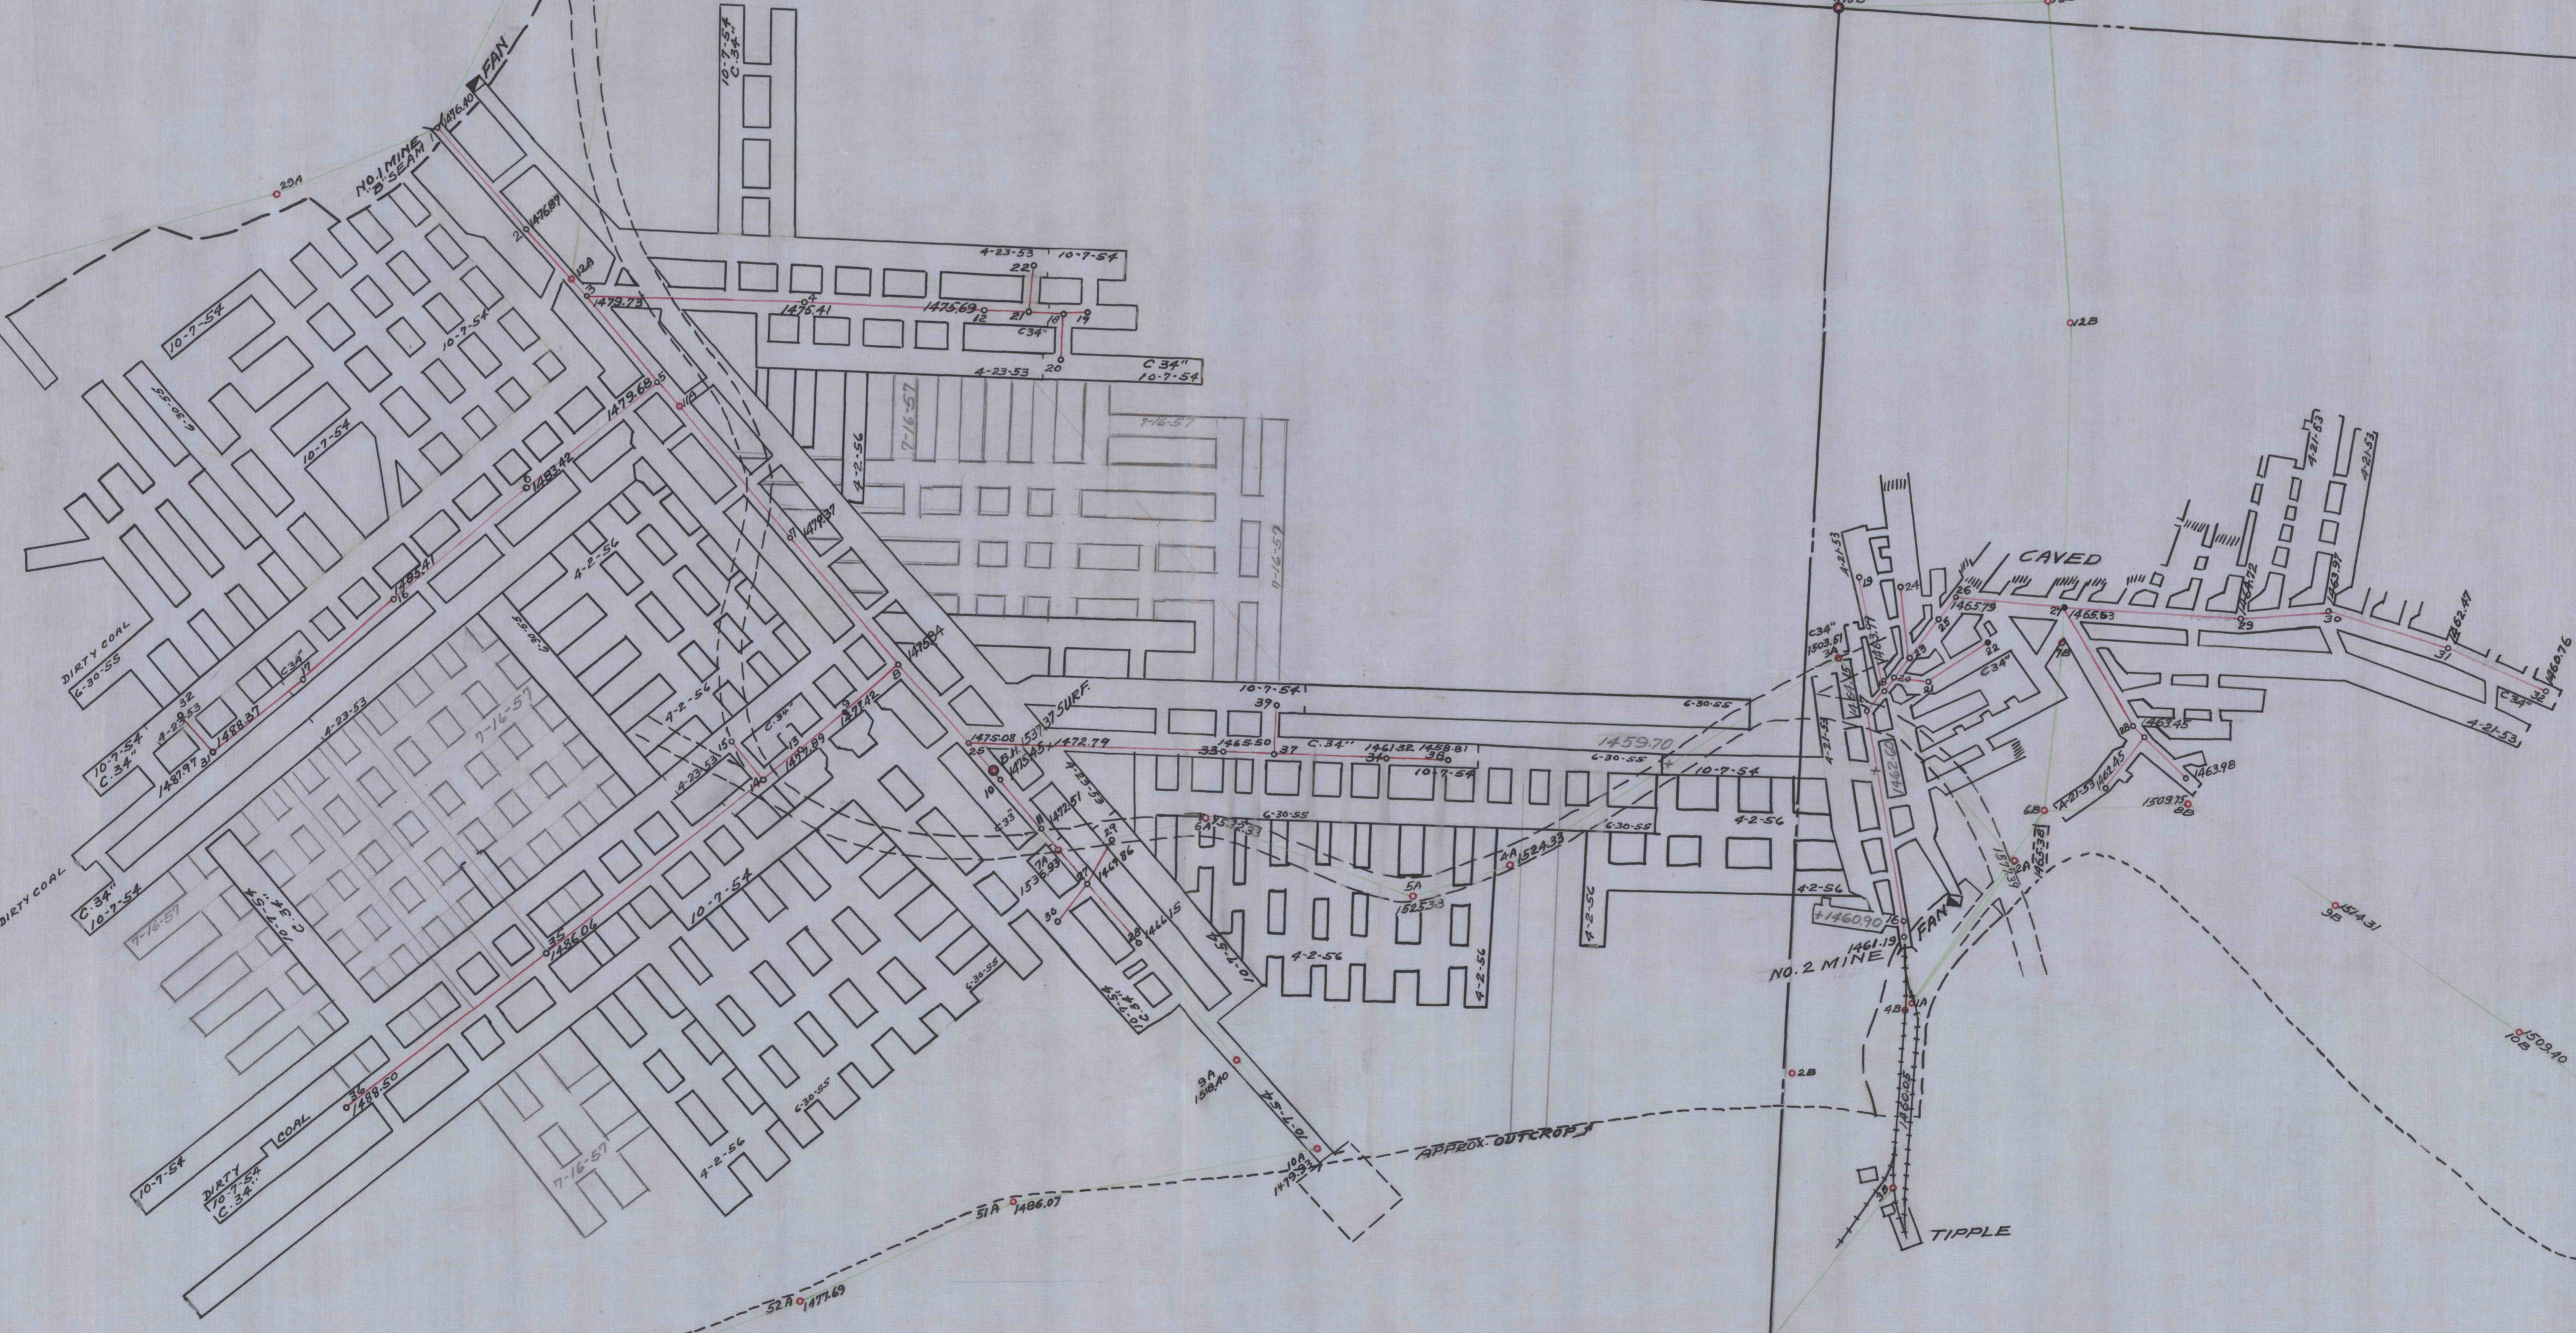

D

— MAP OF NO. 1 AND NO. 2 "B" SEAM MINES —
 — OPERATED BY ROBERT BAILEY —
 — COOPER TWP. CLEARFIELD CO. PA —
 — SCALE 1" = 100' — MAY 7, 1953 —

C.D. 408

BERNARD LUCAS ENGR.

1889