



WOMELSDORFF & DUNKLE

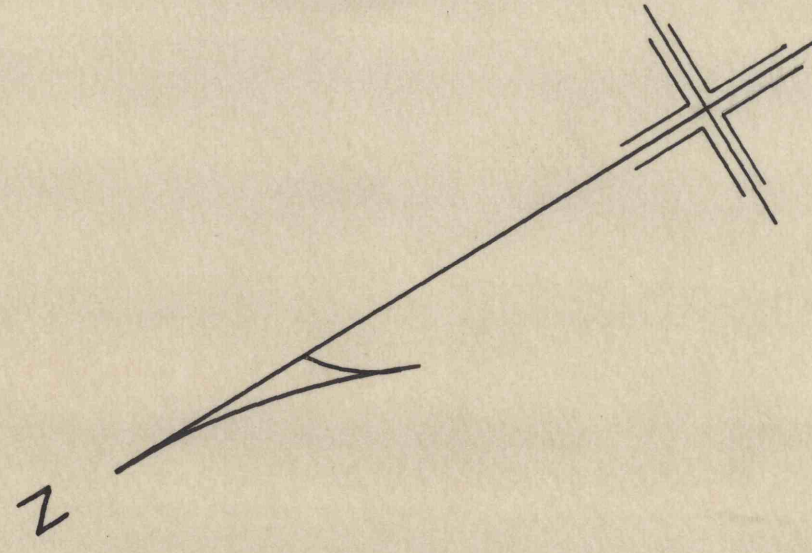

SAMUEL JONES TRACT  
WOMELSDORFF & DUNKLE

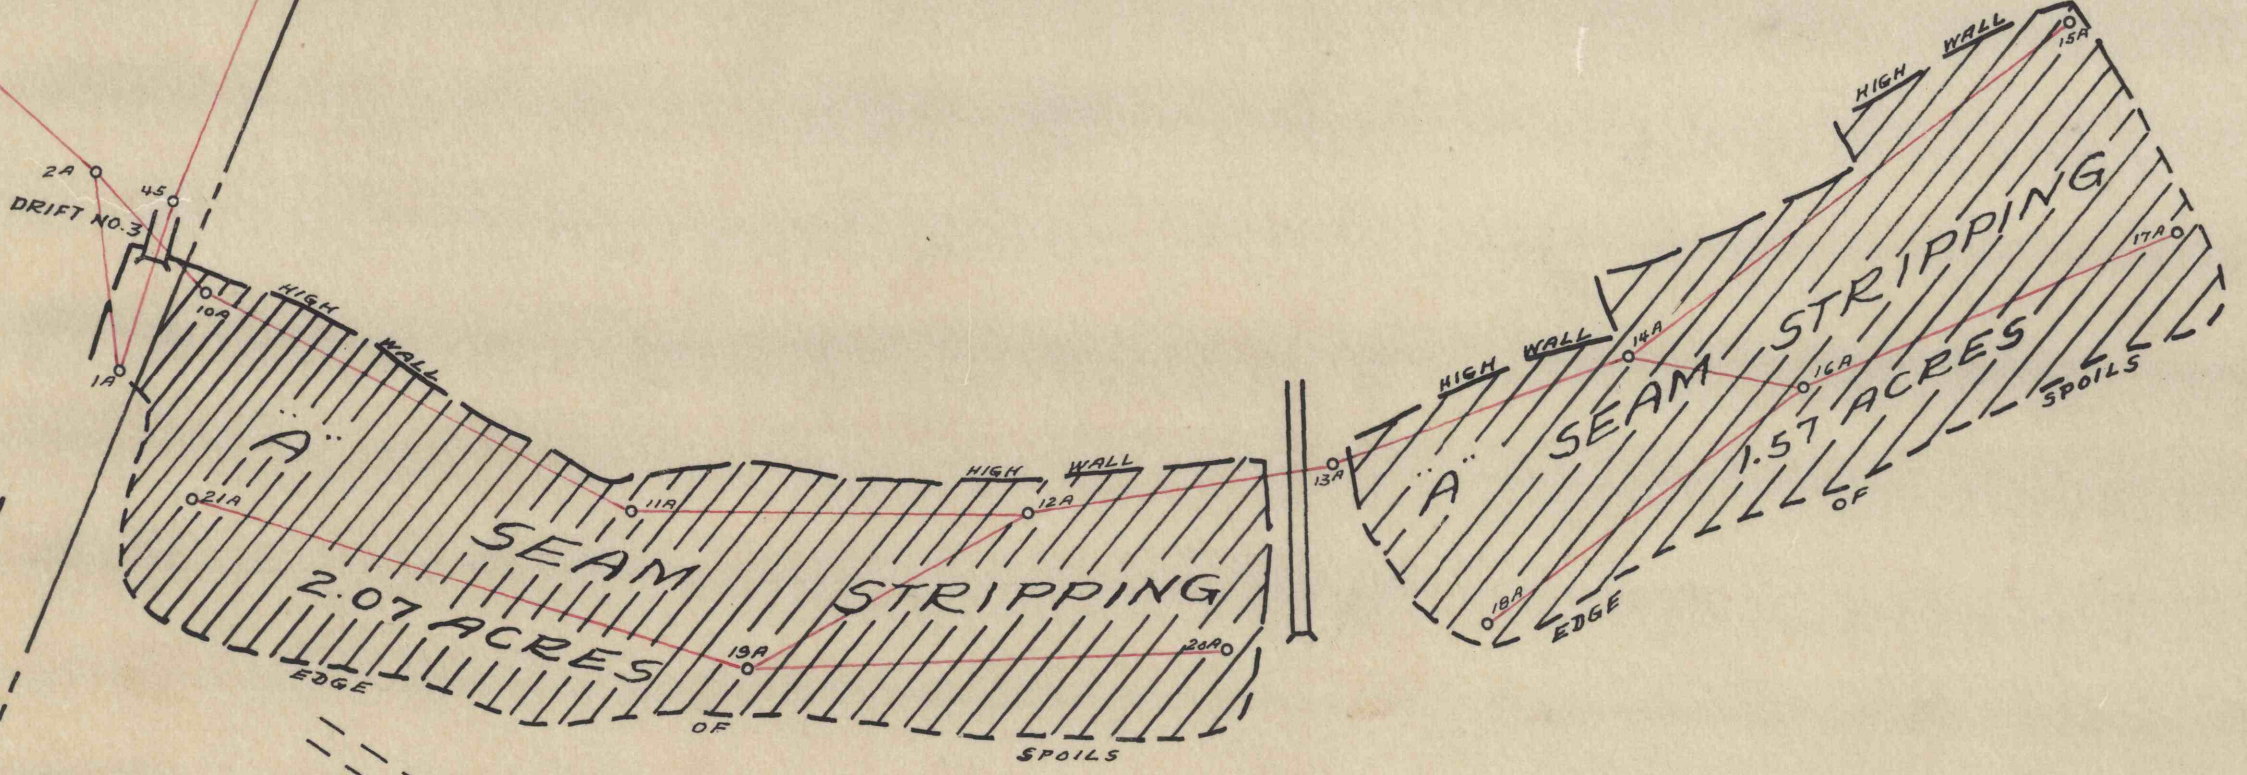

JAMES MORRISON TRACT  
P. C. & L. CO.

MINE ROAD

STATE ROAD ROUTE NO. 322

TO PHILIPSBURG

1914 M

— MAP SHOWING "A" SEAM STRIPPINGS —  
— OPERATED BY JOHN F. WALKER COAL COMPANY —  
— RUSH TOWNSHIP CENTRE COUNTY PENNA. —  
— SCALE 1 1/2" = 100' — NOV. 4 1952 —

BERNARD LUCAS ENGR.

NOTE:  
STRIPPINGS ARE LEVELED & BACKFILLED

C.D. 310