


2112

2111

1915

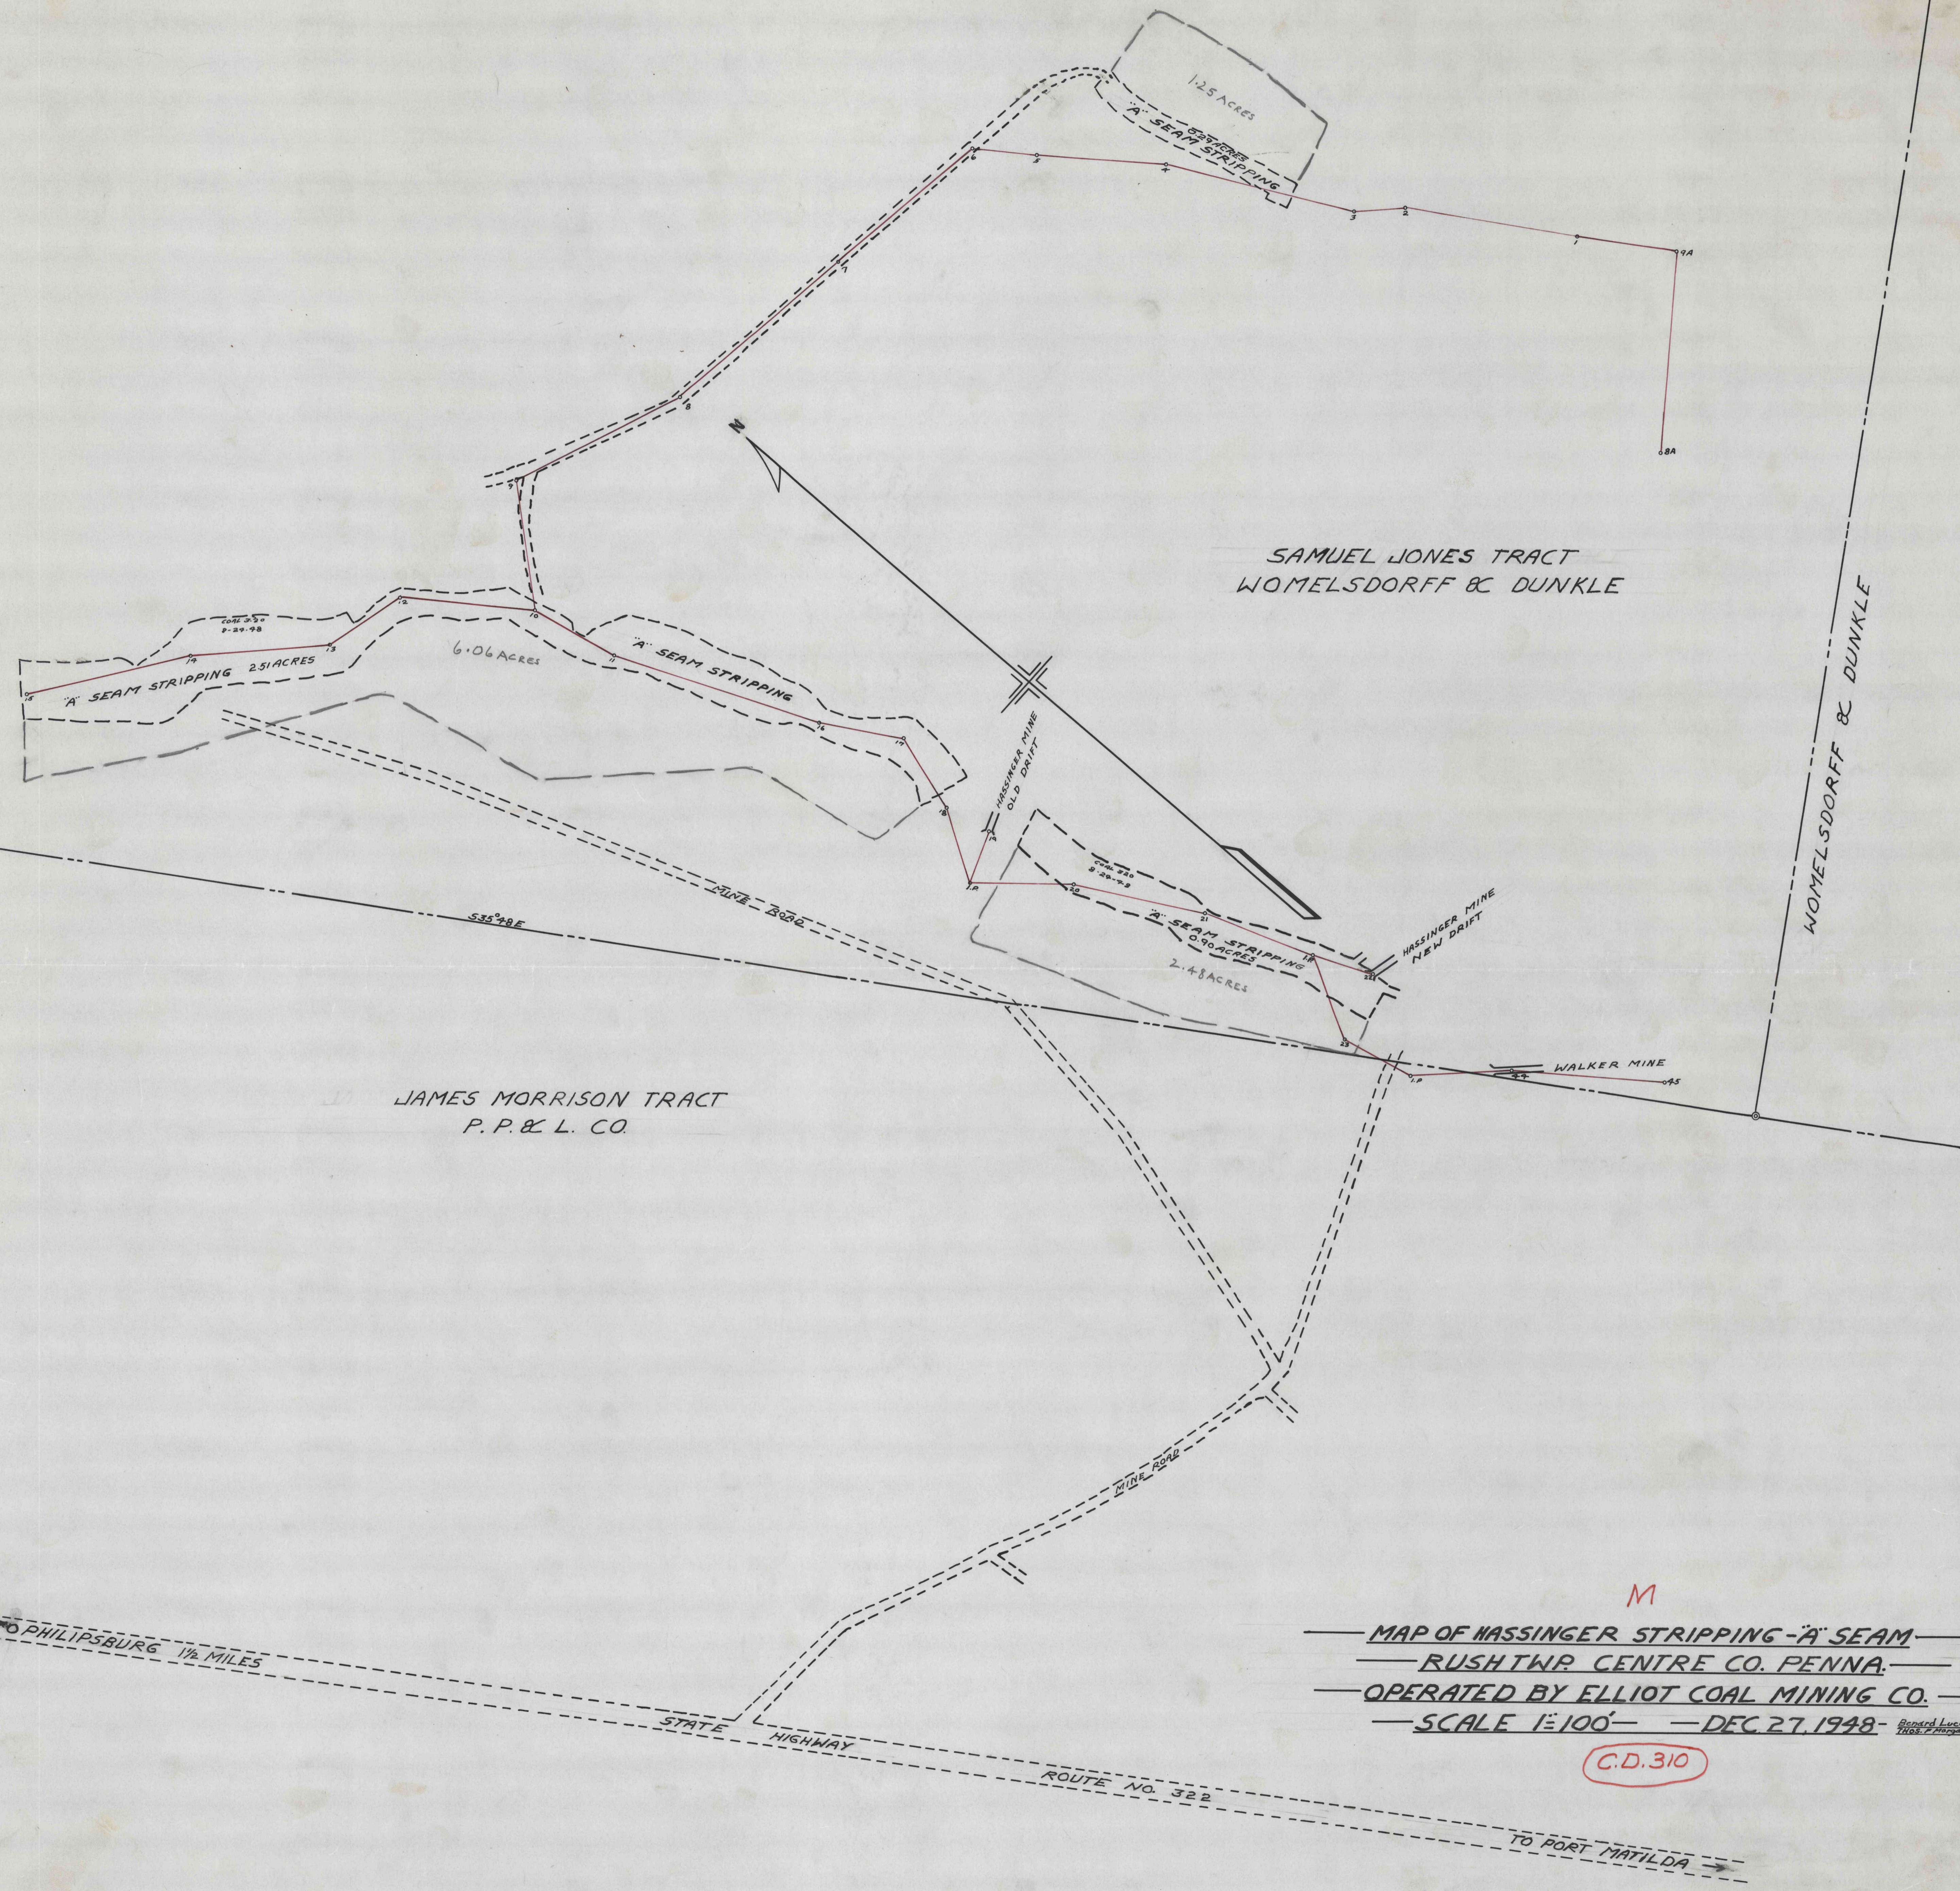

SAMUEL JONES TRACT
WOMELSDORFF & DUNKLE

JAMES MORRISON TRACT
P. P. & L. CO.

WOMELSDORFF & DUNKLE

TO PHILIPSBURG 1 1/2 MILES

STATE HIGHWAY
ROUTE NO. 322

TO PORT MATILDA

M
 — MAP OF HASSINGER STRIPPING - "A" SEAM —
 — RUSH TWP. CENTRE CO. PENNA. —
 — OPERATED BY ELLIOT COAL MINING CO. —
 — SCALE 1"=100' — DEC 27, 1948 —

C.D.310

