


1923


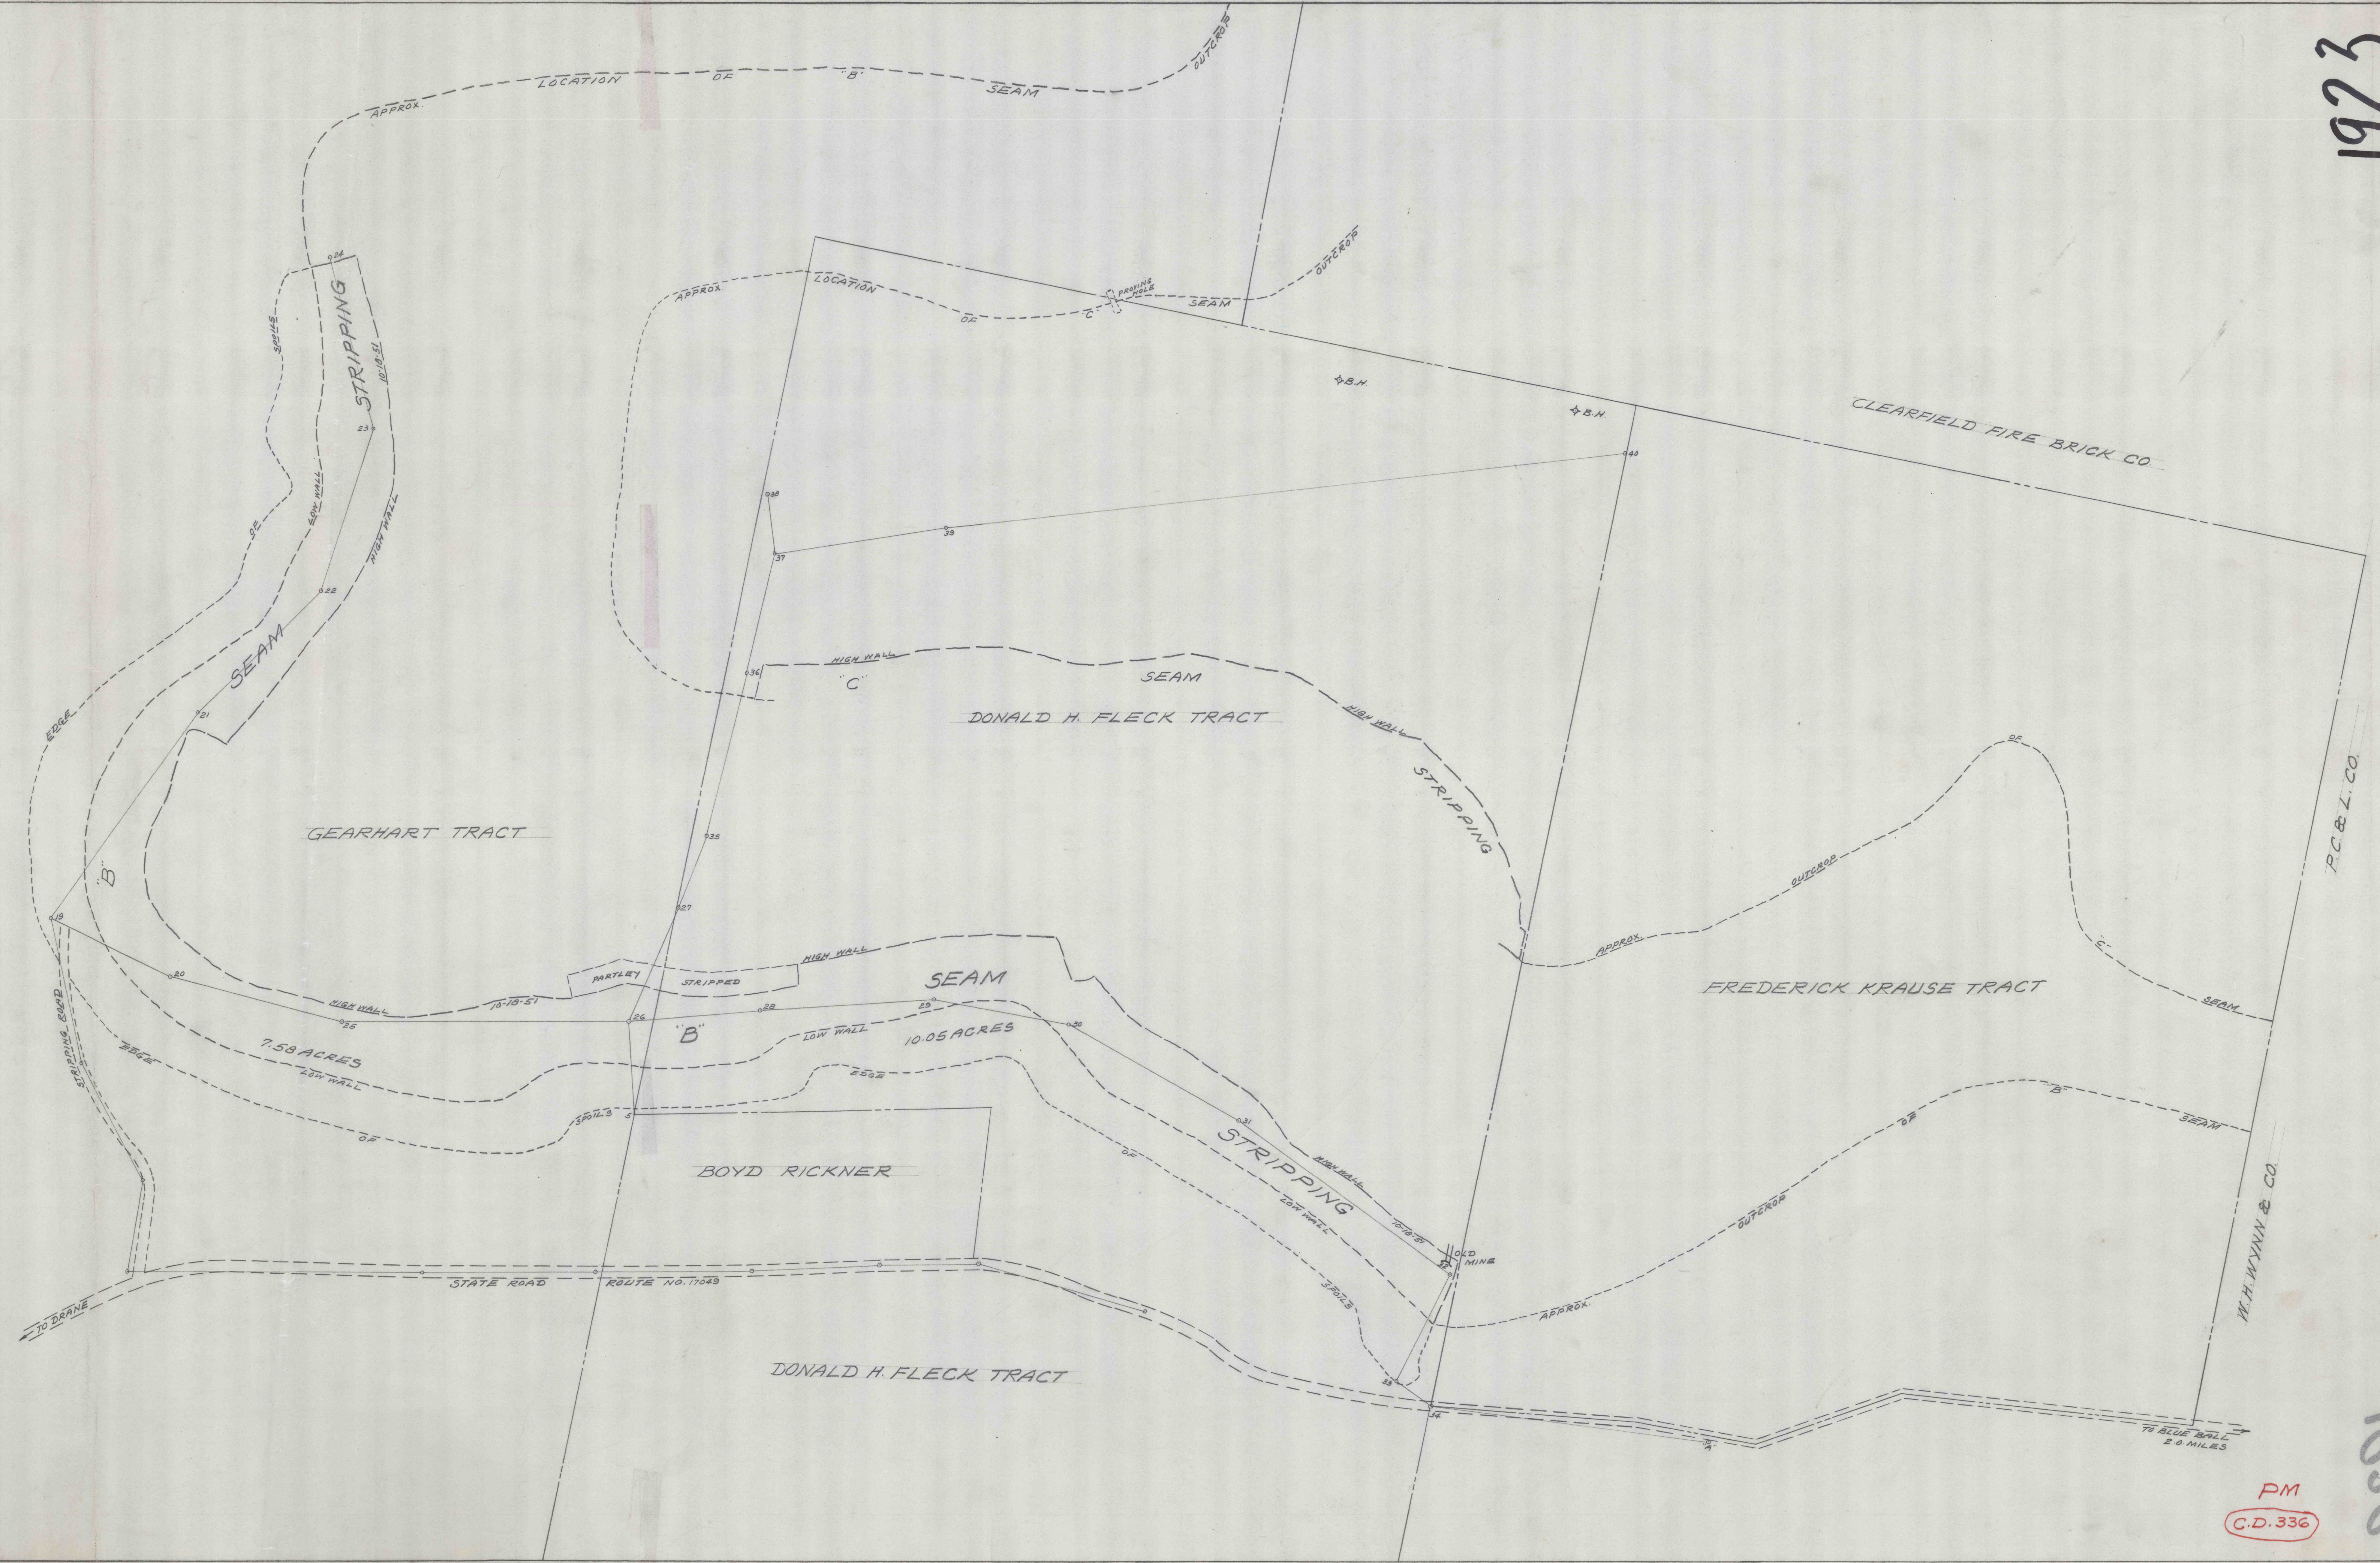

PM
C.D. 336

1933