


HENRY PINKERTON TRACT

JACOB DILLER TRACT

JAMES MORRISON TRACT P.C. & L.CO.

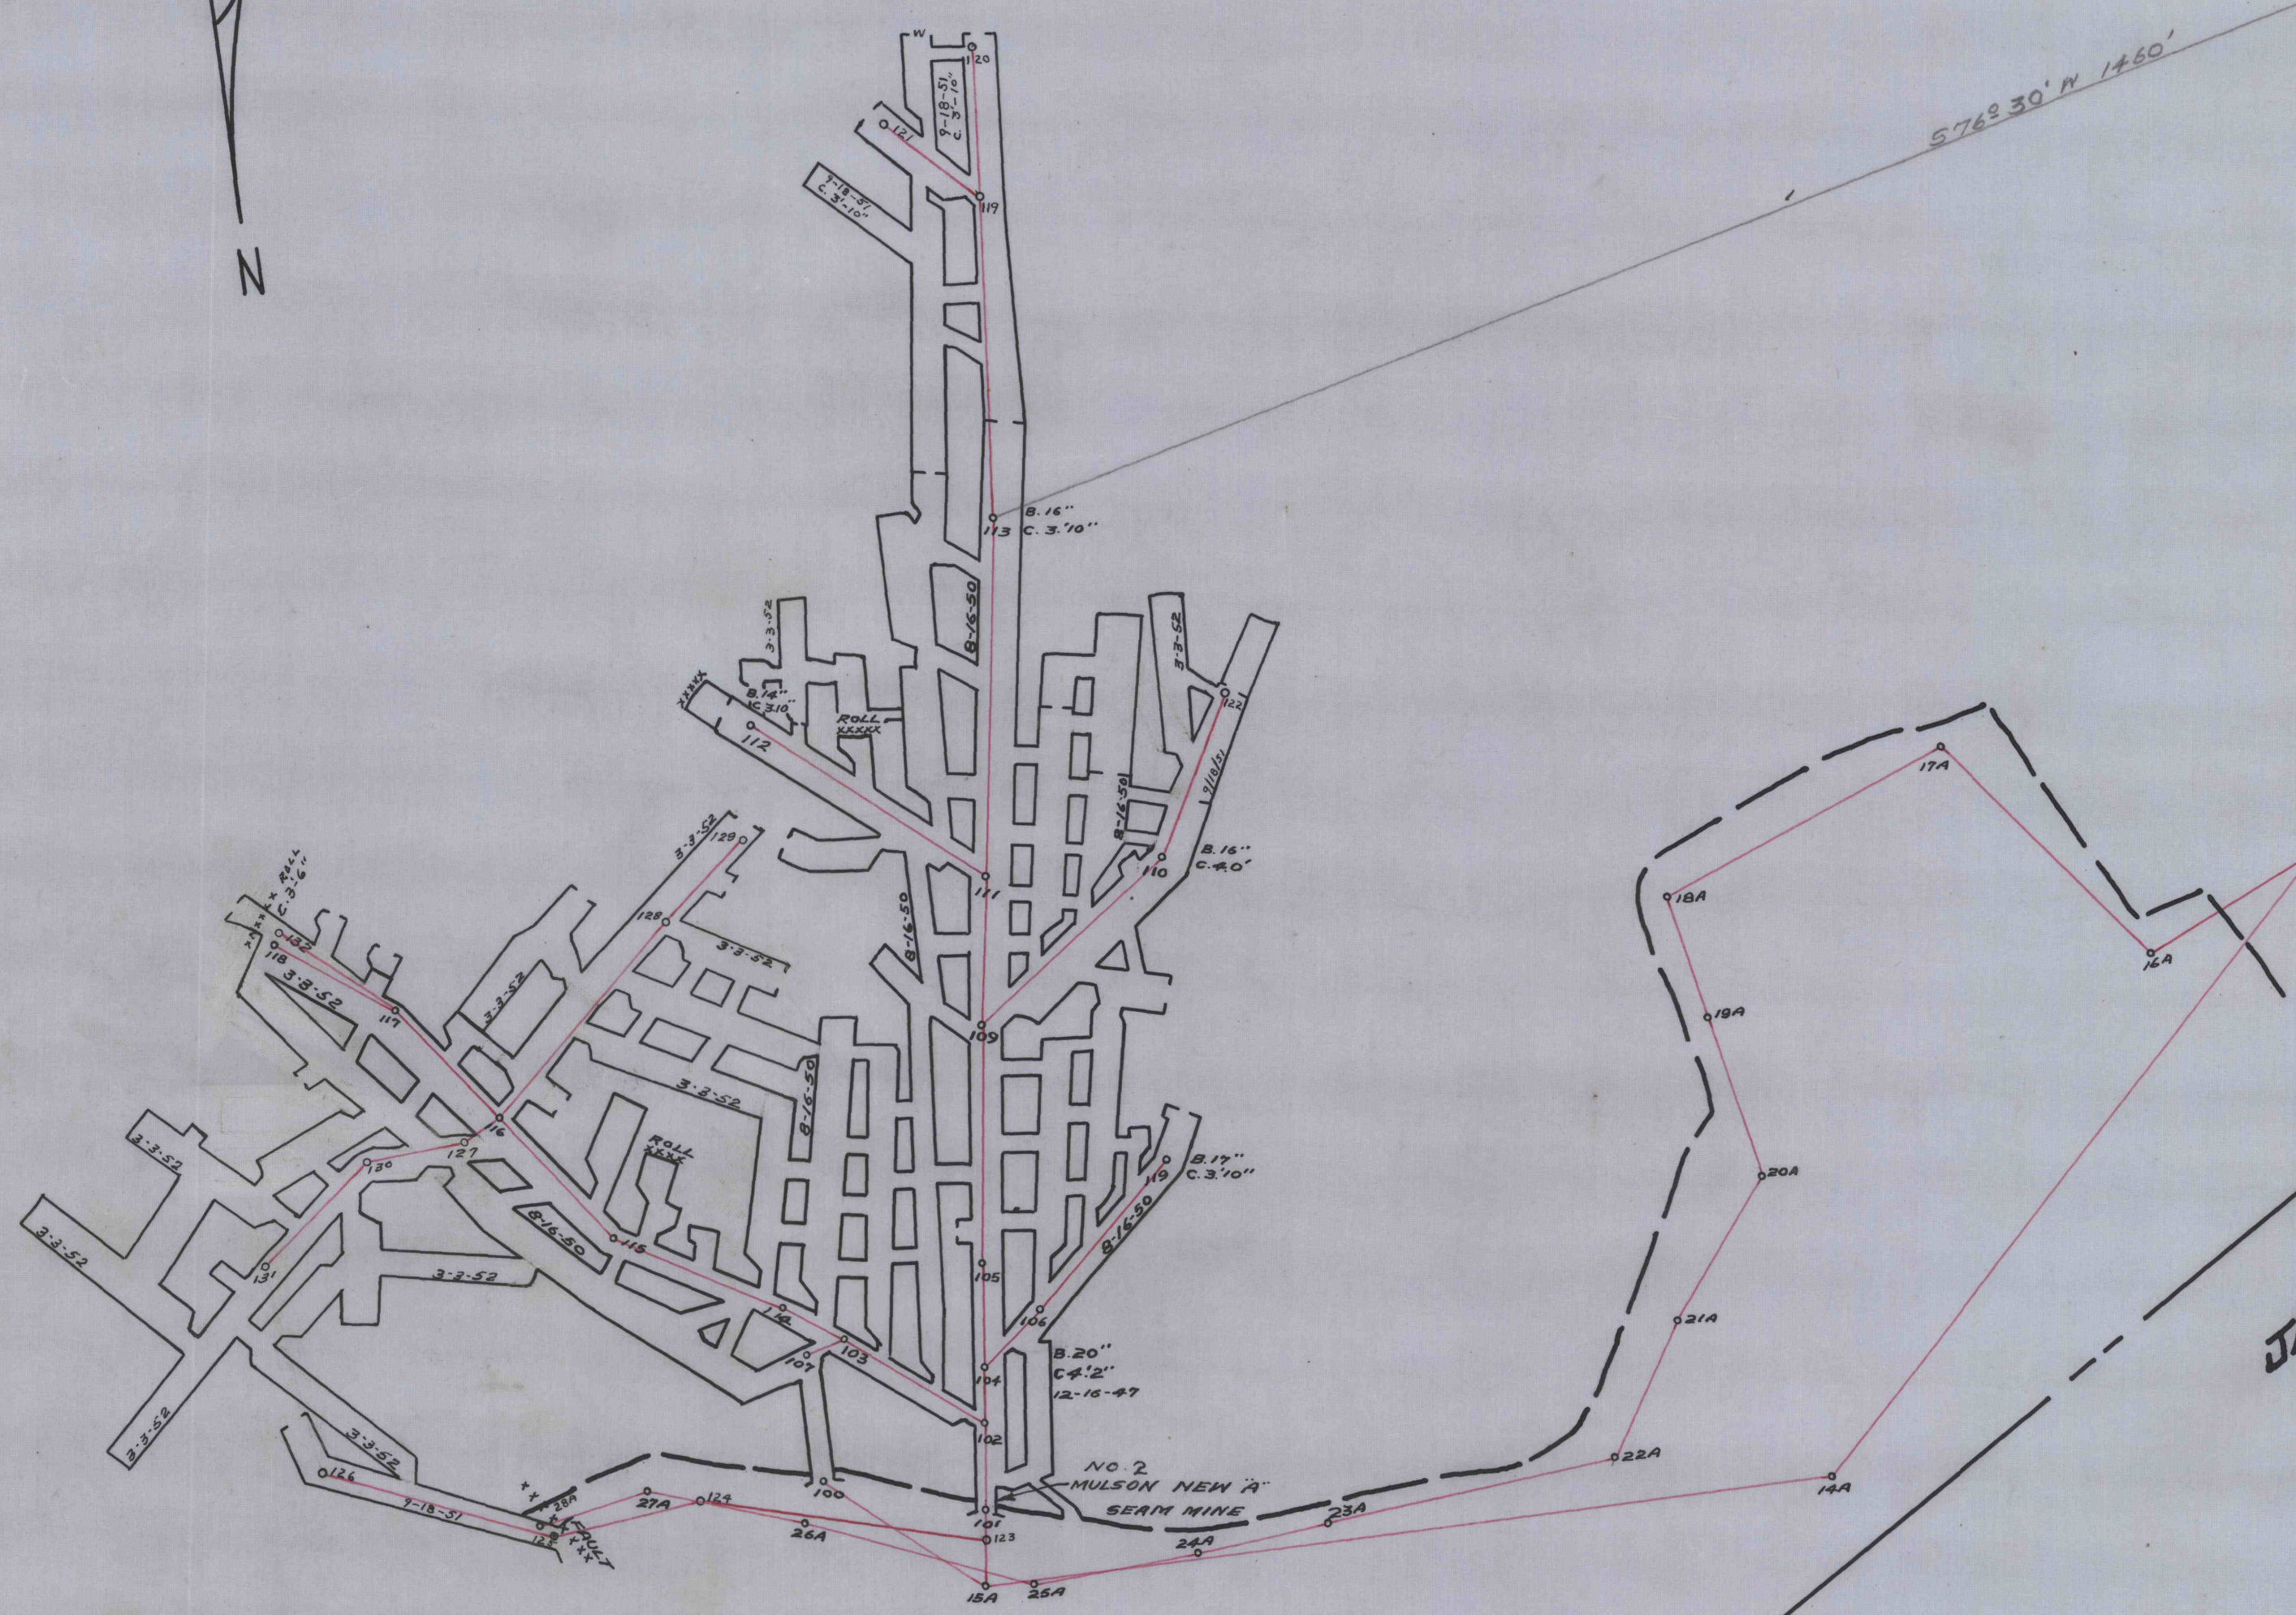

— MAP OF MULSON HOUSE COAL MINE —
— RUSH TOWNSHIP CENTRE CO. PA. —
— OPERATED BY JOSEPH MULSON —
— SCALE 1" = 100' — — AUG. 19, 1950 —

BERNARD LUCAS ENGR

C.D. 215

1942

54191