



1943

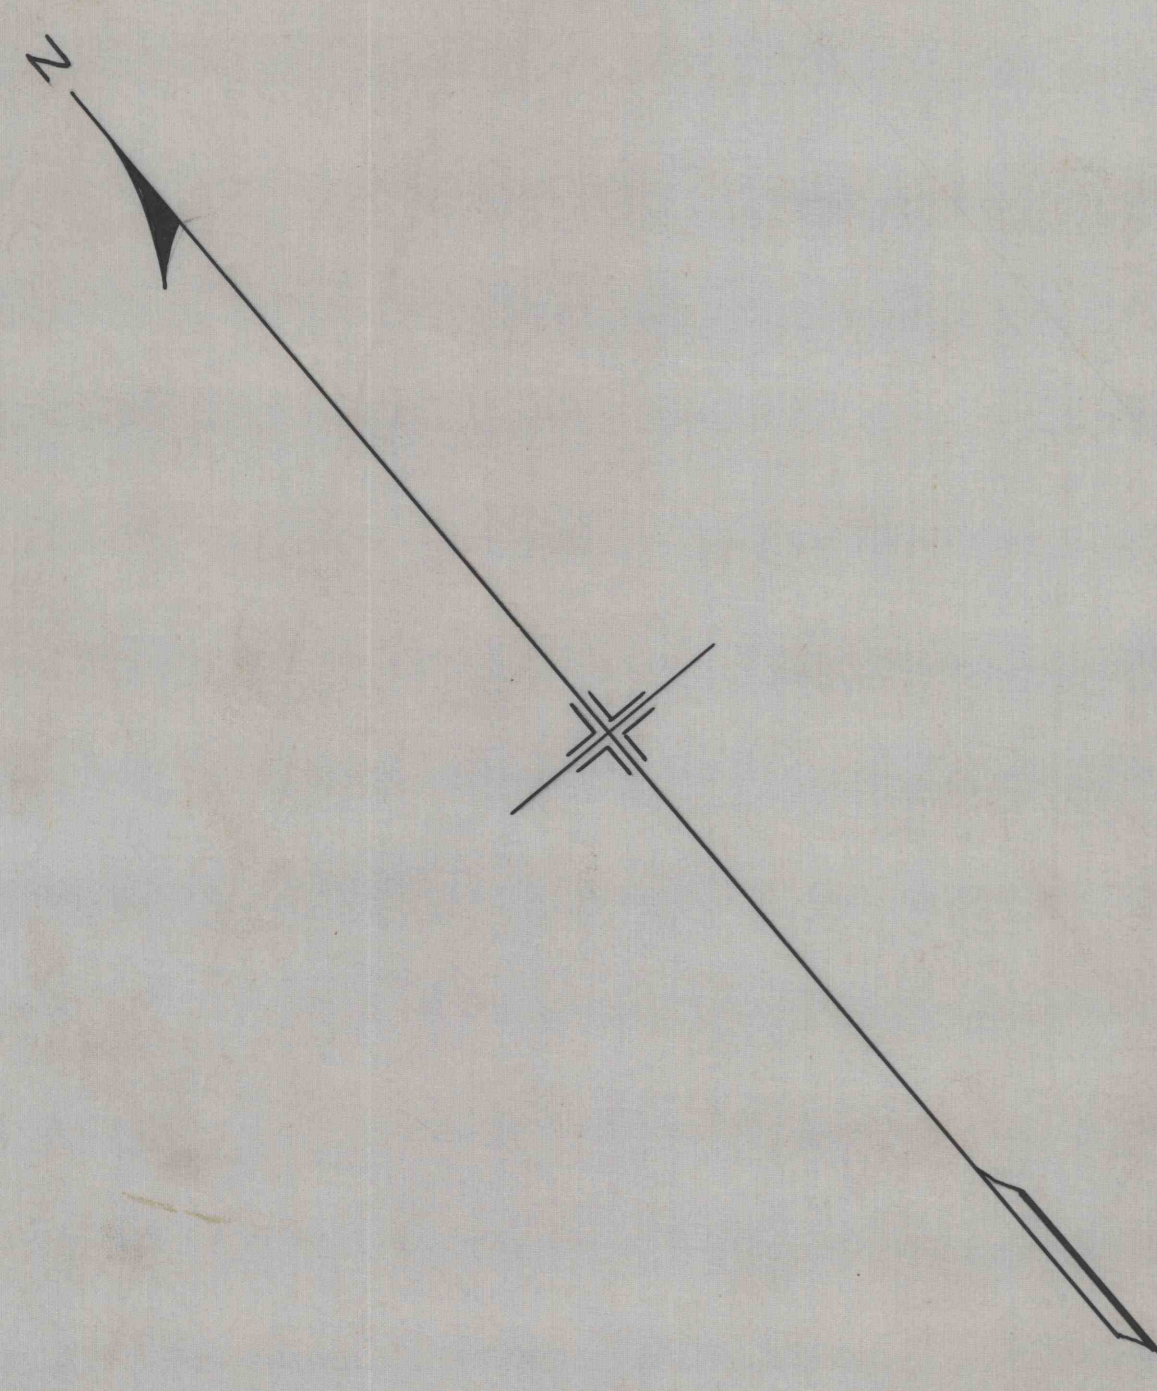

JAMES MORRISON TRACT P.C. & L.CO.

HUGH MCINTYRE TRACT - P.C. & L. CO.

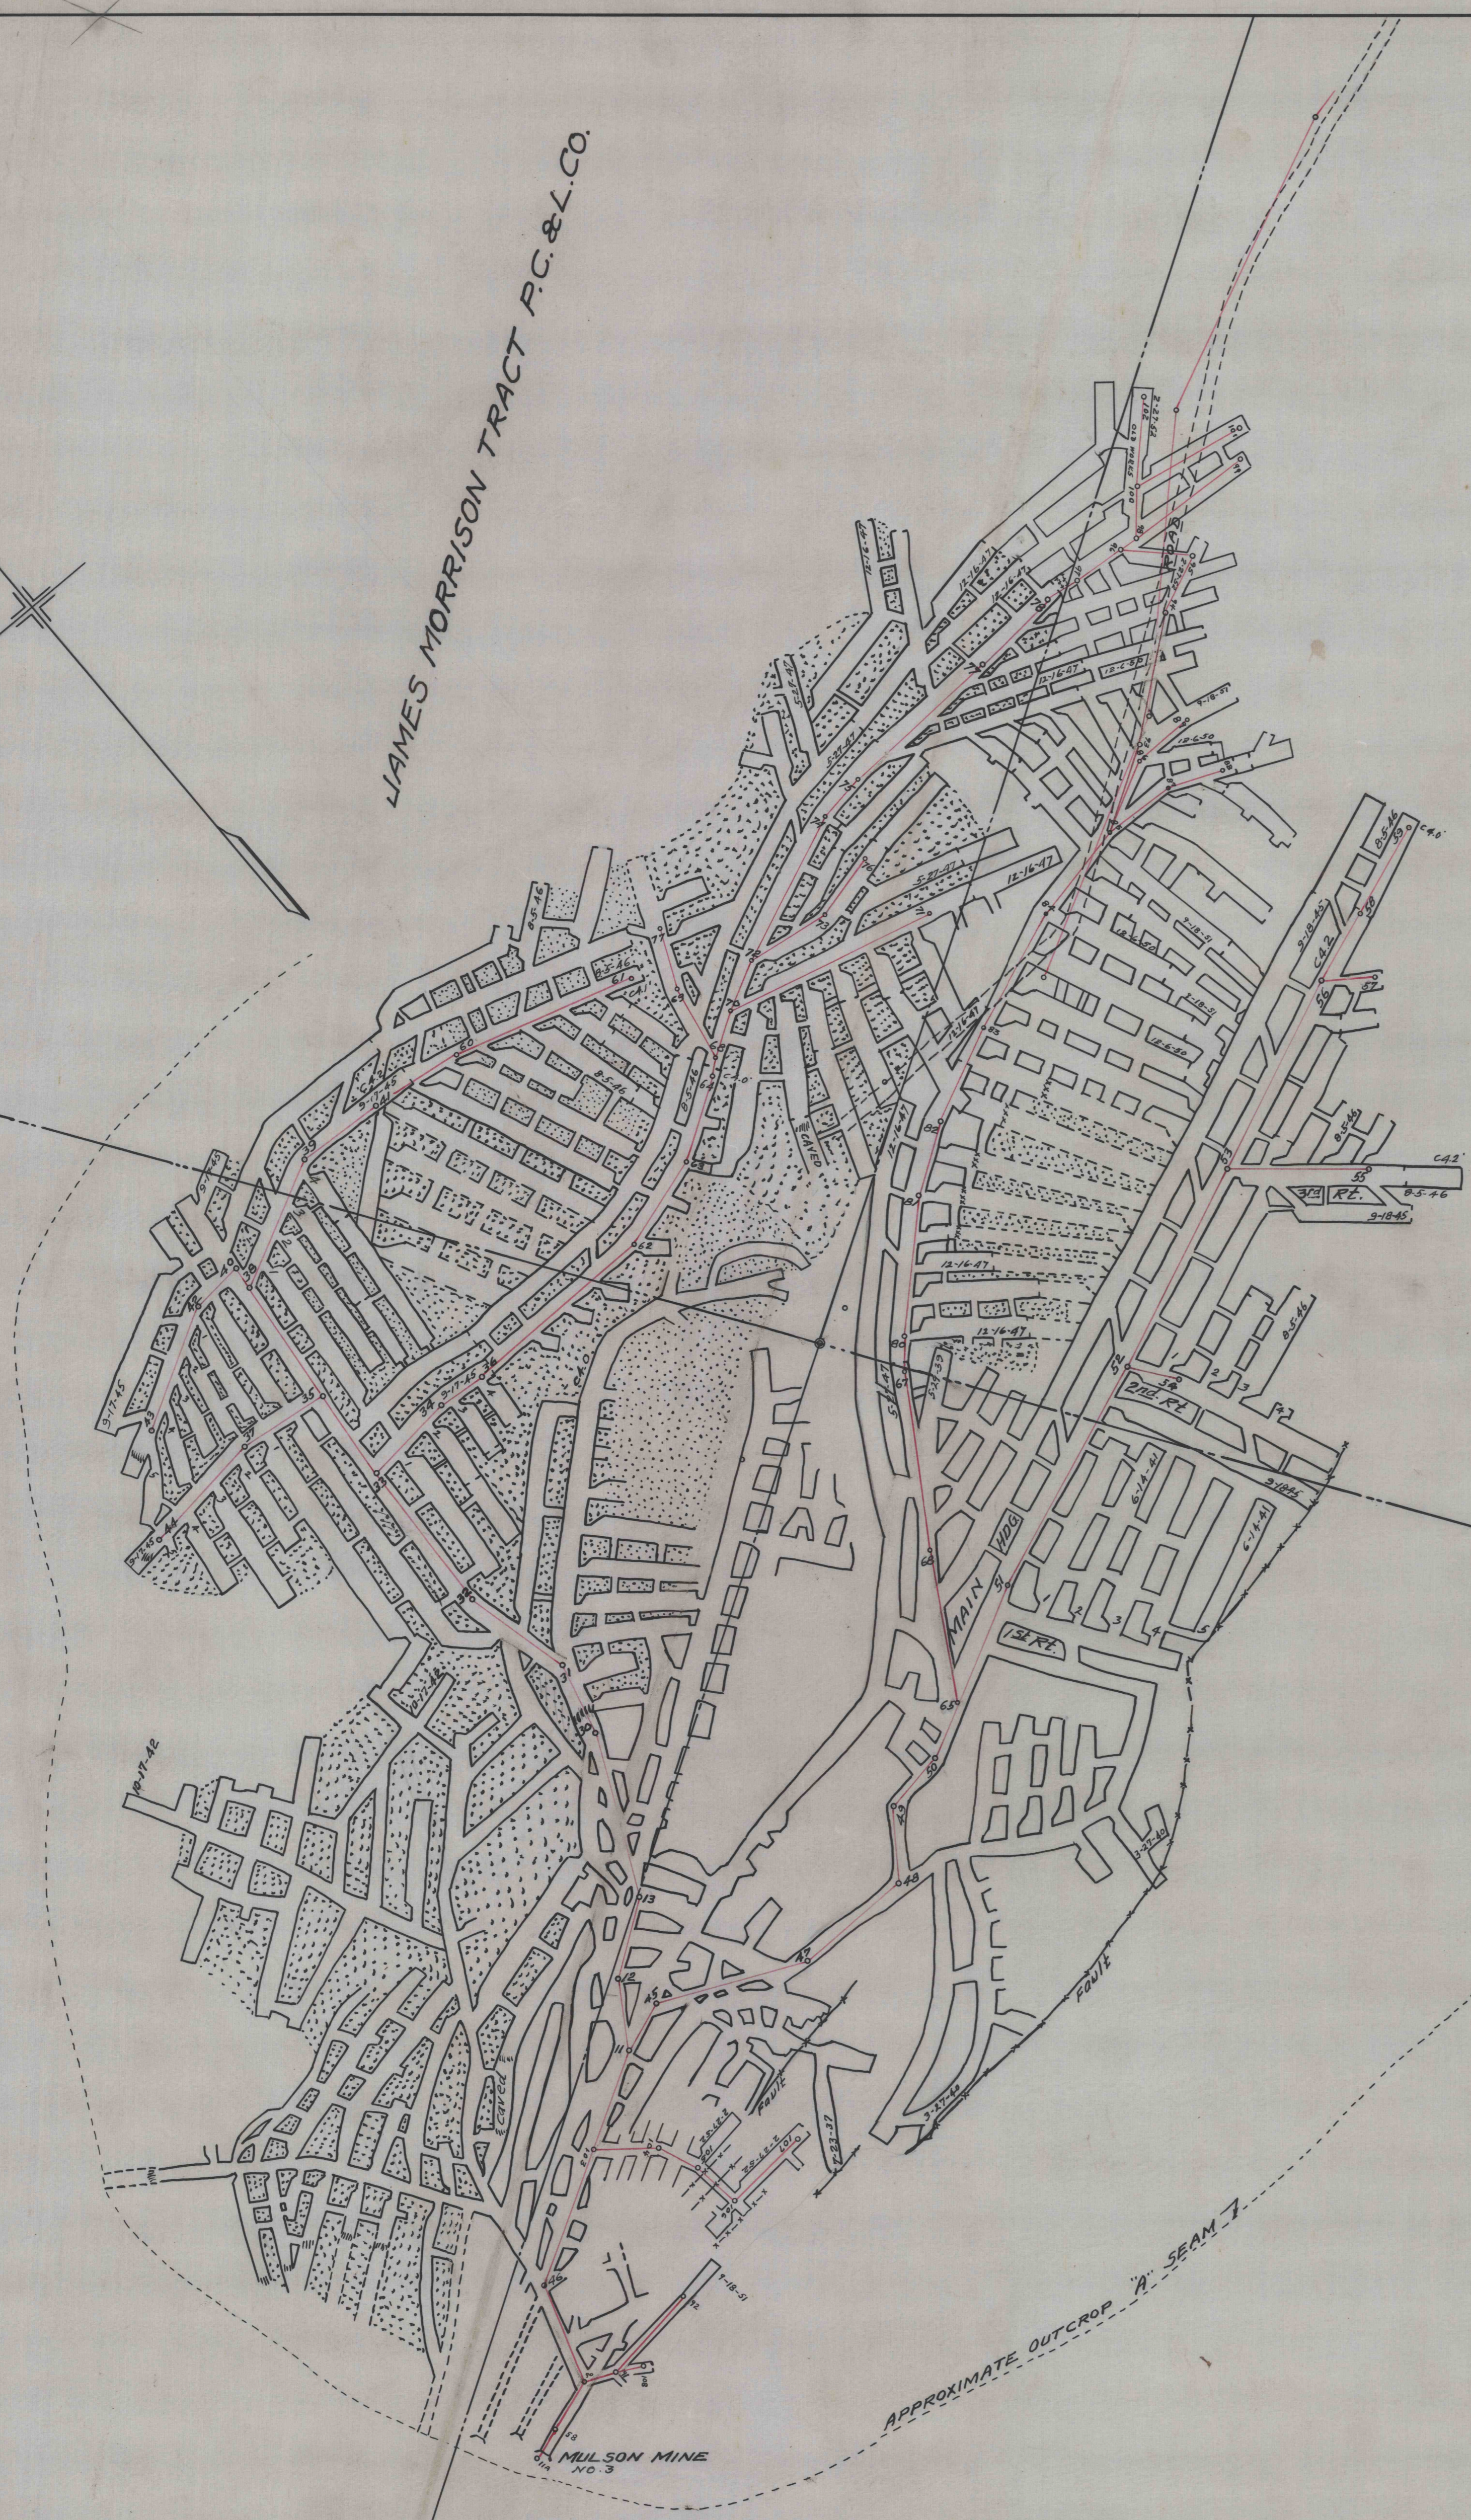

JACOB DILLER TRACT

HENRY PINKERTON TRACT

Sharer Mine

APPROXIMATE OUTCROP OF SEAM 7

MULSON MINE NO. 3

D

— MAP OF MULSON HOUSE COAL MINE —  
 — RUSH TOWNSHIP CENTRE CO. PA. —  
 — OPERATED BY JOSEPH MULSON —  
 — SCALE 1"=100' —      — SEPT. 27, 1945 —

NOTE: ~~Property lines~~ old workings taken from maps prepared by J.W. Mulson & E.R. Griffith

POSTED TO DEC. 16, 1947

C.D. 215

Bernard Lucas Engrs.  
Thomas F. Morgan

Handwritten initials or signature in the bottom right corner.