



ANDREW BRUSHMAN

PINT BARS

CLARE PHILLIPS

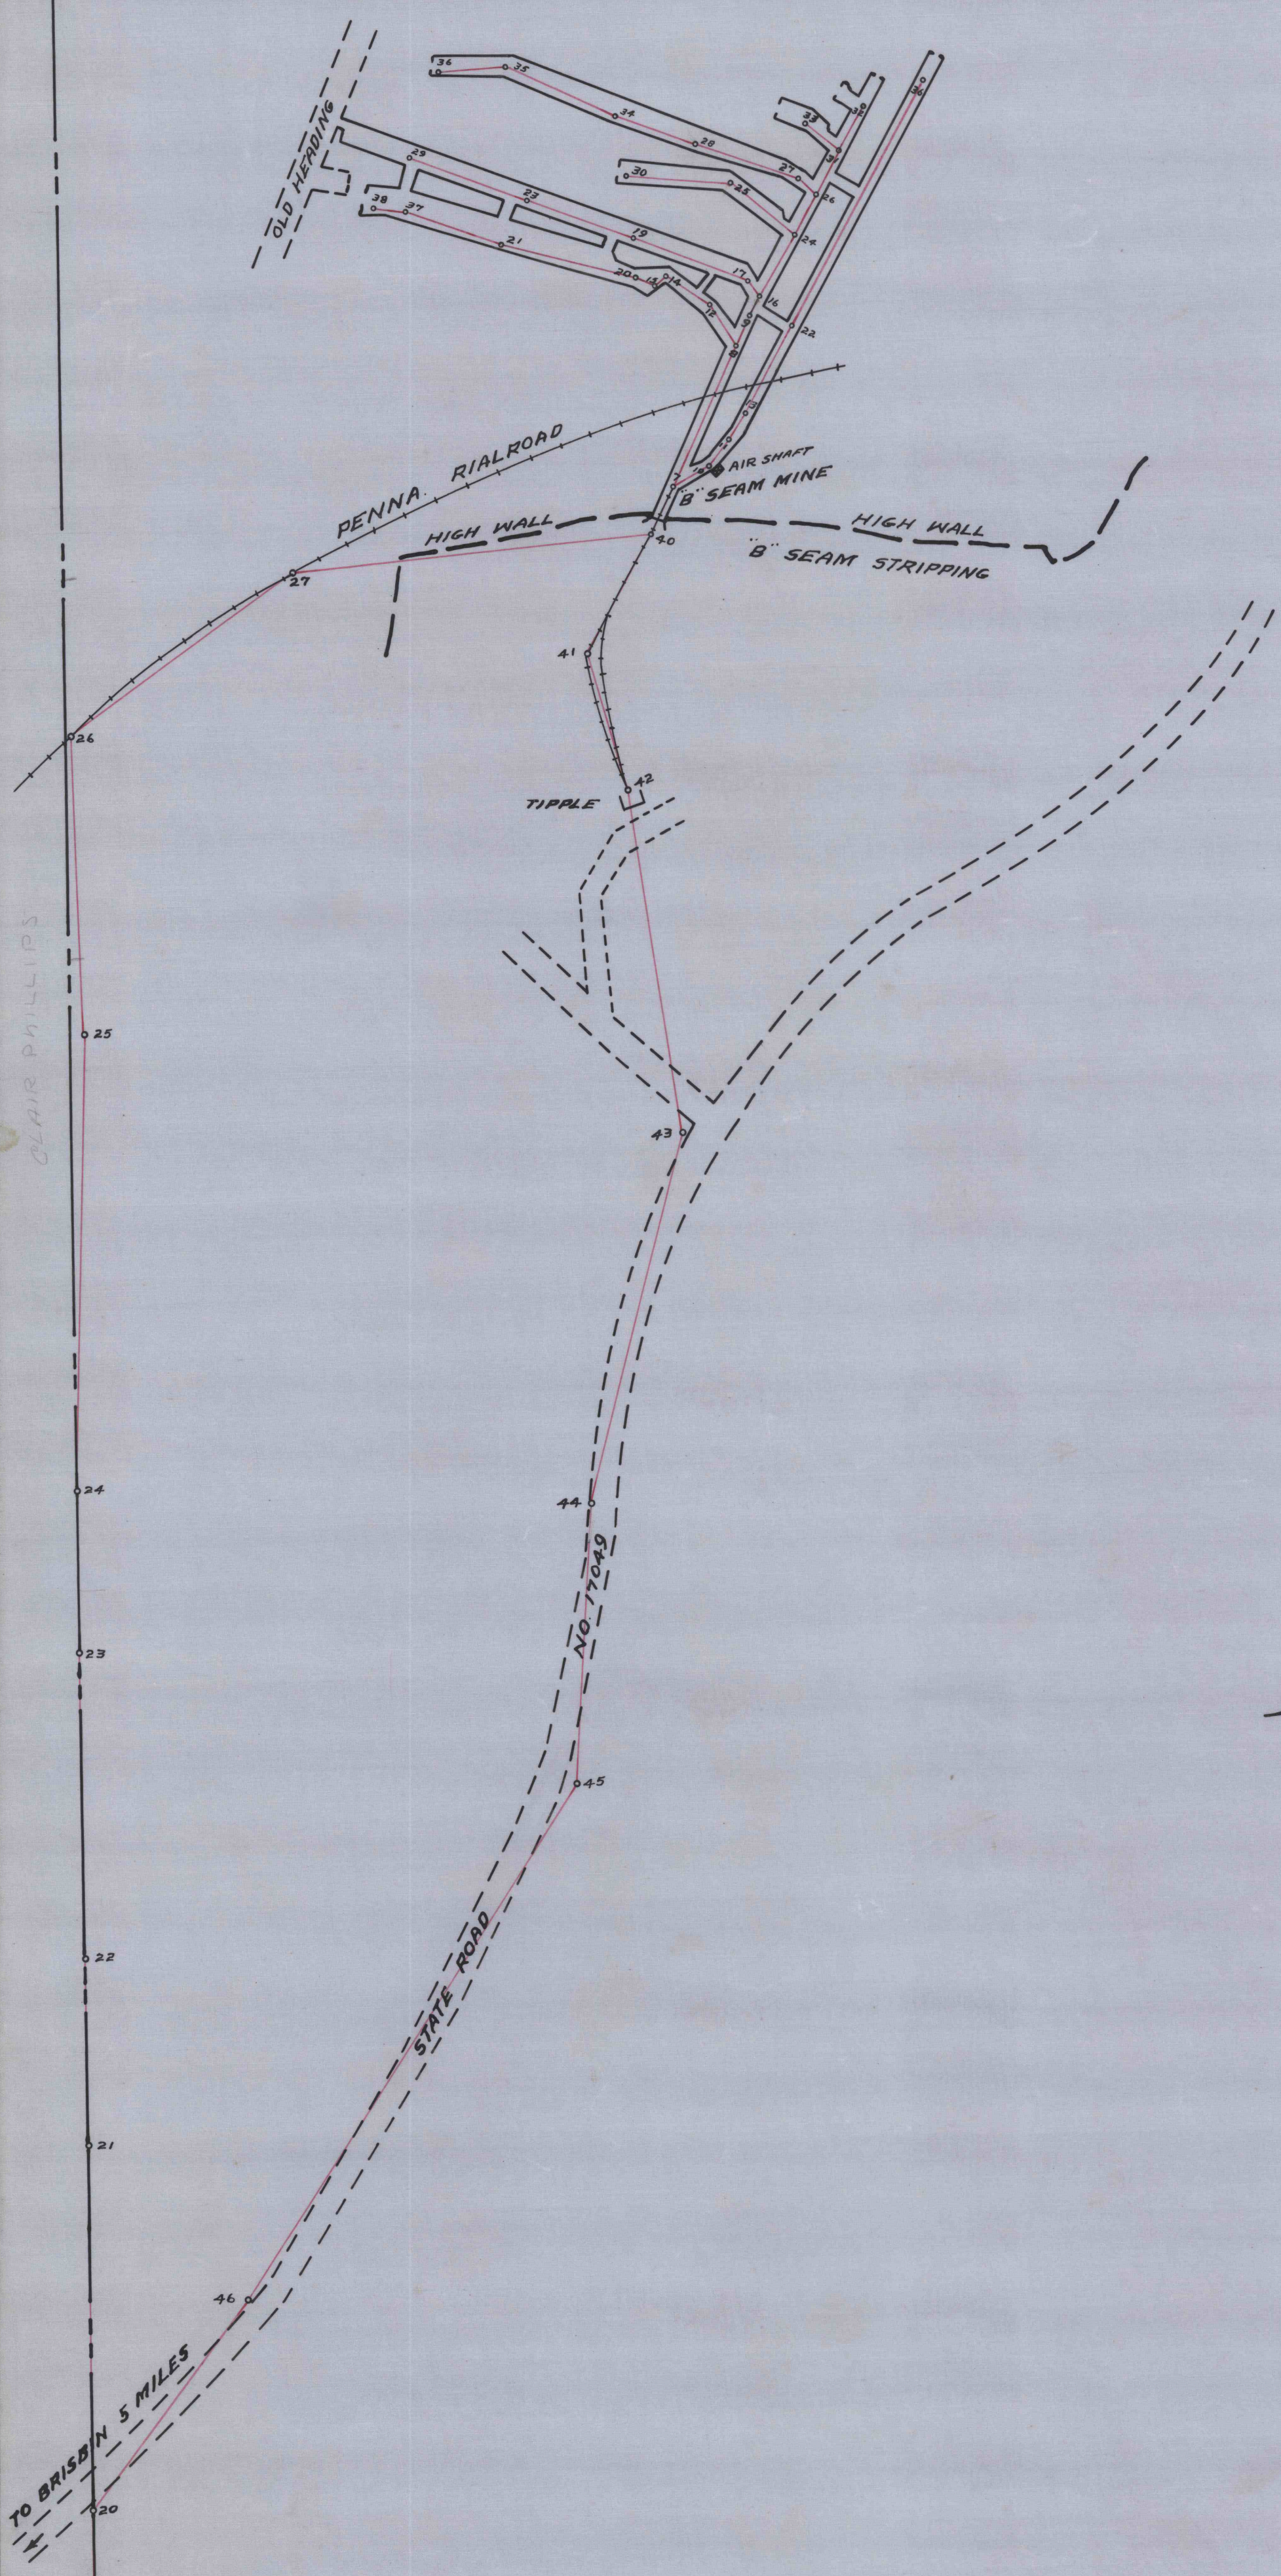

ALBERT KRAUSE

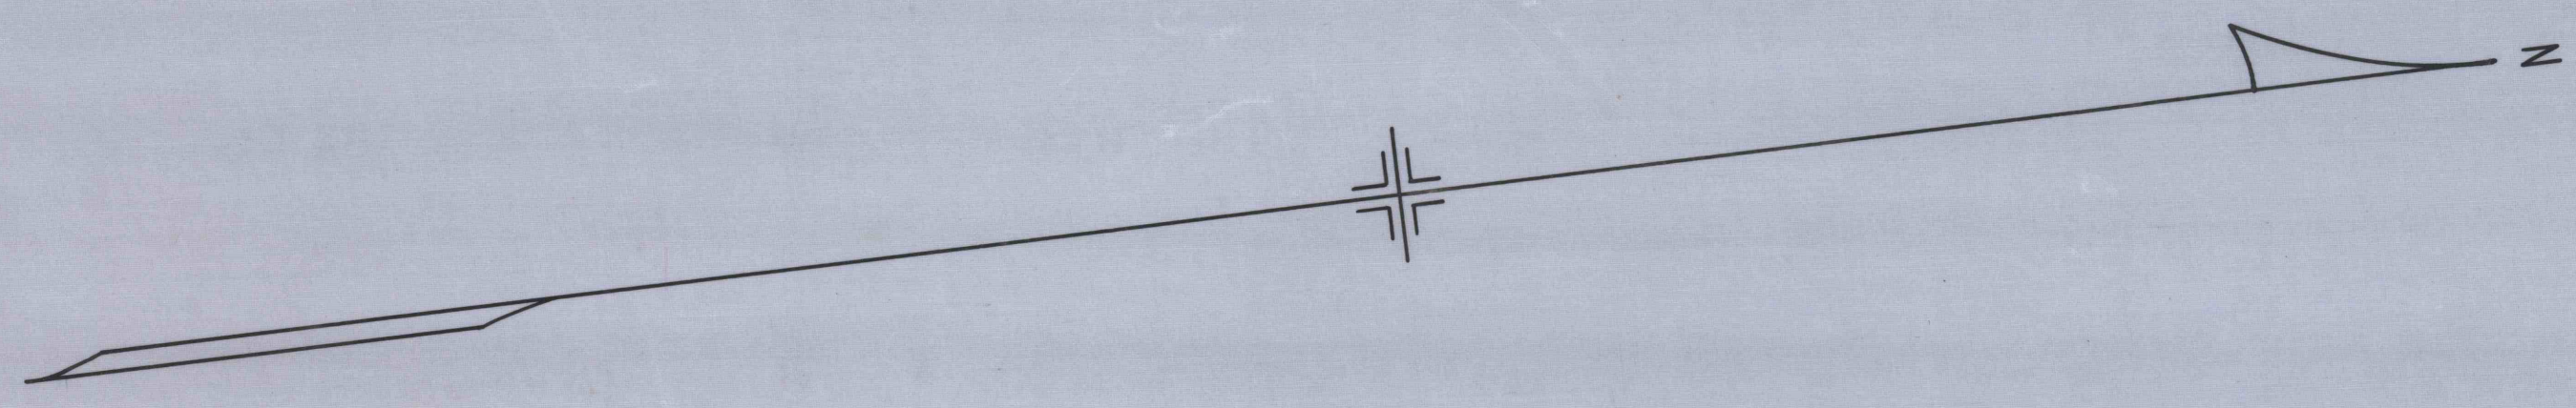

D
 — MAP OF ALBERT KRAUSE MINE —
 — DECATUR TWP. CLEARFIELD CO. PA. —
 — SCALE 1"=100' — DEC. 13, 1949 —
 — BERNARD LUCAS ENGR. —

G.D. 262

1147

PHILIPSBURG MAP & LAND CO.

1944