1945

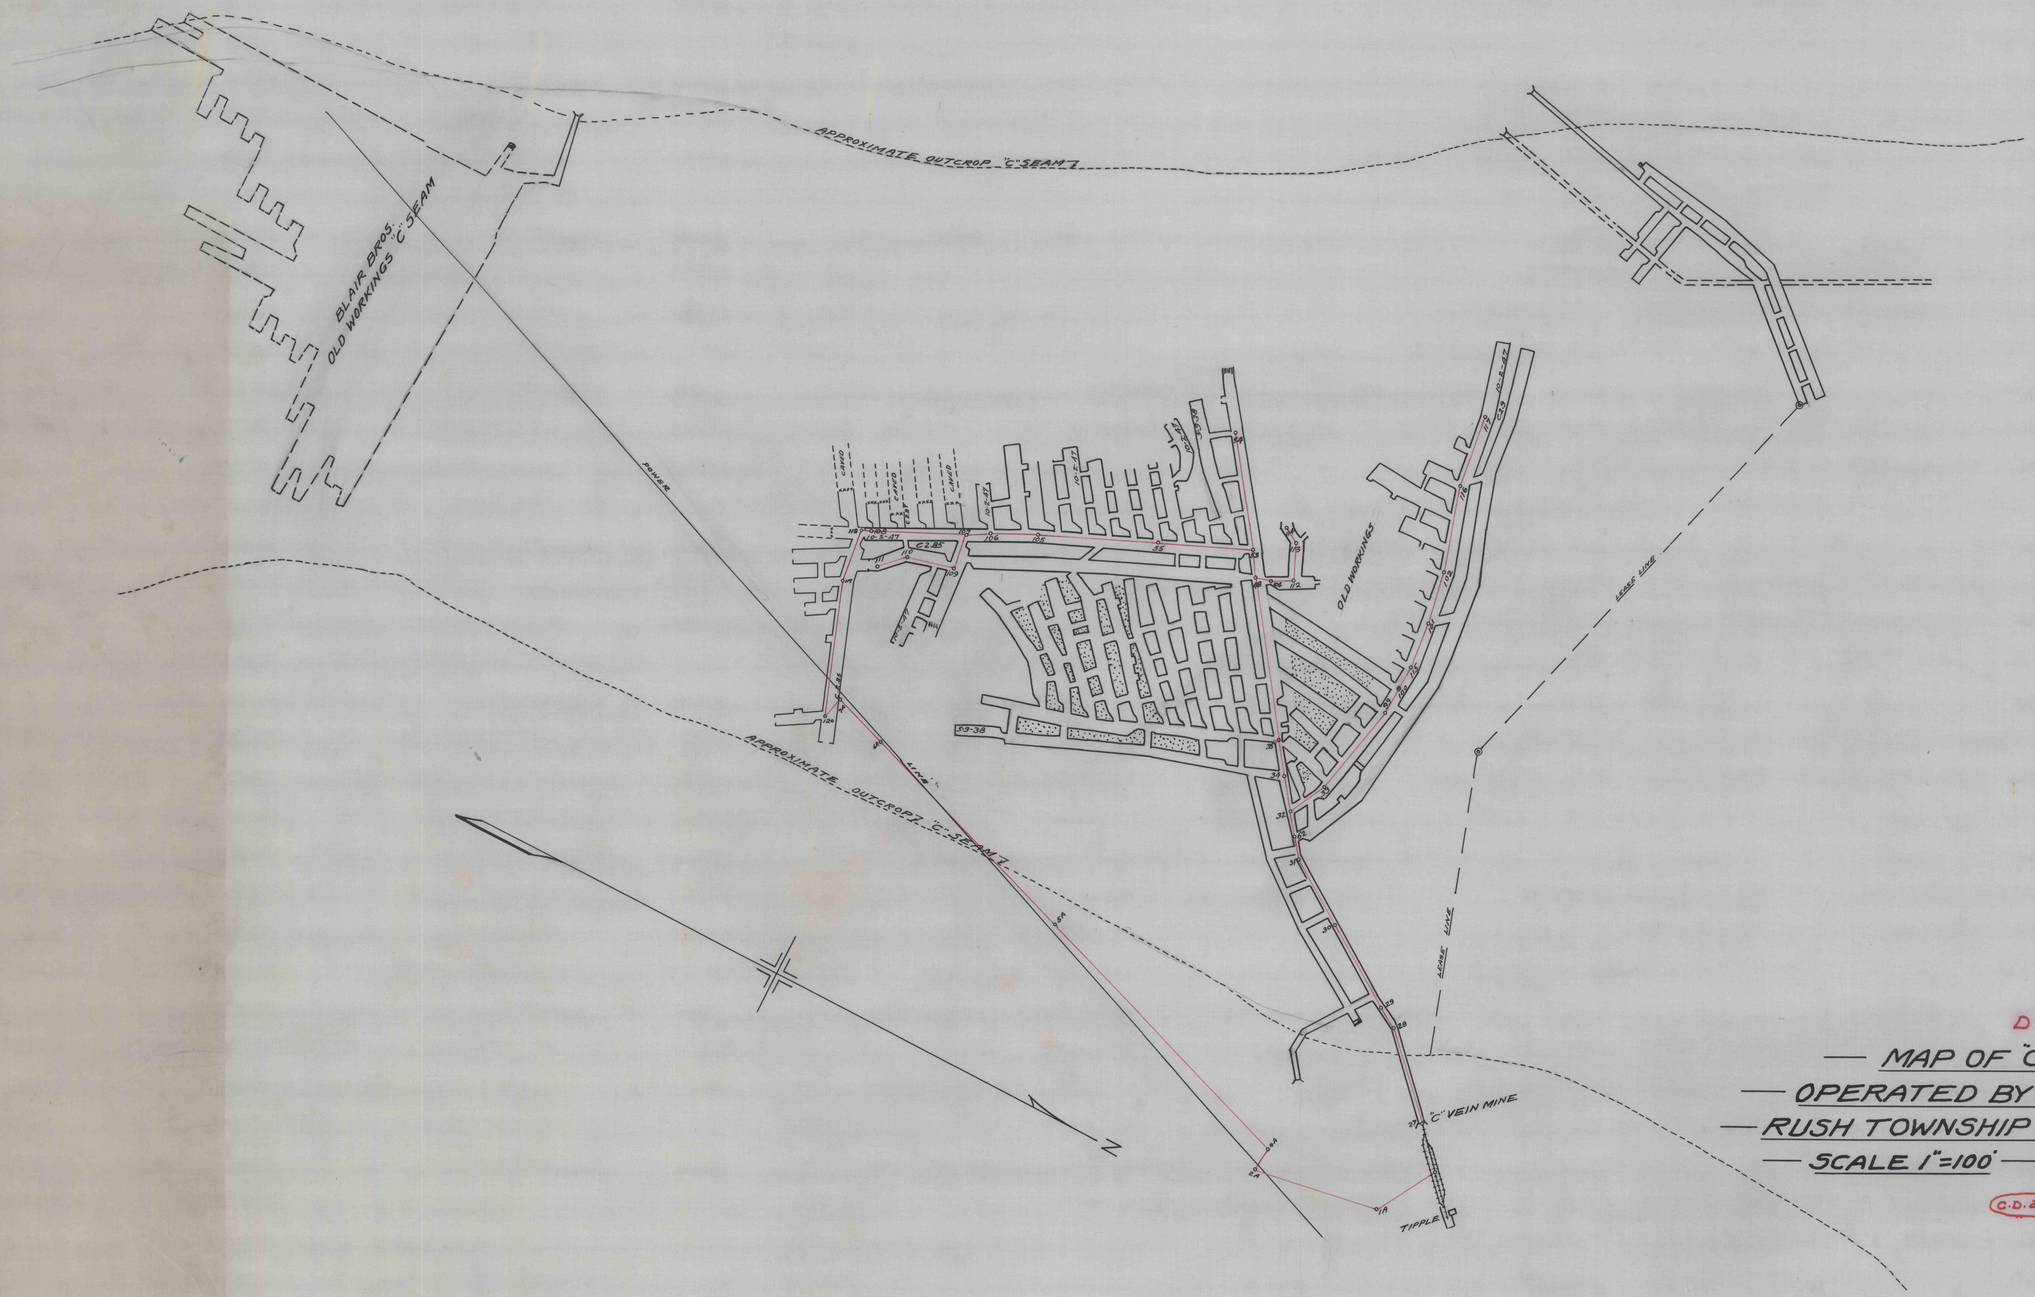

D

— MAP OF "C" VEIN MINE —

— OPERATED BY KATHLEEN HEATH —

— RUSH TOWNSHIP CENTRE COUNTY PA. —

— SCALE 1" = 100' — — NOV. 4, 1947. —

C.D. 279

Bernard Lucas
Thos. F. Morgan Engrs.

1042