


6661

1959

D

MAP SHOWING 'C' SEAM DEEP MINE
 OPERATED BY CARTWRIGHT & GALESKI
 DECATUR TWP CLEARFIELD COUNTY PA.
 BERNARD LUCAS ASSOC.

C.D. 401

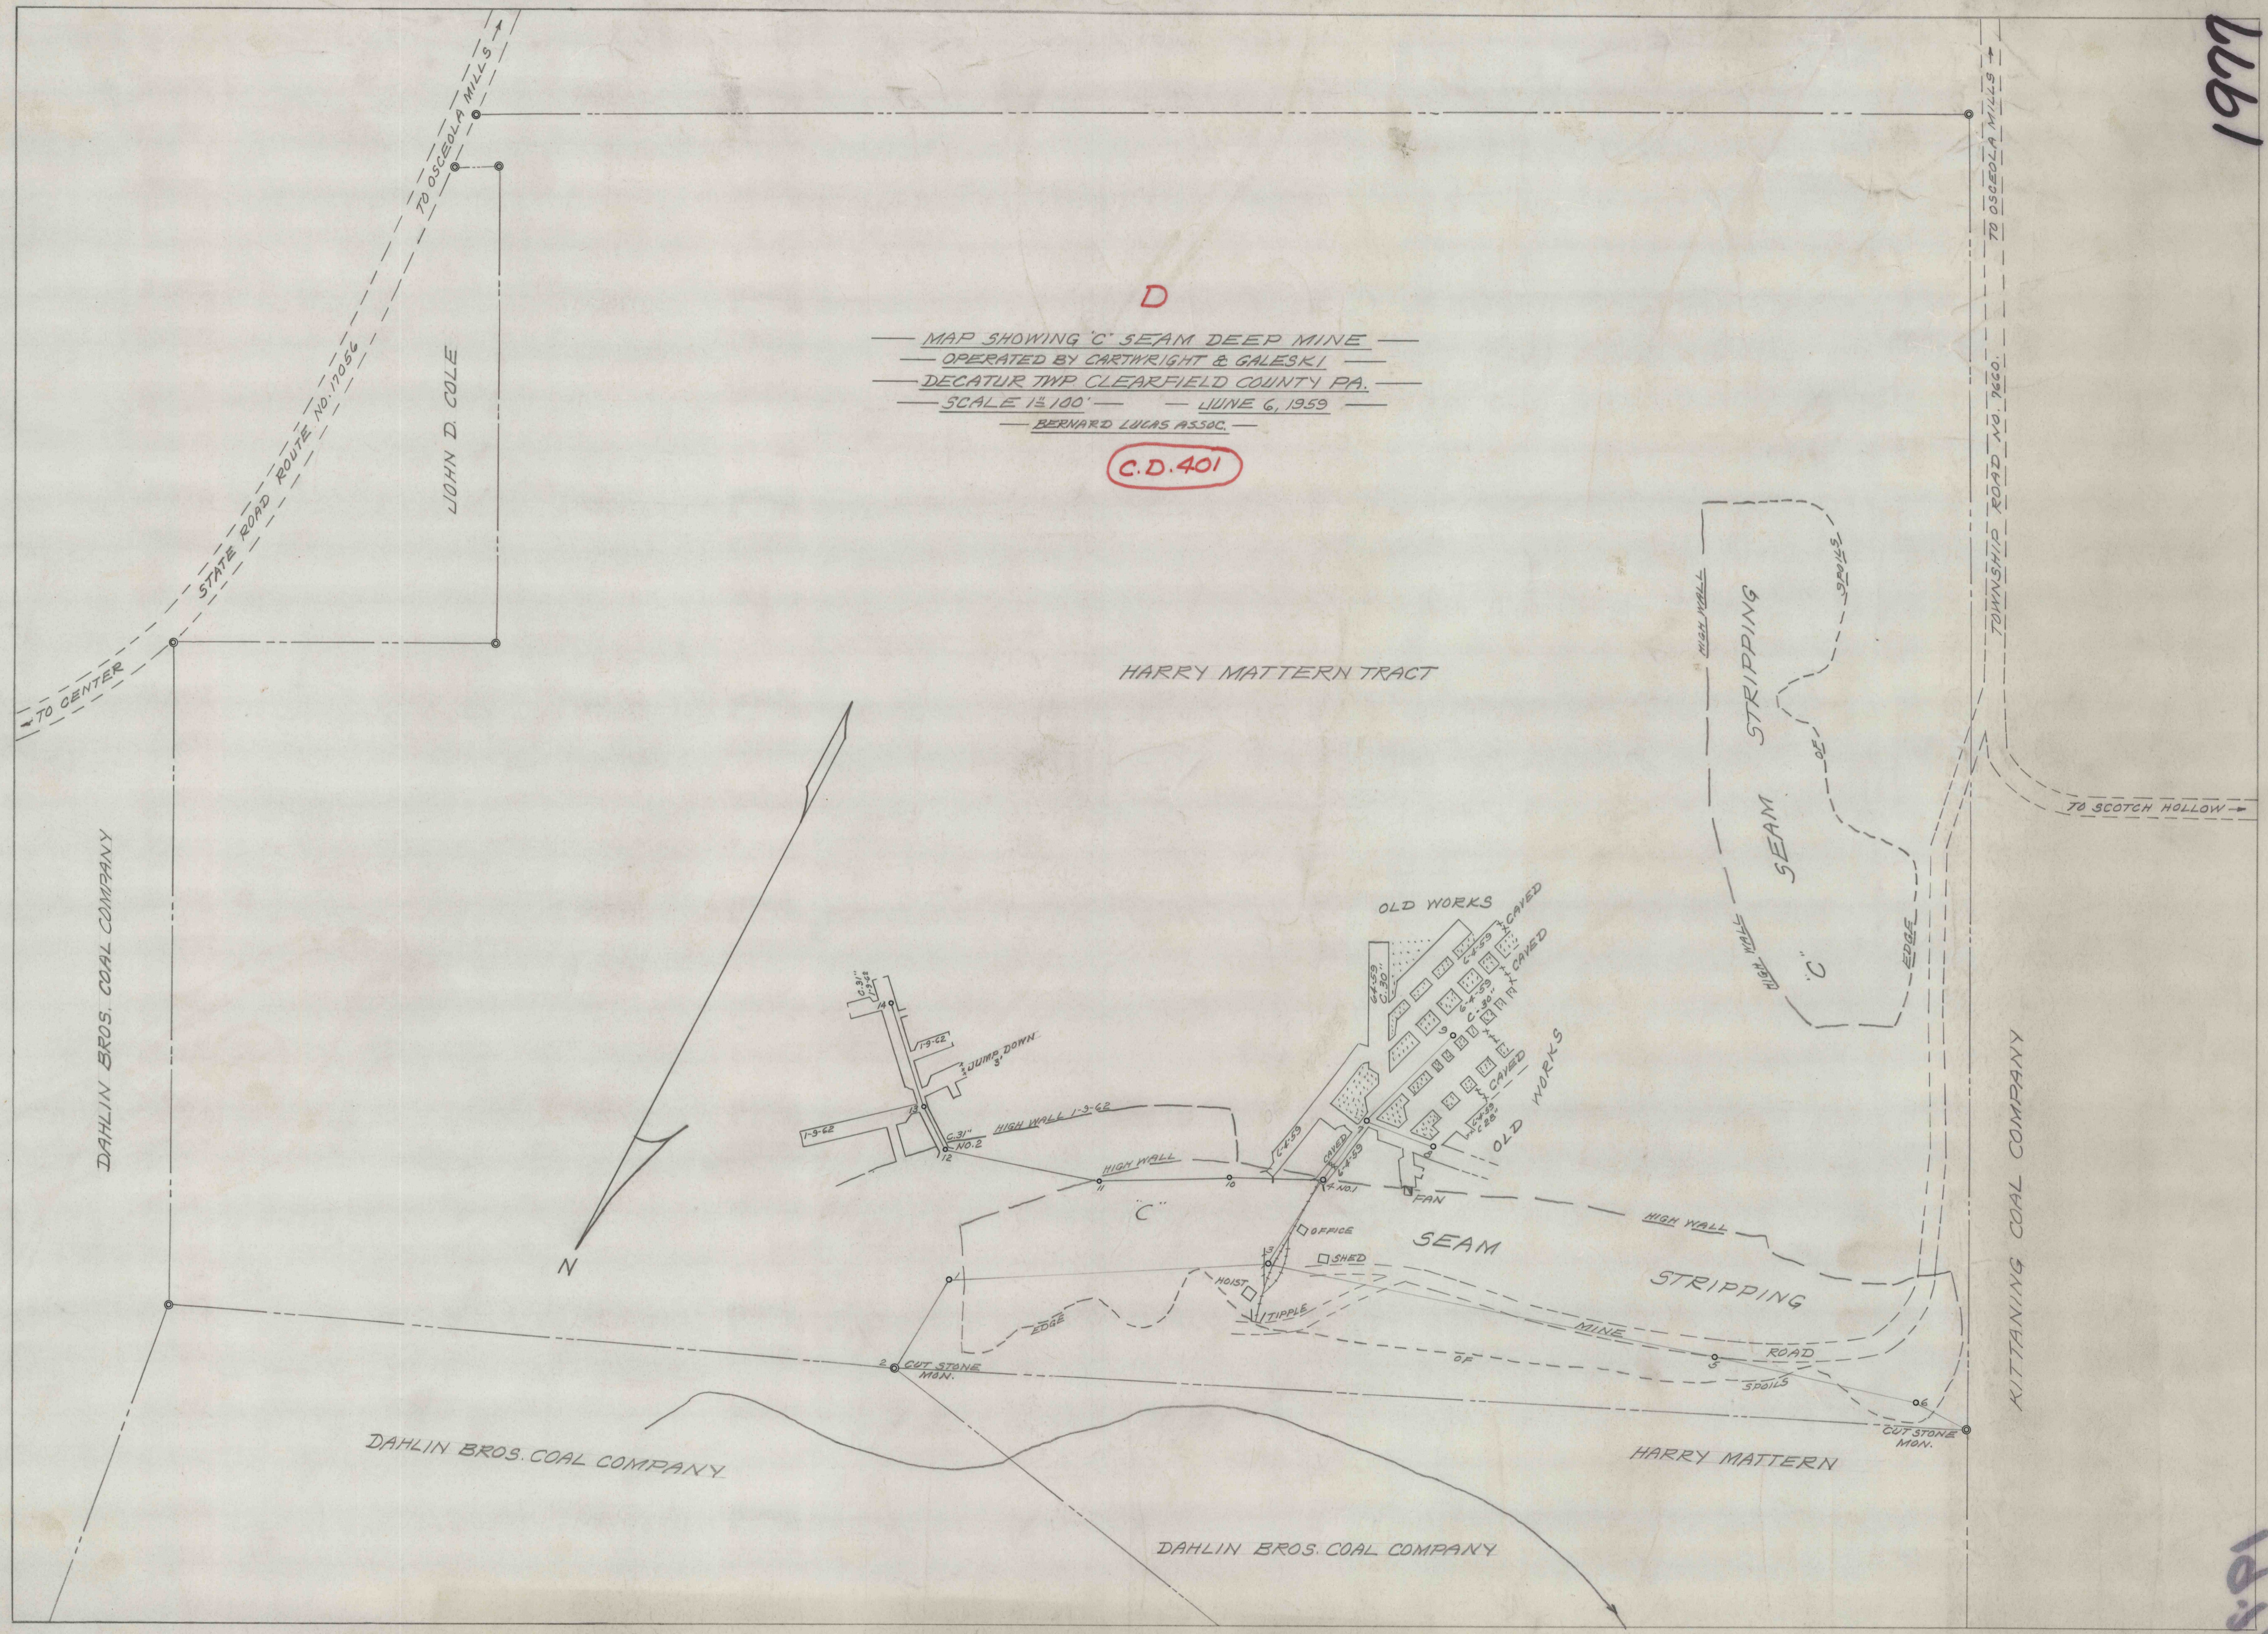

TO CENTER

STATE ROAD ROUTE No. 17056

JOHN D. COLE

HARRY MATTERN TRACT

TOWNSHIP ROAD NO. 1660

TO SCOTCH HOLLOW

DAHLIN BROS. COAL COMPANY

DAHLIN BROS. COAL COMPANY

DAHLIN BROS. COAL COMPANY

KITTTANING COAL COMPANY

HARRY MATTERN

N