

8105


JW POTTER

GEO EMERICK.

MAP
 OF
HORSE SHOE MINE
 OPERATED BY
Potter, Bigler & Potter.
 NEAR
 MARHAUS, CLEARFIELD Co., PENNA.
 Scale: 1 inch = 100 feet
 P.E. Womelsdorf, M.E.
 March 8th 1906.

EXTENDED OCT-9-1906
 Feb-20-08
 " May-18-10
 " Mar-8-11
 " Aug-23-11
 " MAY 6-0, 1912
 E.W. Hess, Engr.

977

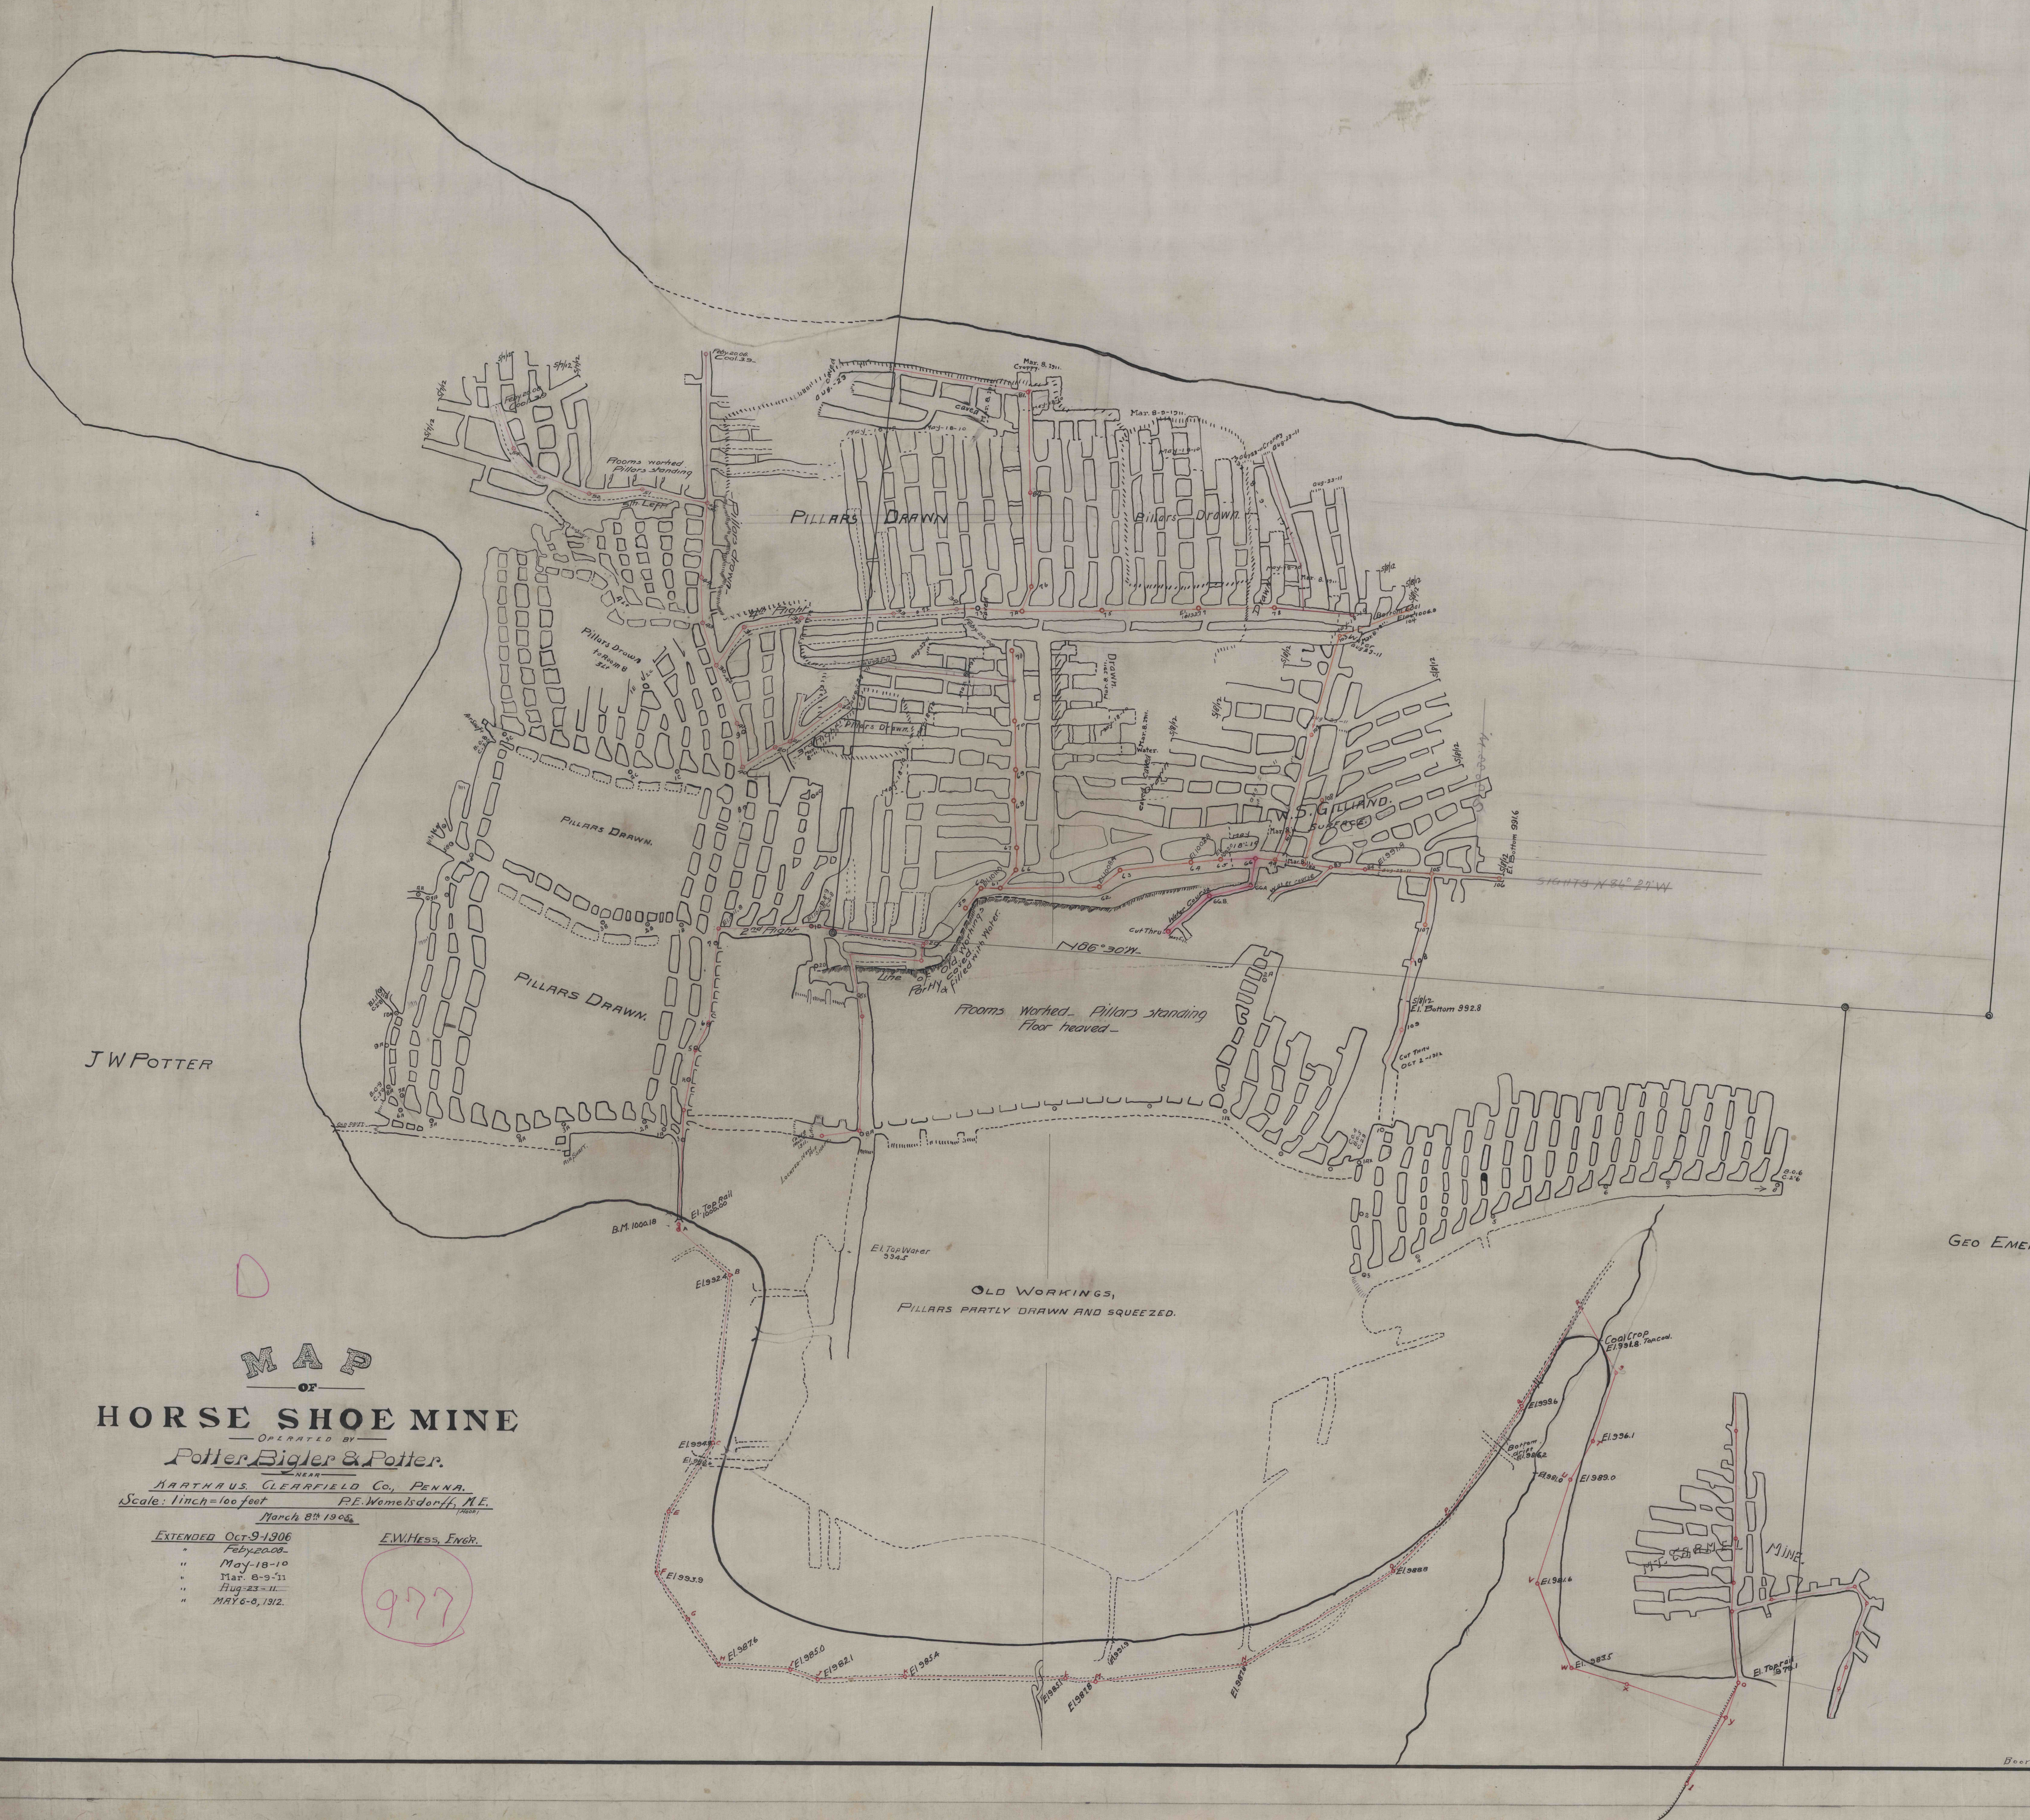

2019

Scale 57-5"