


G.L.Reed.

JOS. L. MITCHELL.

C.C. W.C. Operation

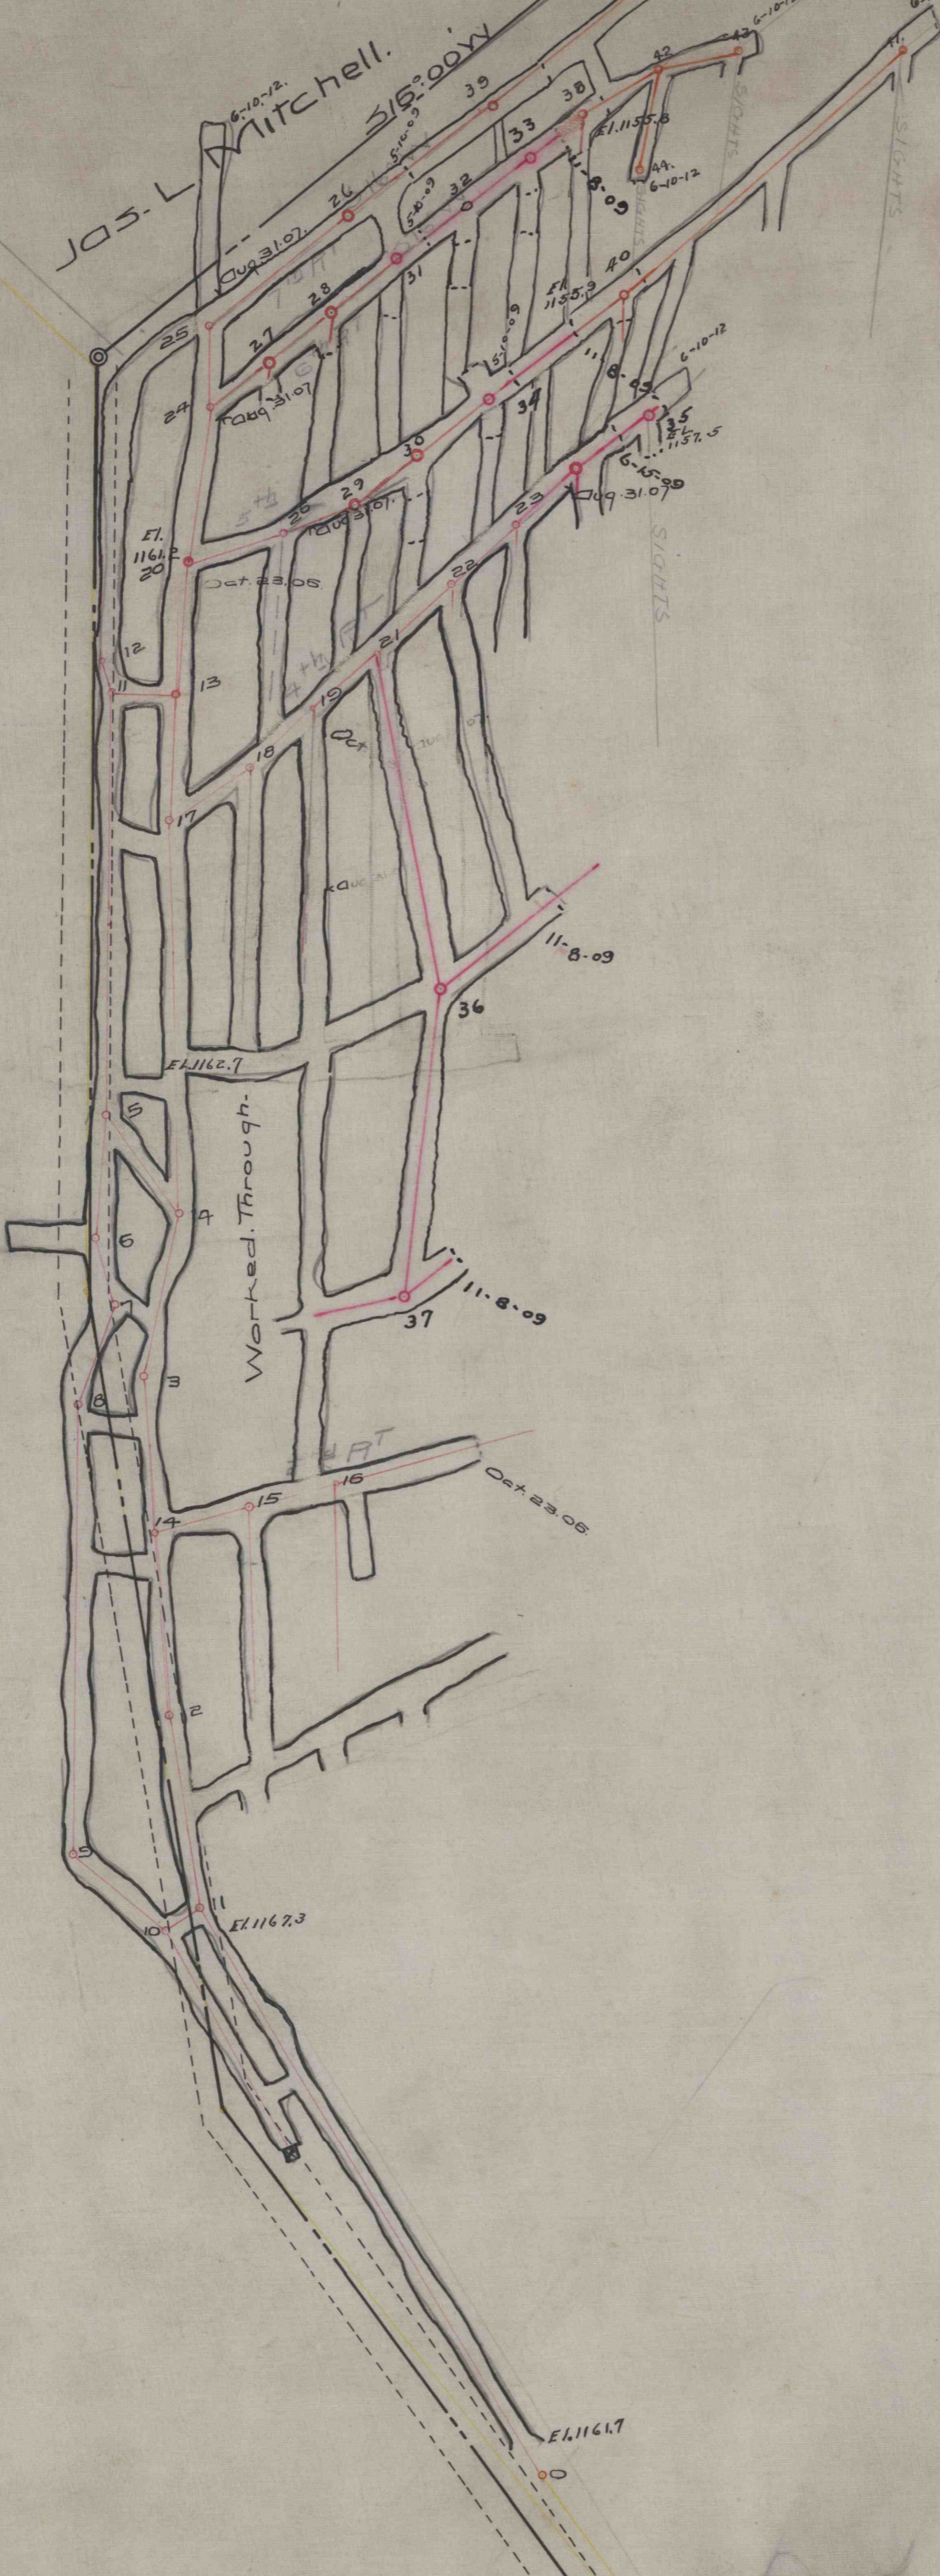

Survey of Clay Mine.

leased by

Standard Brick and Tile Co.

Lawrence Township, Clearfield Co.

Clearfield, Pa.
Nov. 29, 06.

Scale 1"=100'

E.W. Hess,
Engineer.

Resurveyed

May-10-09

Nov.-8-09

Aug.-10-10

JUNE-10-1912.

981

Right of Way

Right of Way

To Clearfield

T.C.D.W.

To Currensville

SUSQUEHANNA RIVER

J.A.A.
Book 25

2031

5031