




MAP SHOWING THE PROPERTY OF
THE PATERSON CLAY PRODUCTS CO.
 CLEARFIELD, PA.

SCALE 1" = 100'

CLEARFIELD, PA.
 SEP. 17-1909
 Resurveyed June 22-1909
 Oct. 11-1909
 Feb. 4-1911
 Dec. 4-1911
 MAR. 2-1912
 Aug. 5-1912

E.W. HESS,
 ENGINEER.

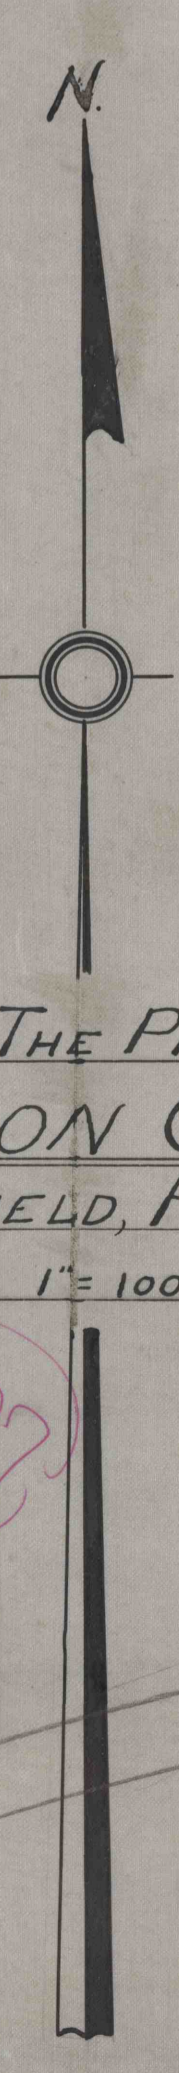

987

ROYCE HIDE
 LOTS