

CASSIDY COAL CO.

M. BAILEY
EST.

JAS. M. PIERSON

2040



ROBERT LAWRENCE ESTATE

OP


MAP OF COAL MINE
 OPERATED BY
 GUY SHAW & CHAS. BOSS.
 IN LANDS OF
 CLEARFIELD STEEL & IRON CO.
 HYDE CITY LAYBENCE TYP. CLEARFIELD Co. PA.
 SCALE 1"=100'

CLEARFIELD PA.
 APRIL 13-1914.
 RESURVEY
 MARCH-23-1912
 AUGUST-20-1912
 APRIL 12-1918.
 NOVEMBER-1918.

SERIES 22 E. Y. H. 1125
 EDWARDS.

987-B

Yves Hoover

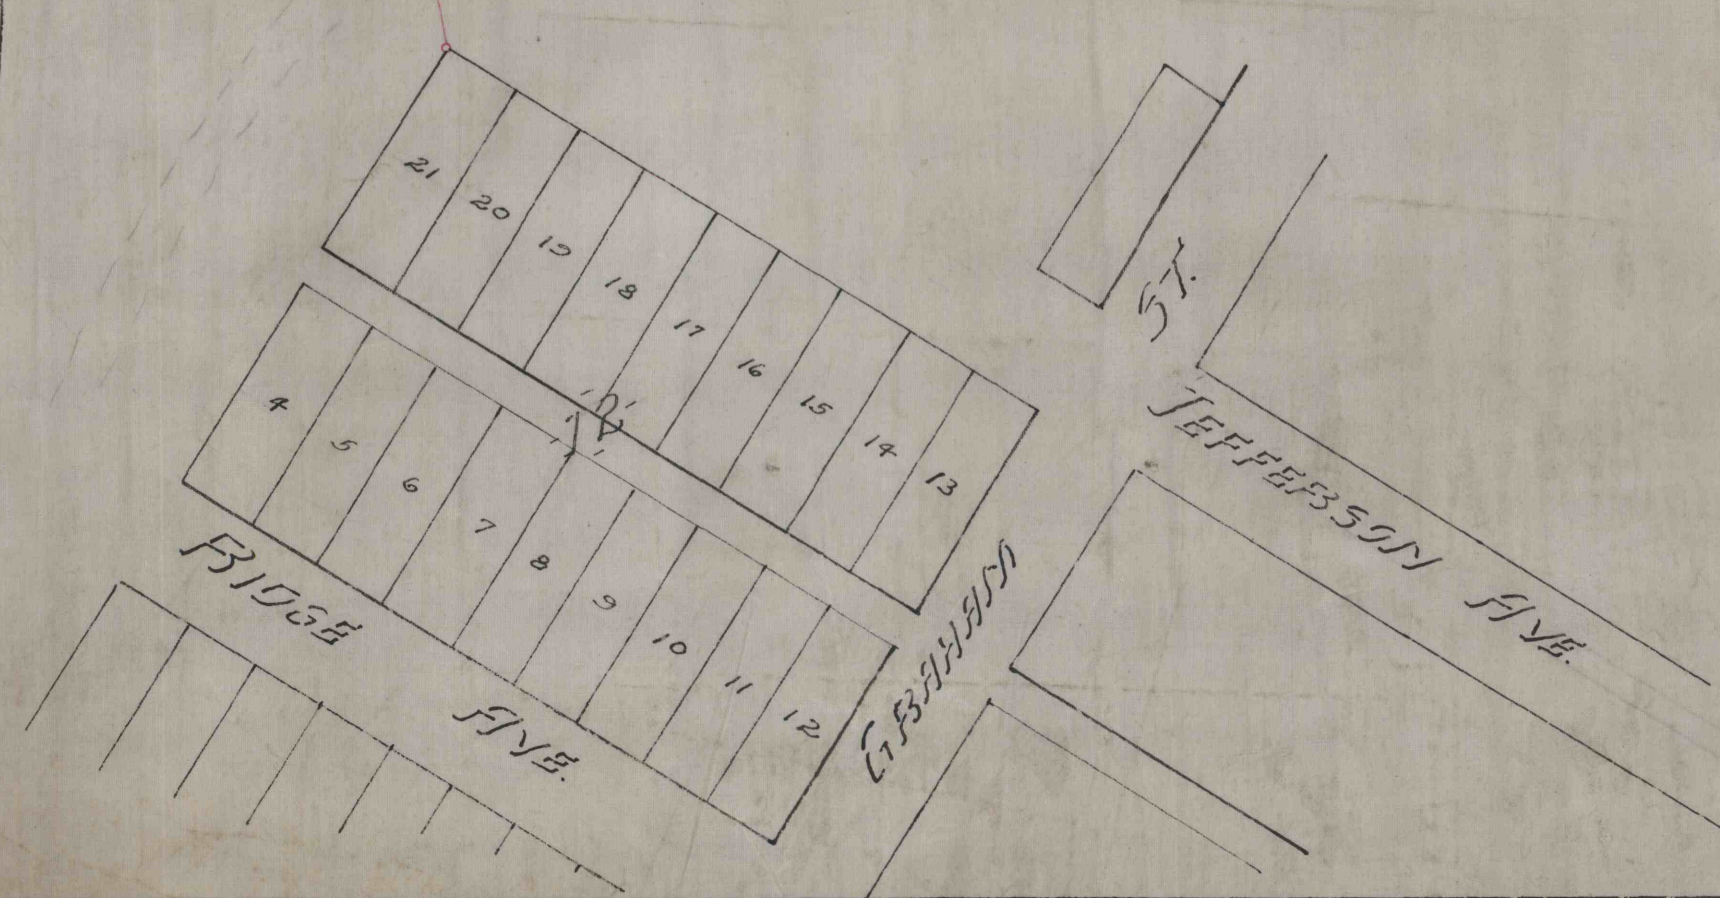

2040