8868

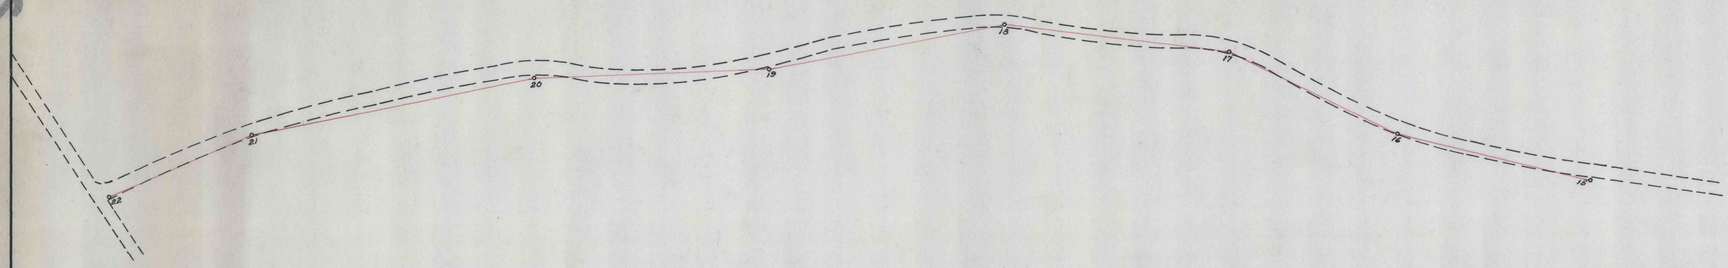

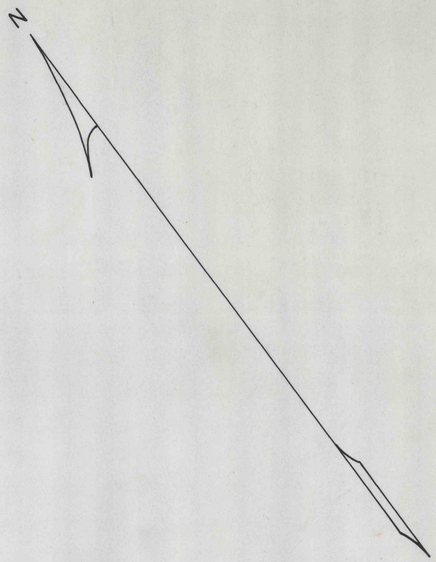

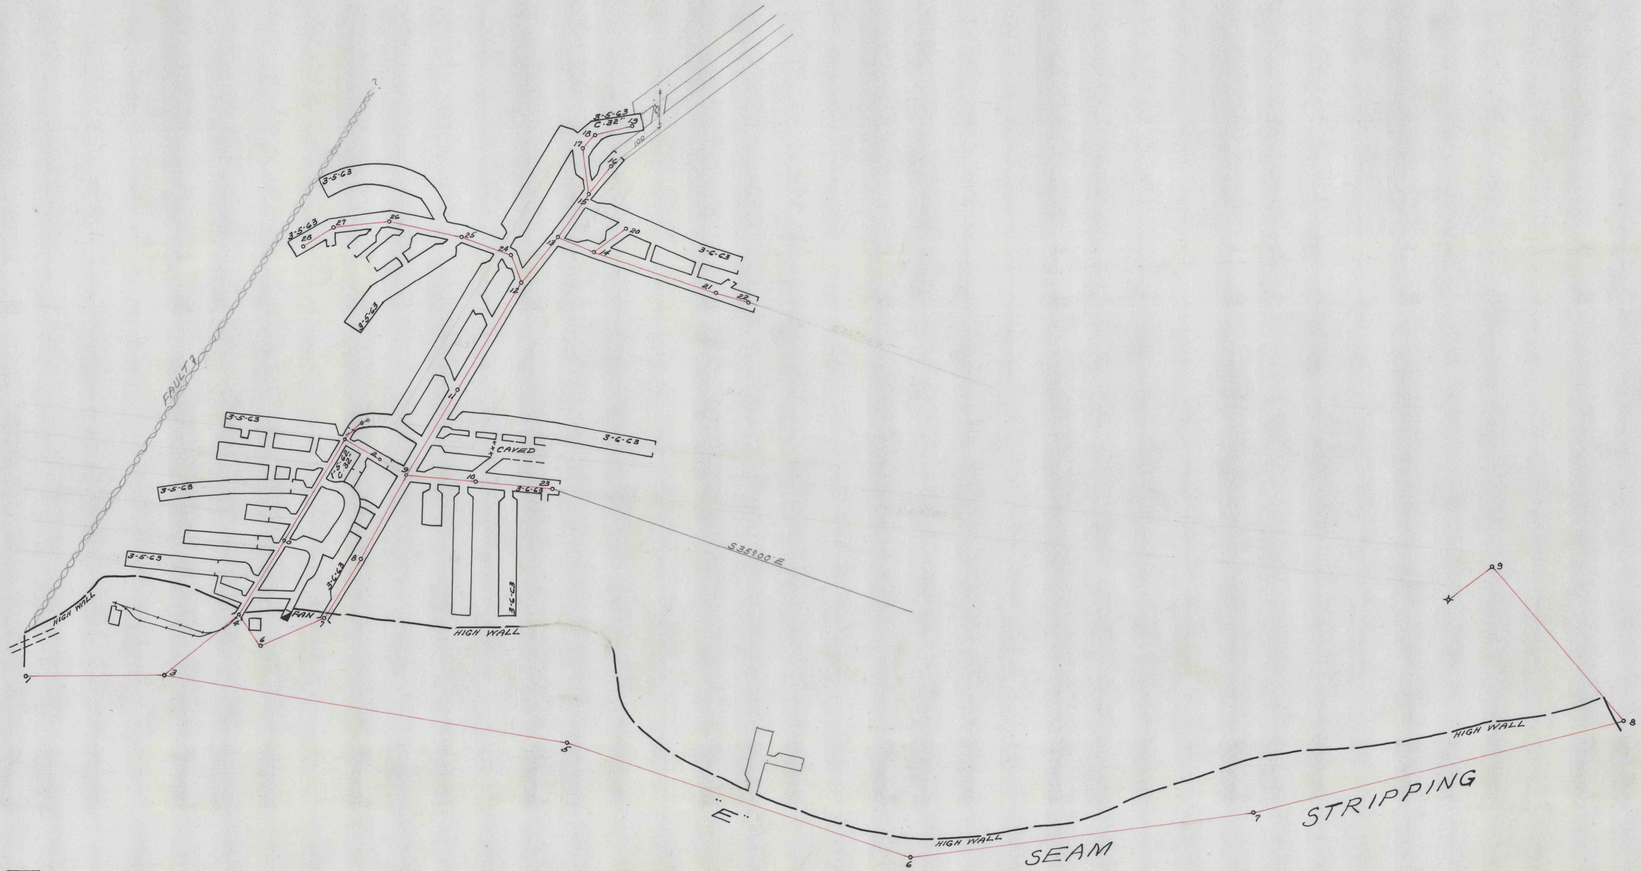

D

MAP OF "E" SEAM MINE ON H. H. ROWLAND TRACT
OPERATED BY JULIANA COAL COMPANY
WOODWARD TWP. CLEARFIELD COUNTY PENNA.
SCALE 1" = 100' — JAN. 5, 1962
BERNARD LUCAS ASSOCIATES

C.D. 600

2088