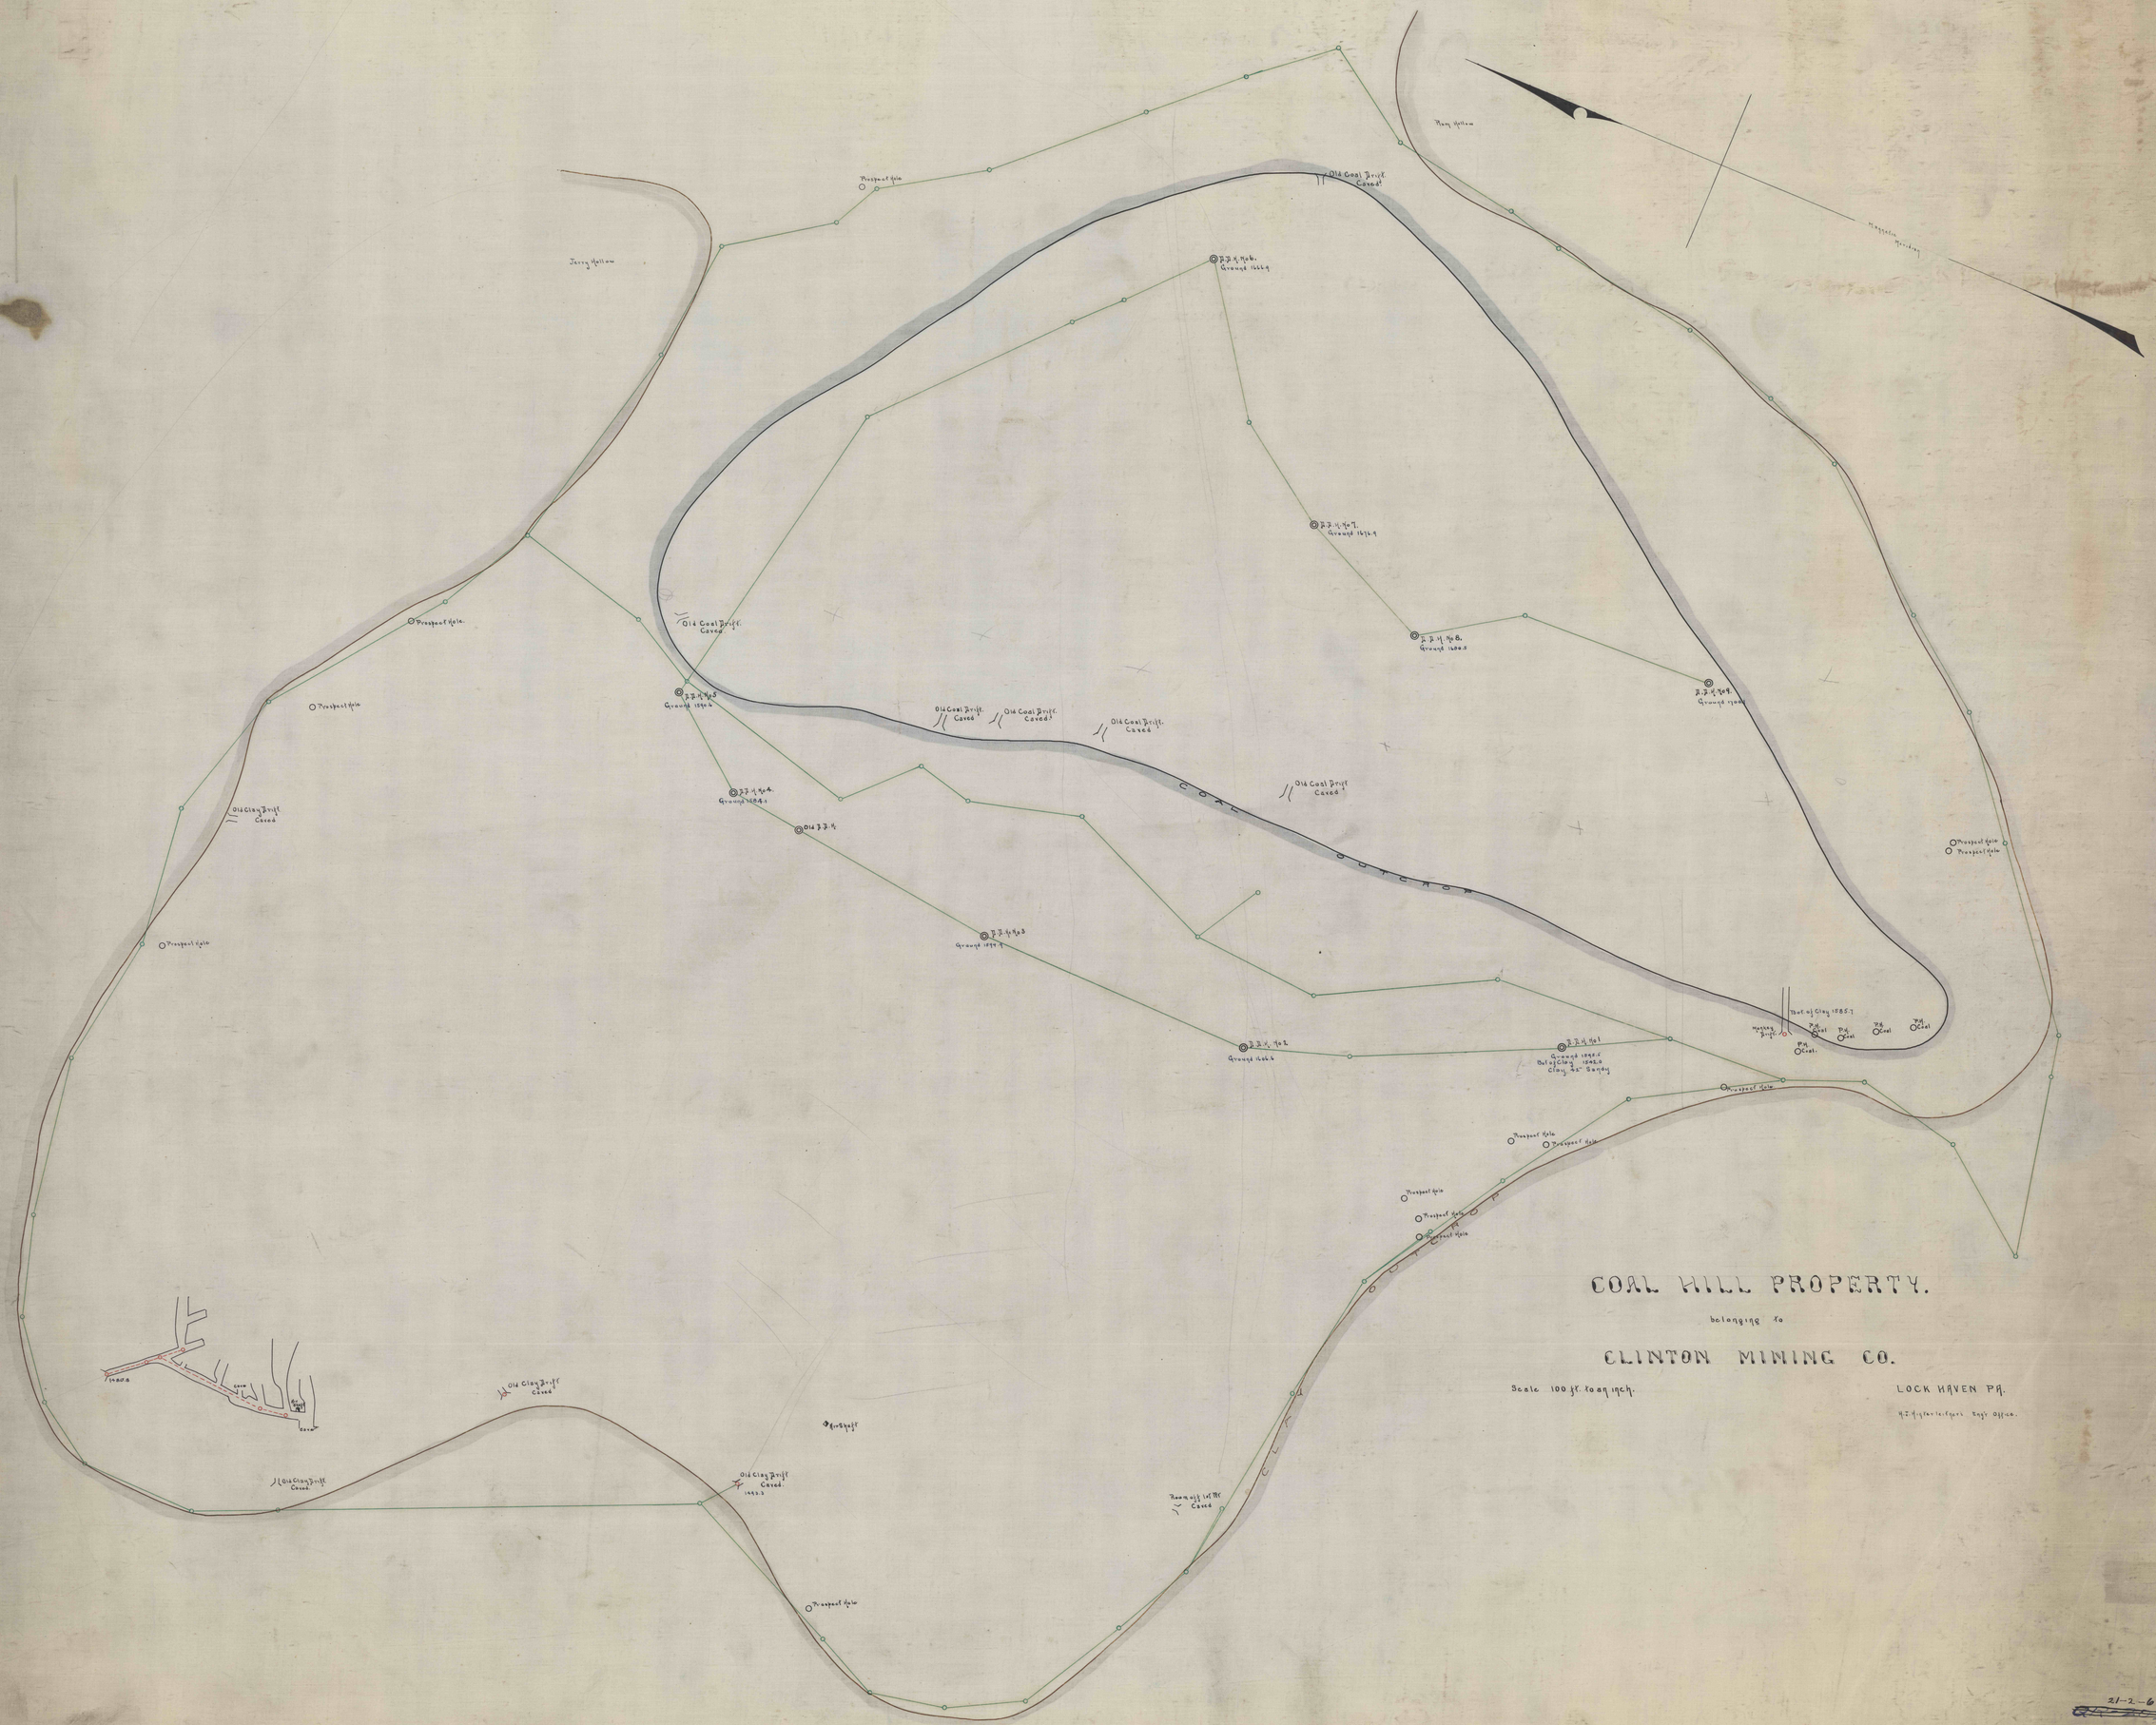
Jerry Hollow
Prospect Hole
Old Coal Drift Caved
Old Clay Drift Caved
Old Clay Drift Caved.
Grange 1894.4
Old Clay 1842.0
Clay 1st Sandy
Roof of Clay 1885.7
Mining Drift
Pit Coal
Pit Coal.
Pit Coal
Pit Coal
Pit Coal
Pit Coal
Room off 1st Pitch Caved
Old Clay Drift Caved.
1880.0
Cave
Cave
Cave
COAL HILL PROPERTY.
belonging to
CLINTON MINING CO.
Scale 100 ft. to an inch.
LOCK HAVEN PA.
H.F. Fisher Civil Engr. Engr. Office.

21-2-6-1