

KYLERTOWN

STATE HIGHWAY ROUTE NO. 17067


TO SYLVAN GROVE

JOHN ERICKSON

JAMES L. REICHARD

ANDERSON LUTZ
NOW
RIVER HILL

JACKSON HOOVER

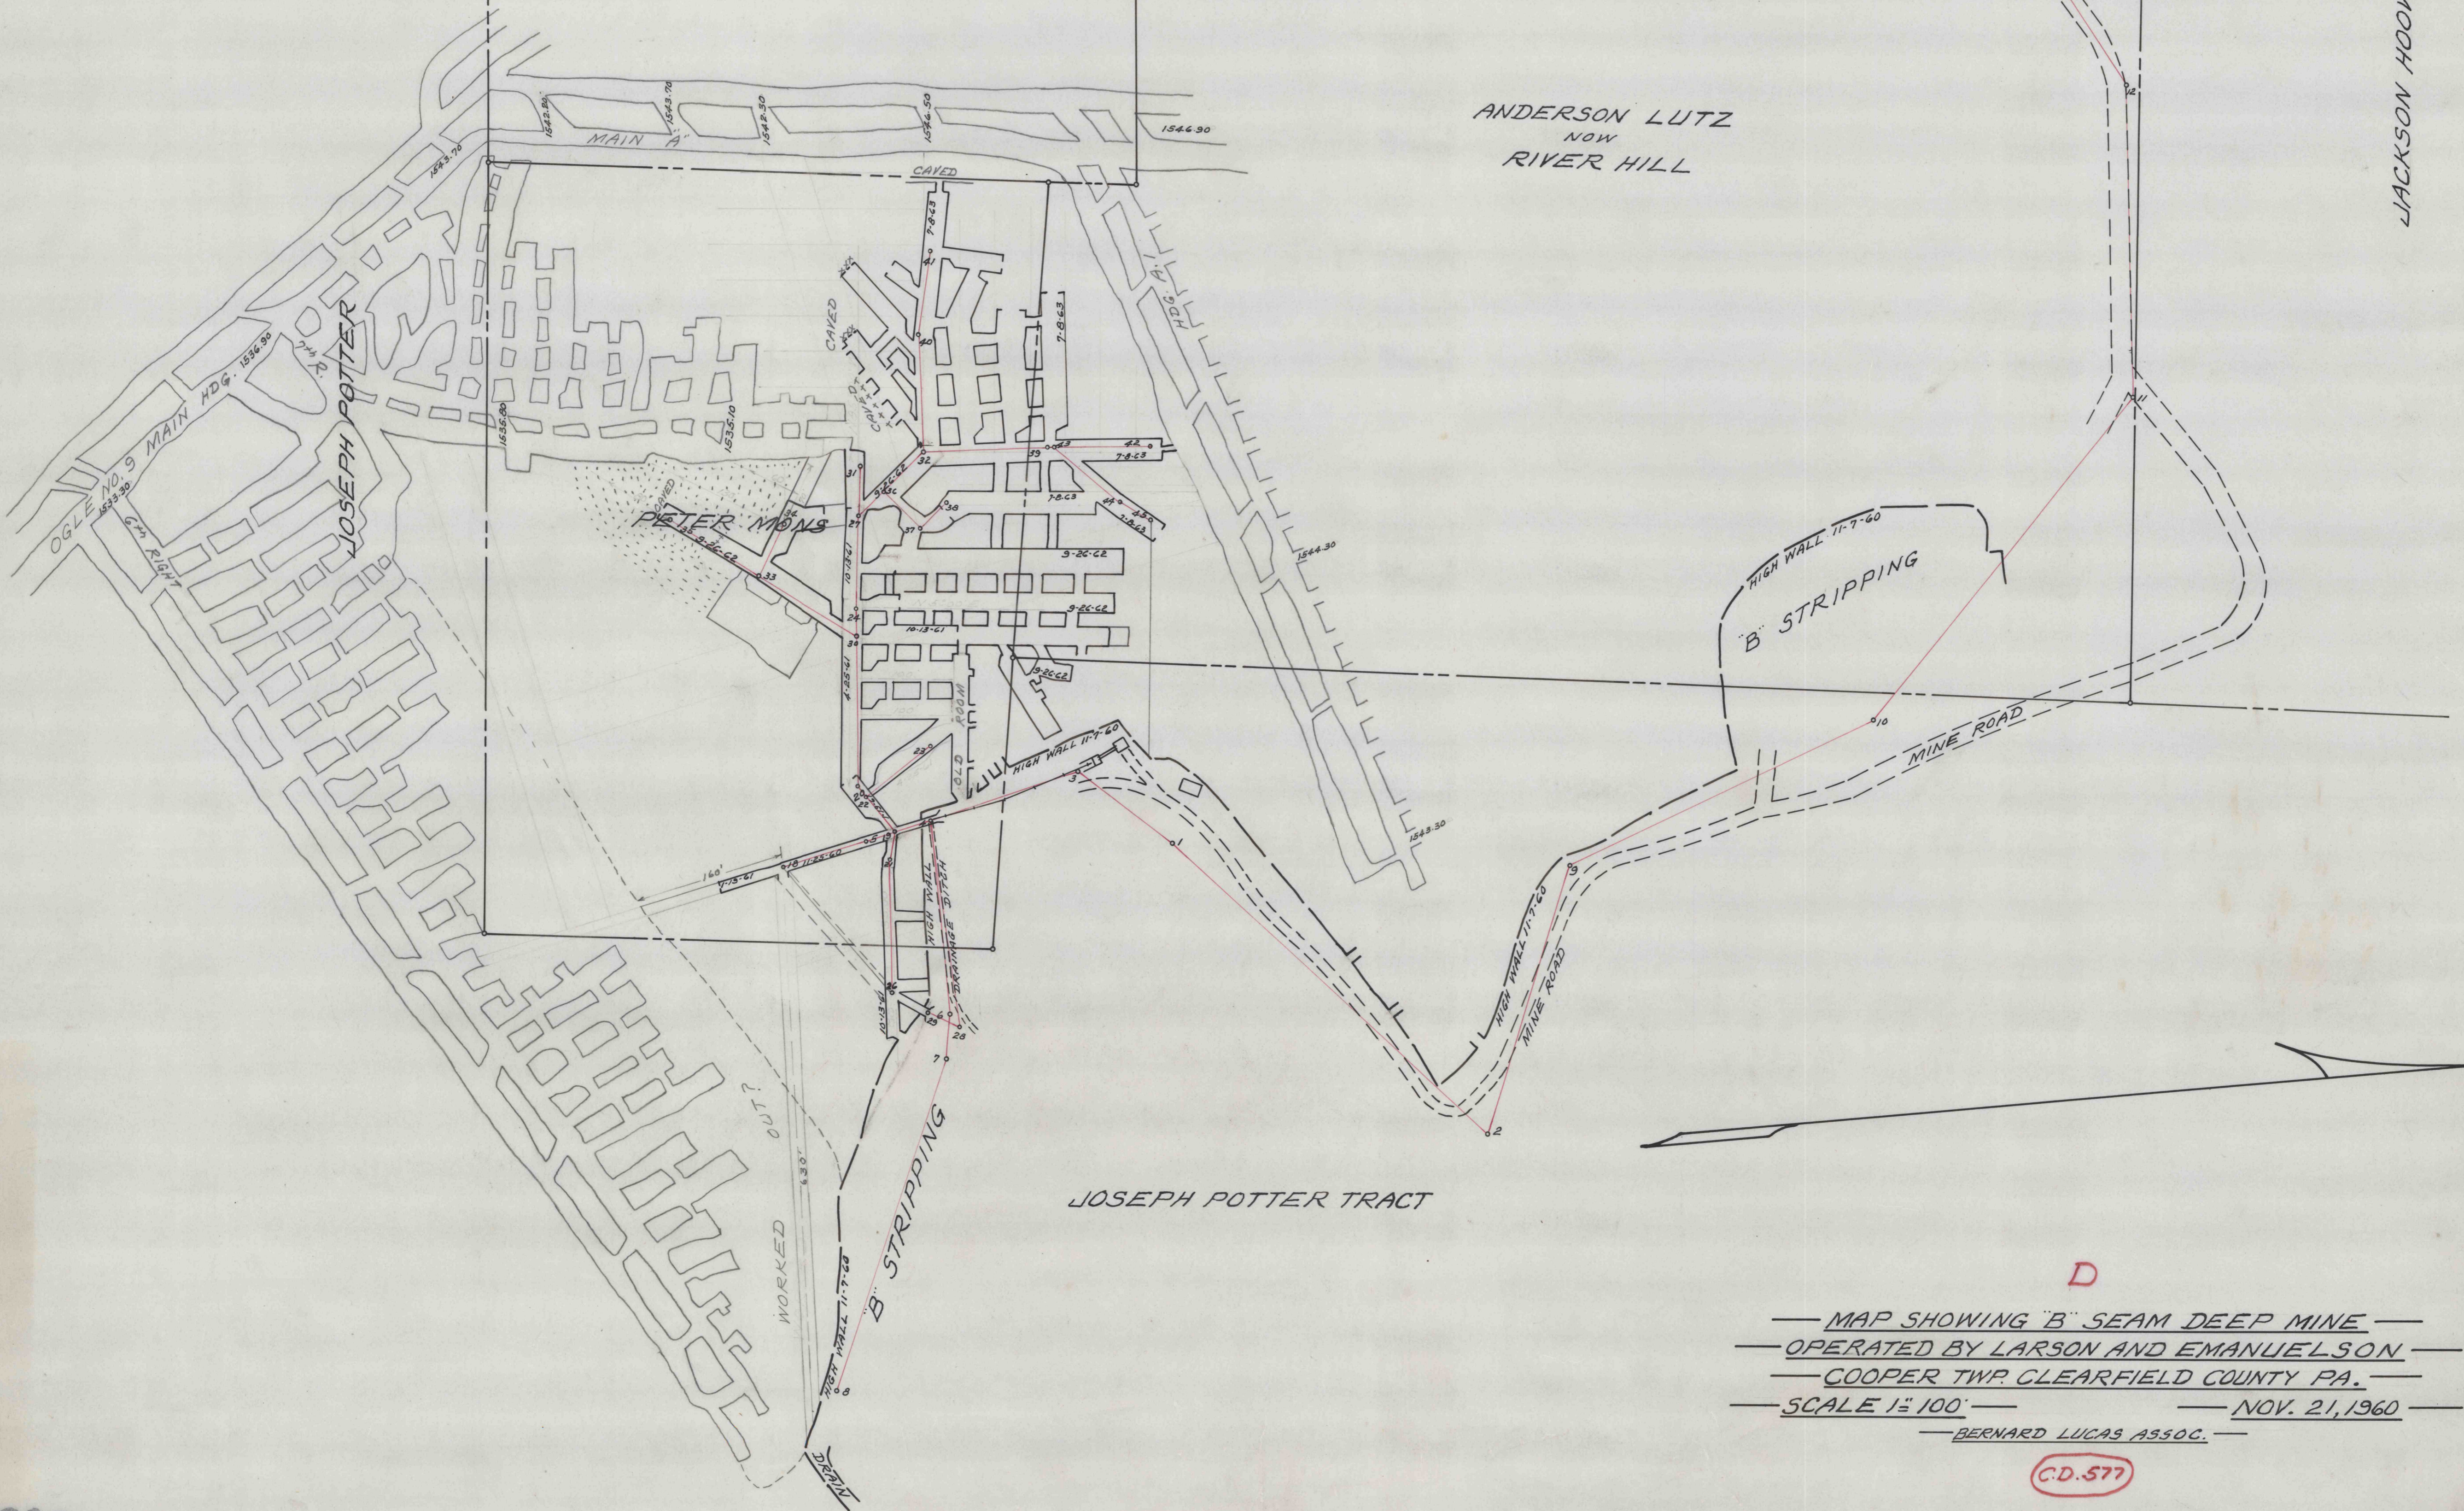

D

— MAP SHOWING "B" SEAM DEEP MINE —
 — OPERATED BY LARSON AND EMANUELSON —
 — COOPER TWP. CLEARFIELD COUNTY PA. —
 — SCALE 1" = 100' — NOV. 21, 1960 —
 — BERNARD LUCAS ASSOC. —

C.D. 577

2012

2102