


J.F. STEINER ESTATE  
F.G. HOFFER AGENT

J.F. STEINER ESTATE  
F.G. HOFFER AGENT

BEAVER ESTATE

WOMELSDORF & DUNKLE  
G.F. DUNKLE AGENT

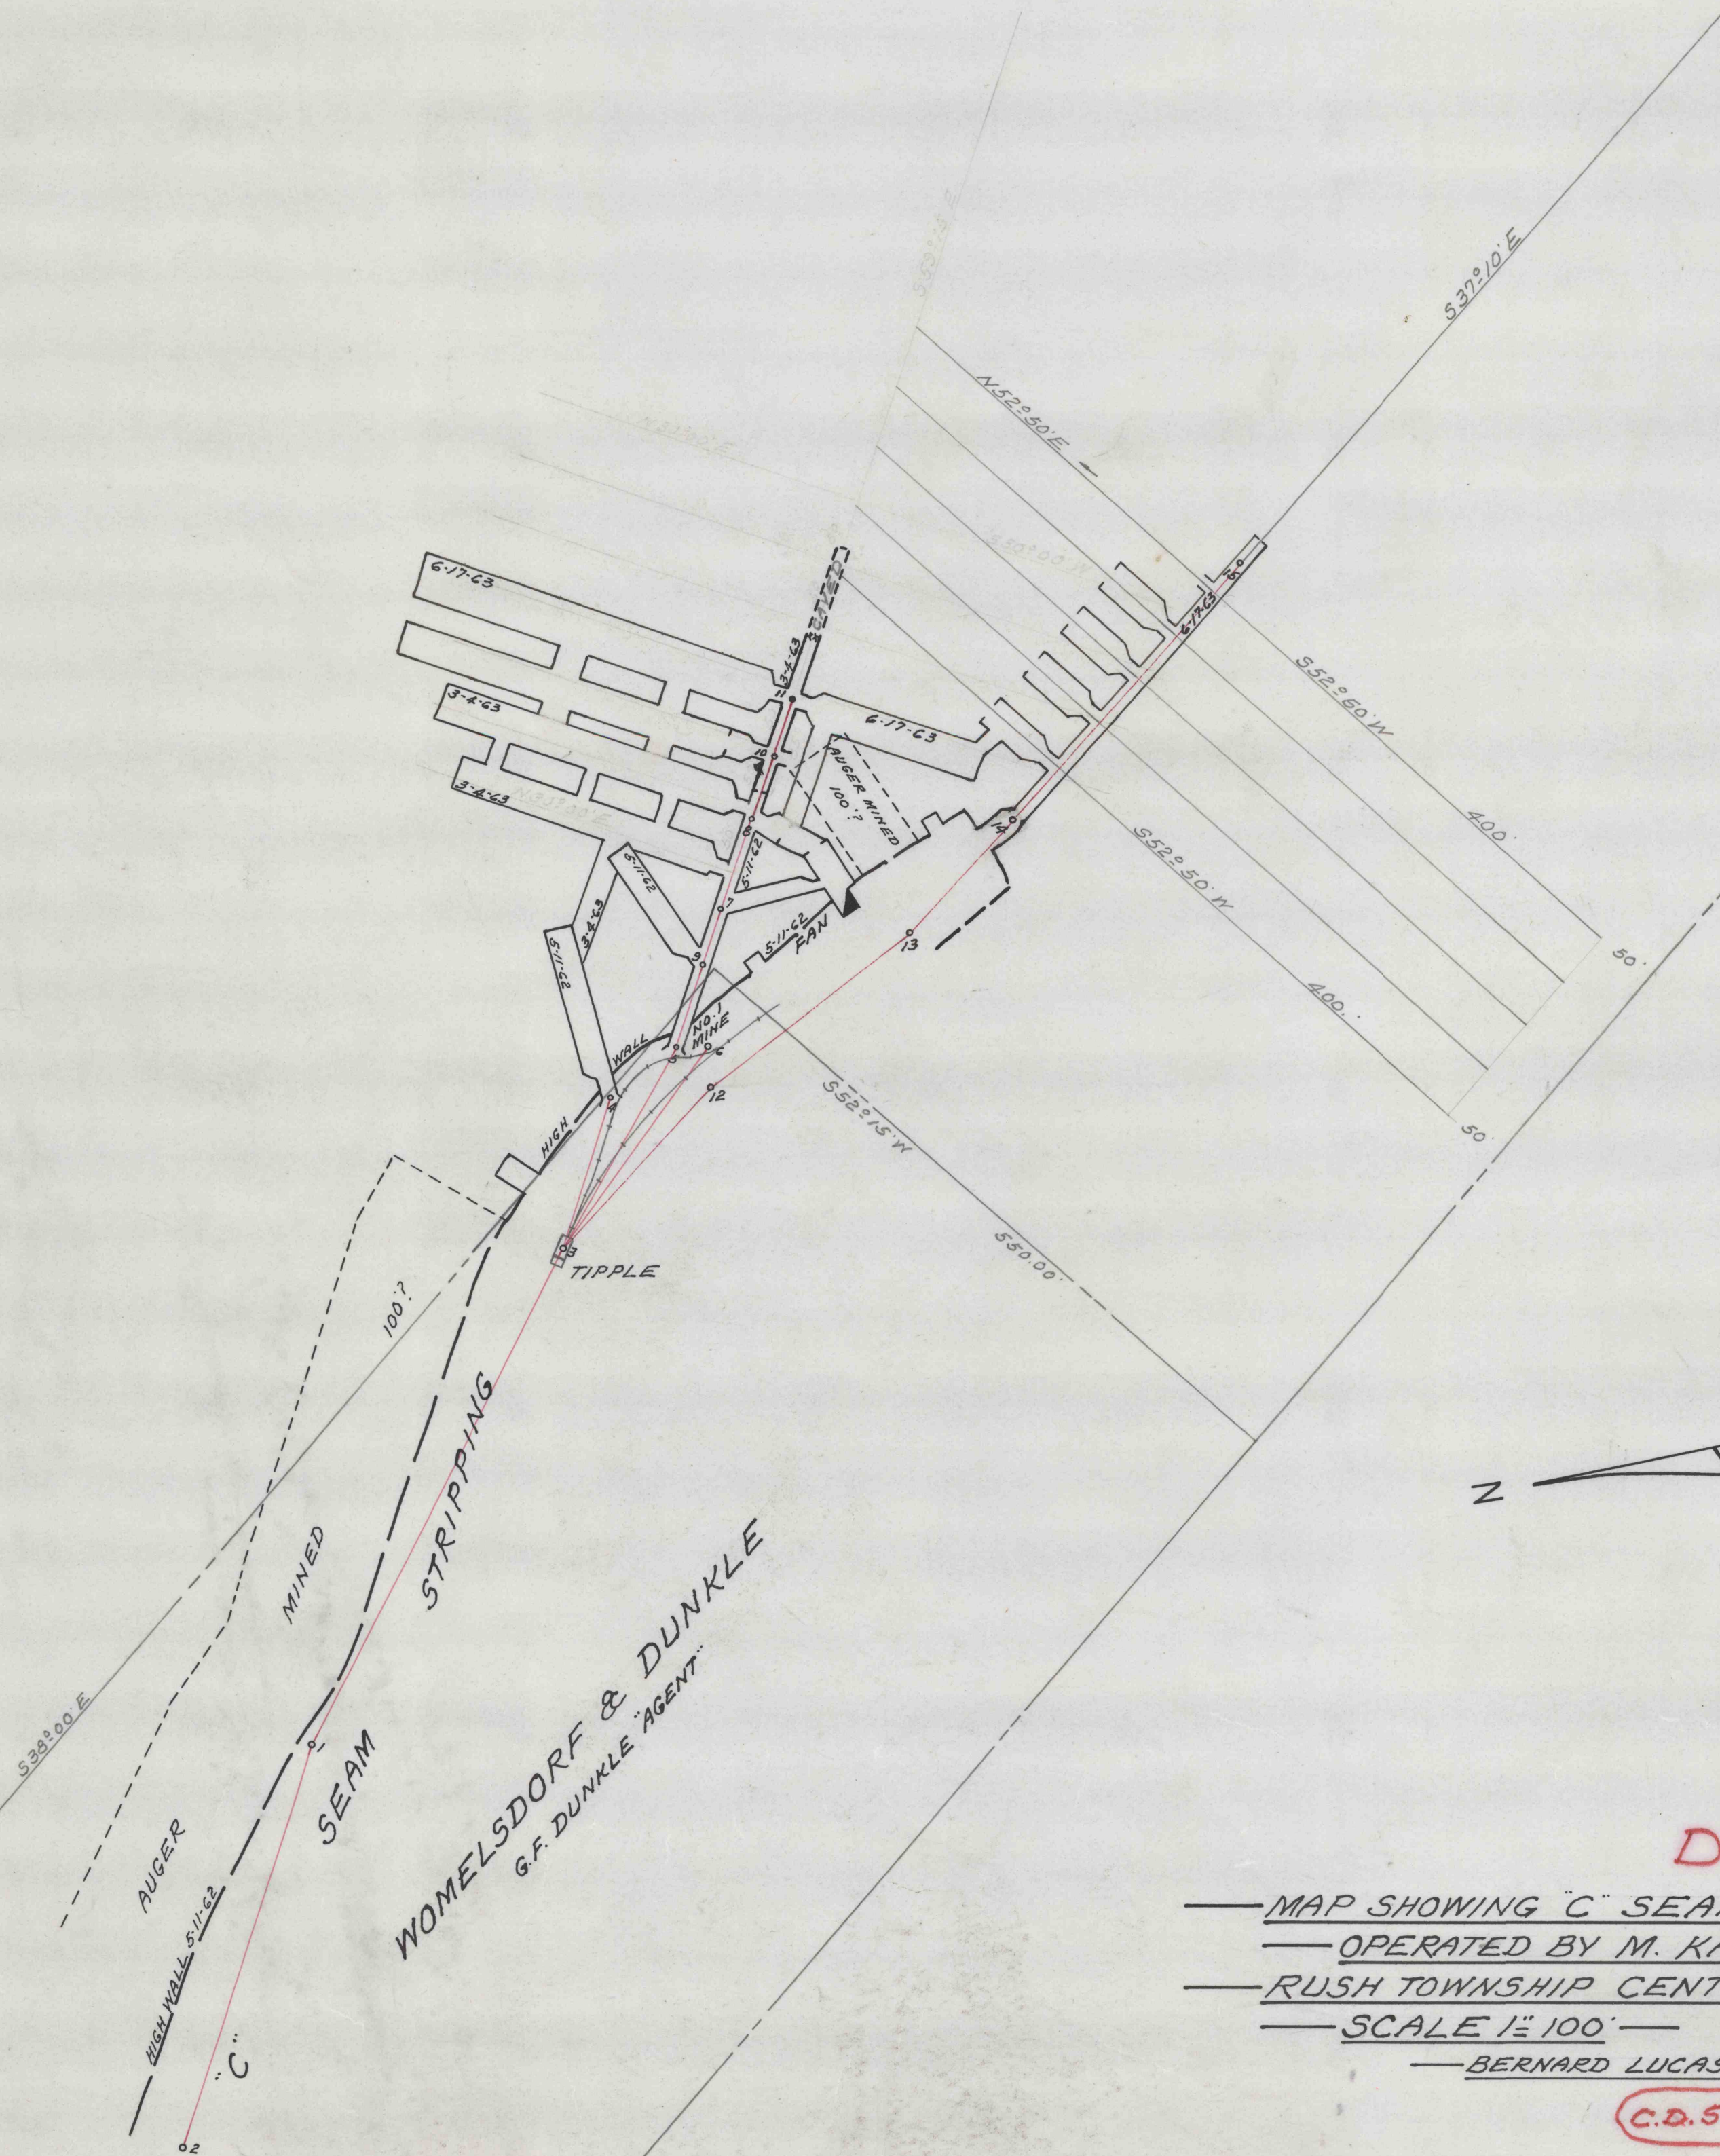

D  
— MAP SHOWING "C" SEAM DEEP MINE NO. 1 —  
— OPERATED BY M. KASUBICK COAL CO. —  
— RUSH TOWNSHIP CENTRE COUNTY PENNA. —  
— SCALE 1" = 100' — MAY 11, 1962 —  
— BERNARD LUCAS ASSOCIATES —

C.D. 595