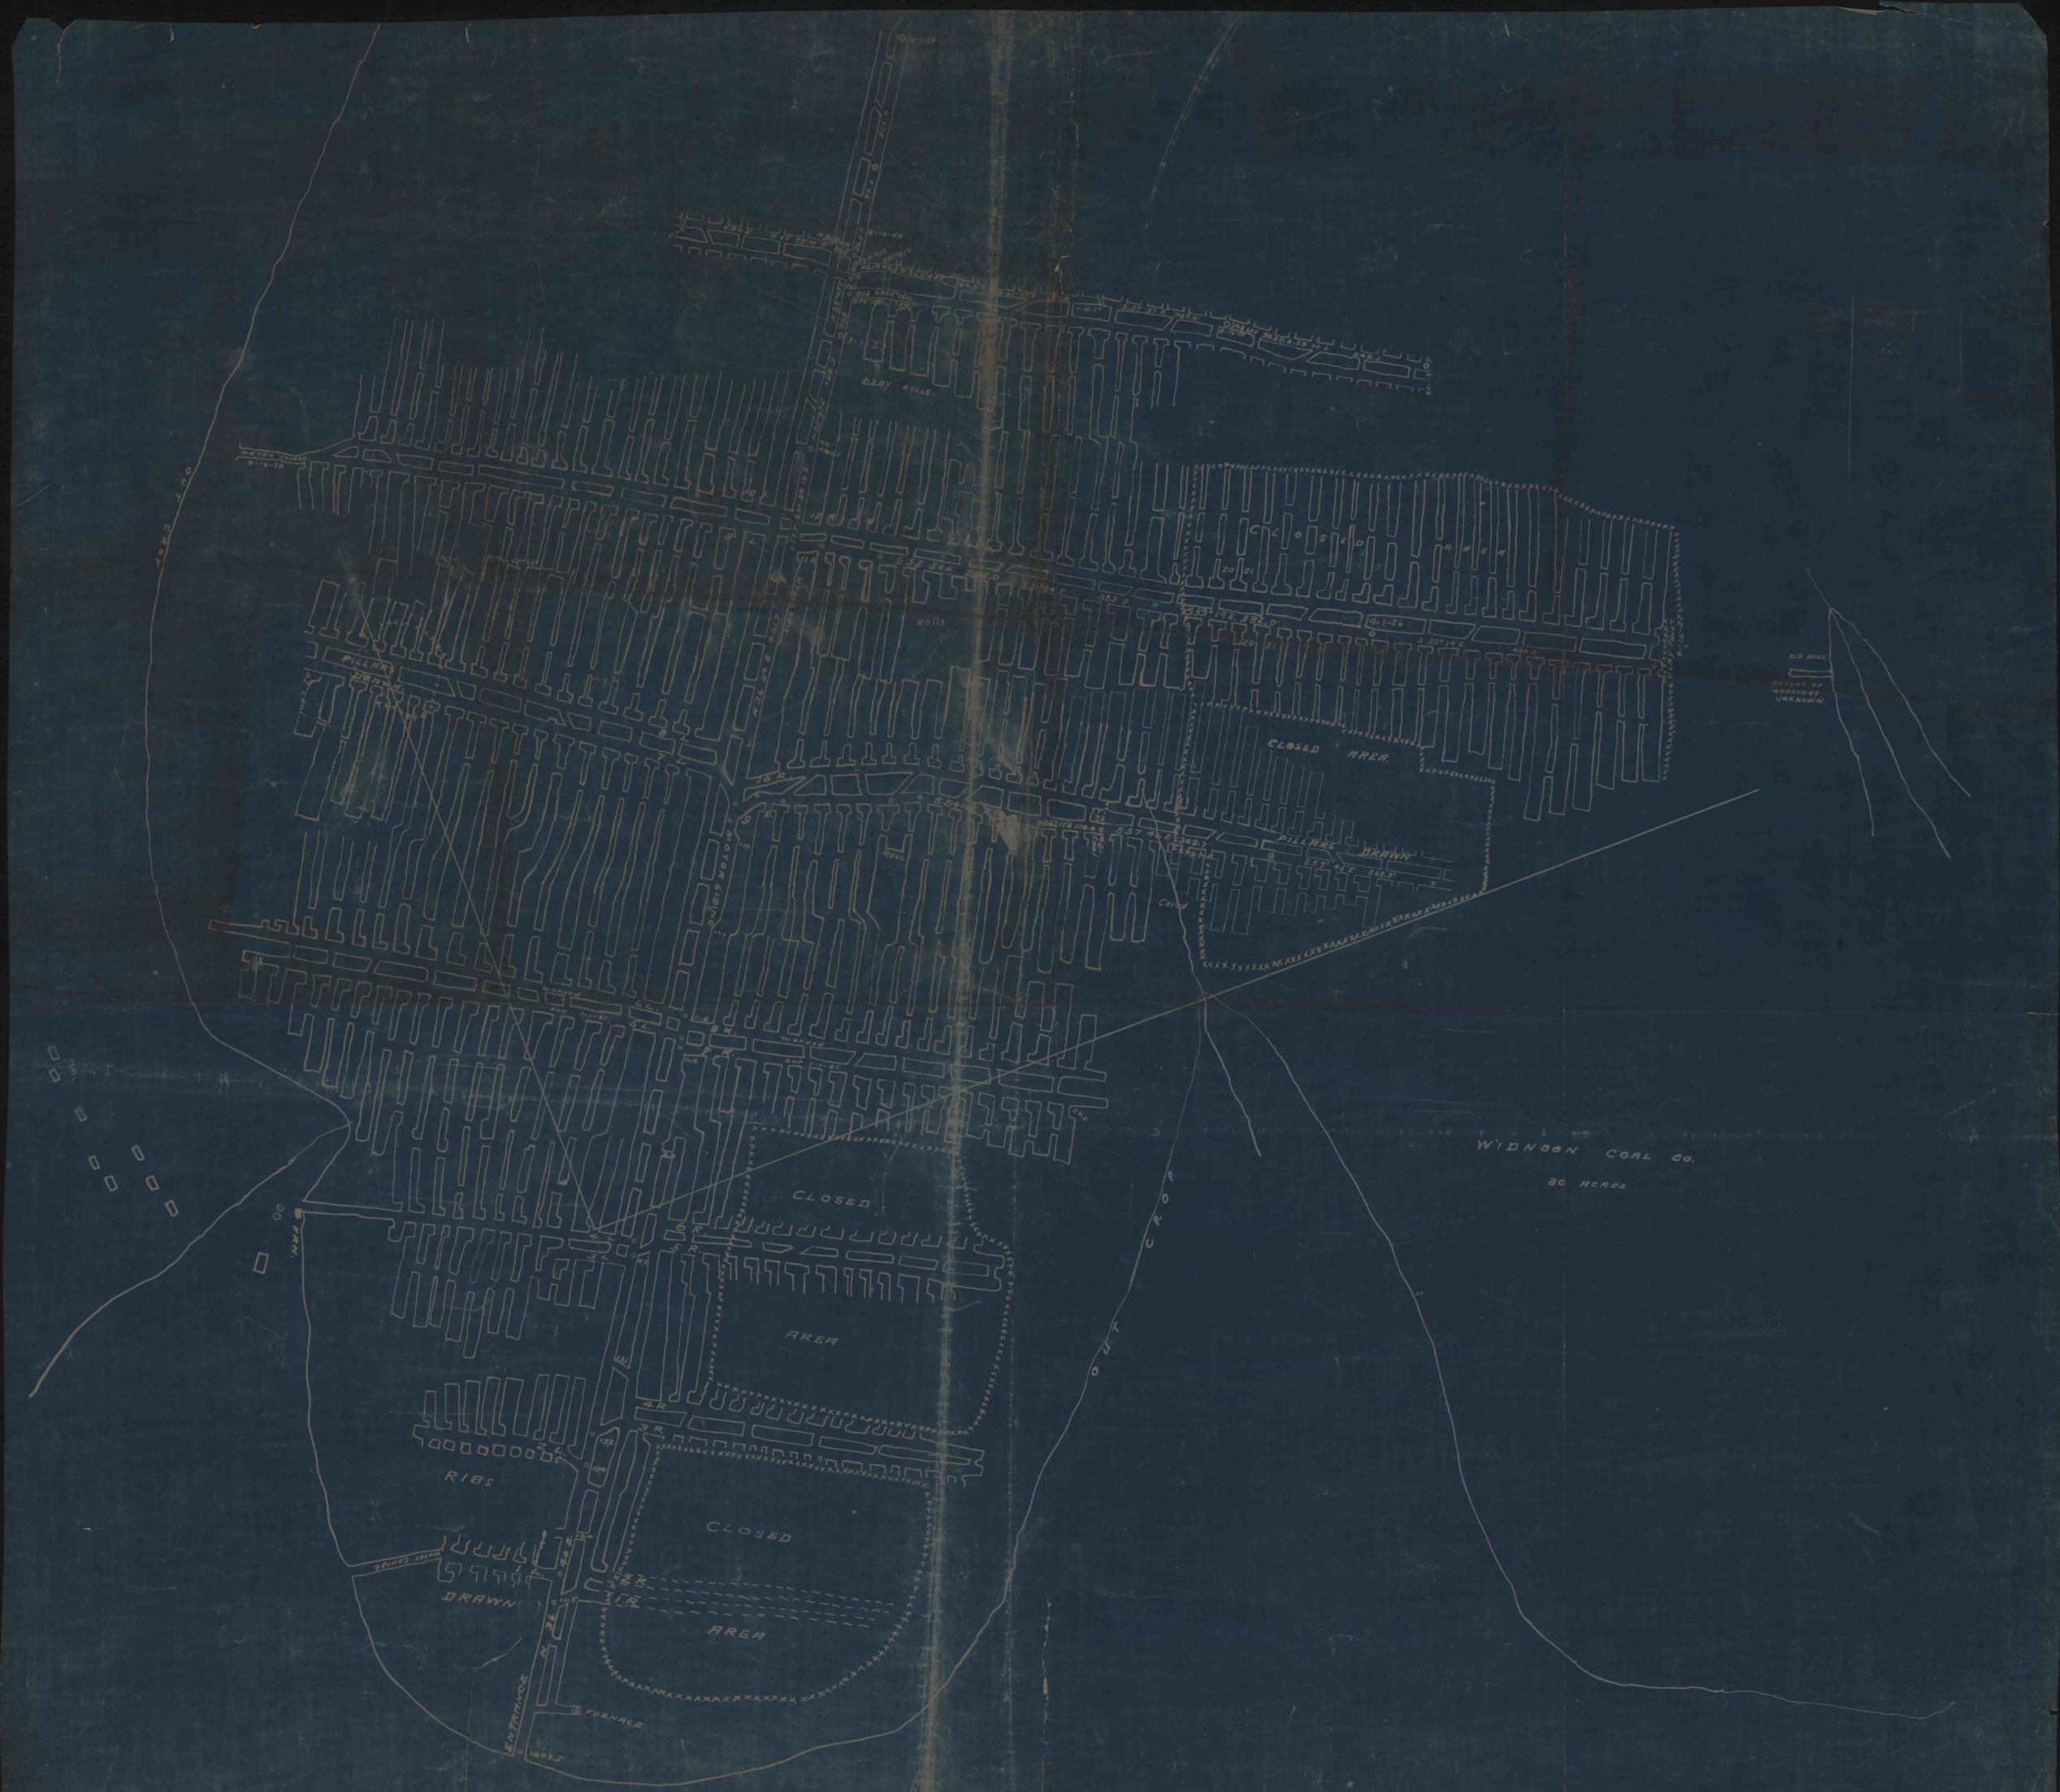

MINE WORKINGS

LAWSONHAM COAL CO.

MINE - LAWSONHAM PA.

OFFICE - ST. MARYS, PA.

SCALE - 1" = 100'

SURVEY JAN - 1 - 1921

BROUGHT UP TO OCT - 1 - 1921
" " " JAN 1 1923
" " " JAN - 1 - 1924
" " " APRIL 1 - 1926
" " " APRIL 16 - 1927
" " " NOV 10 - 1928
" " " JUNE 1 - 1929

370