


VICTOR RYDBERG

LLOYD & REYNOLDS

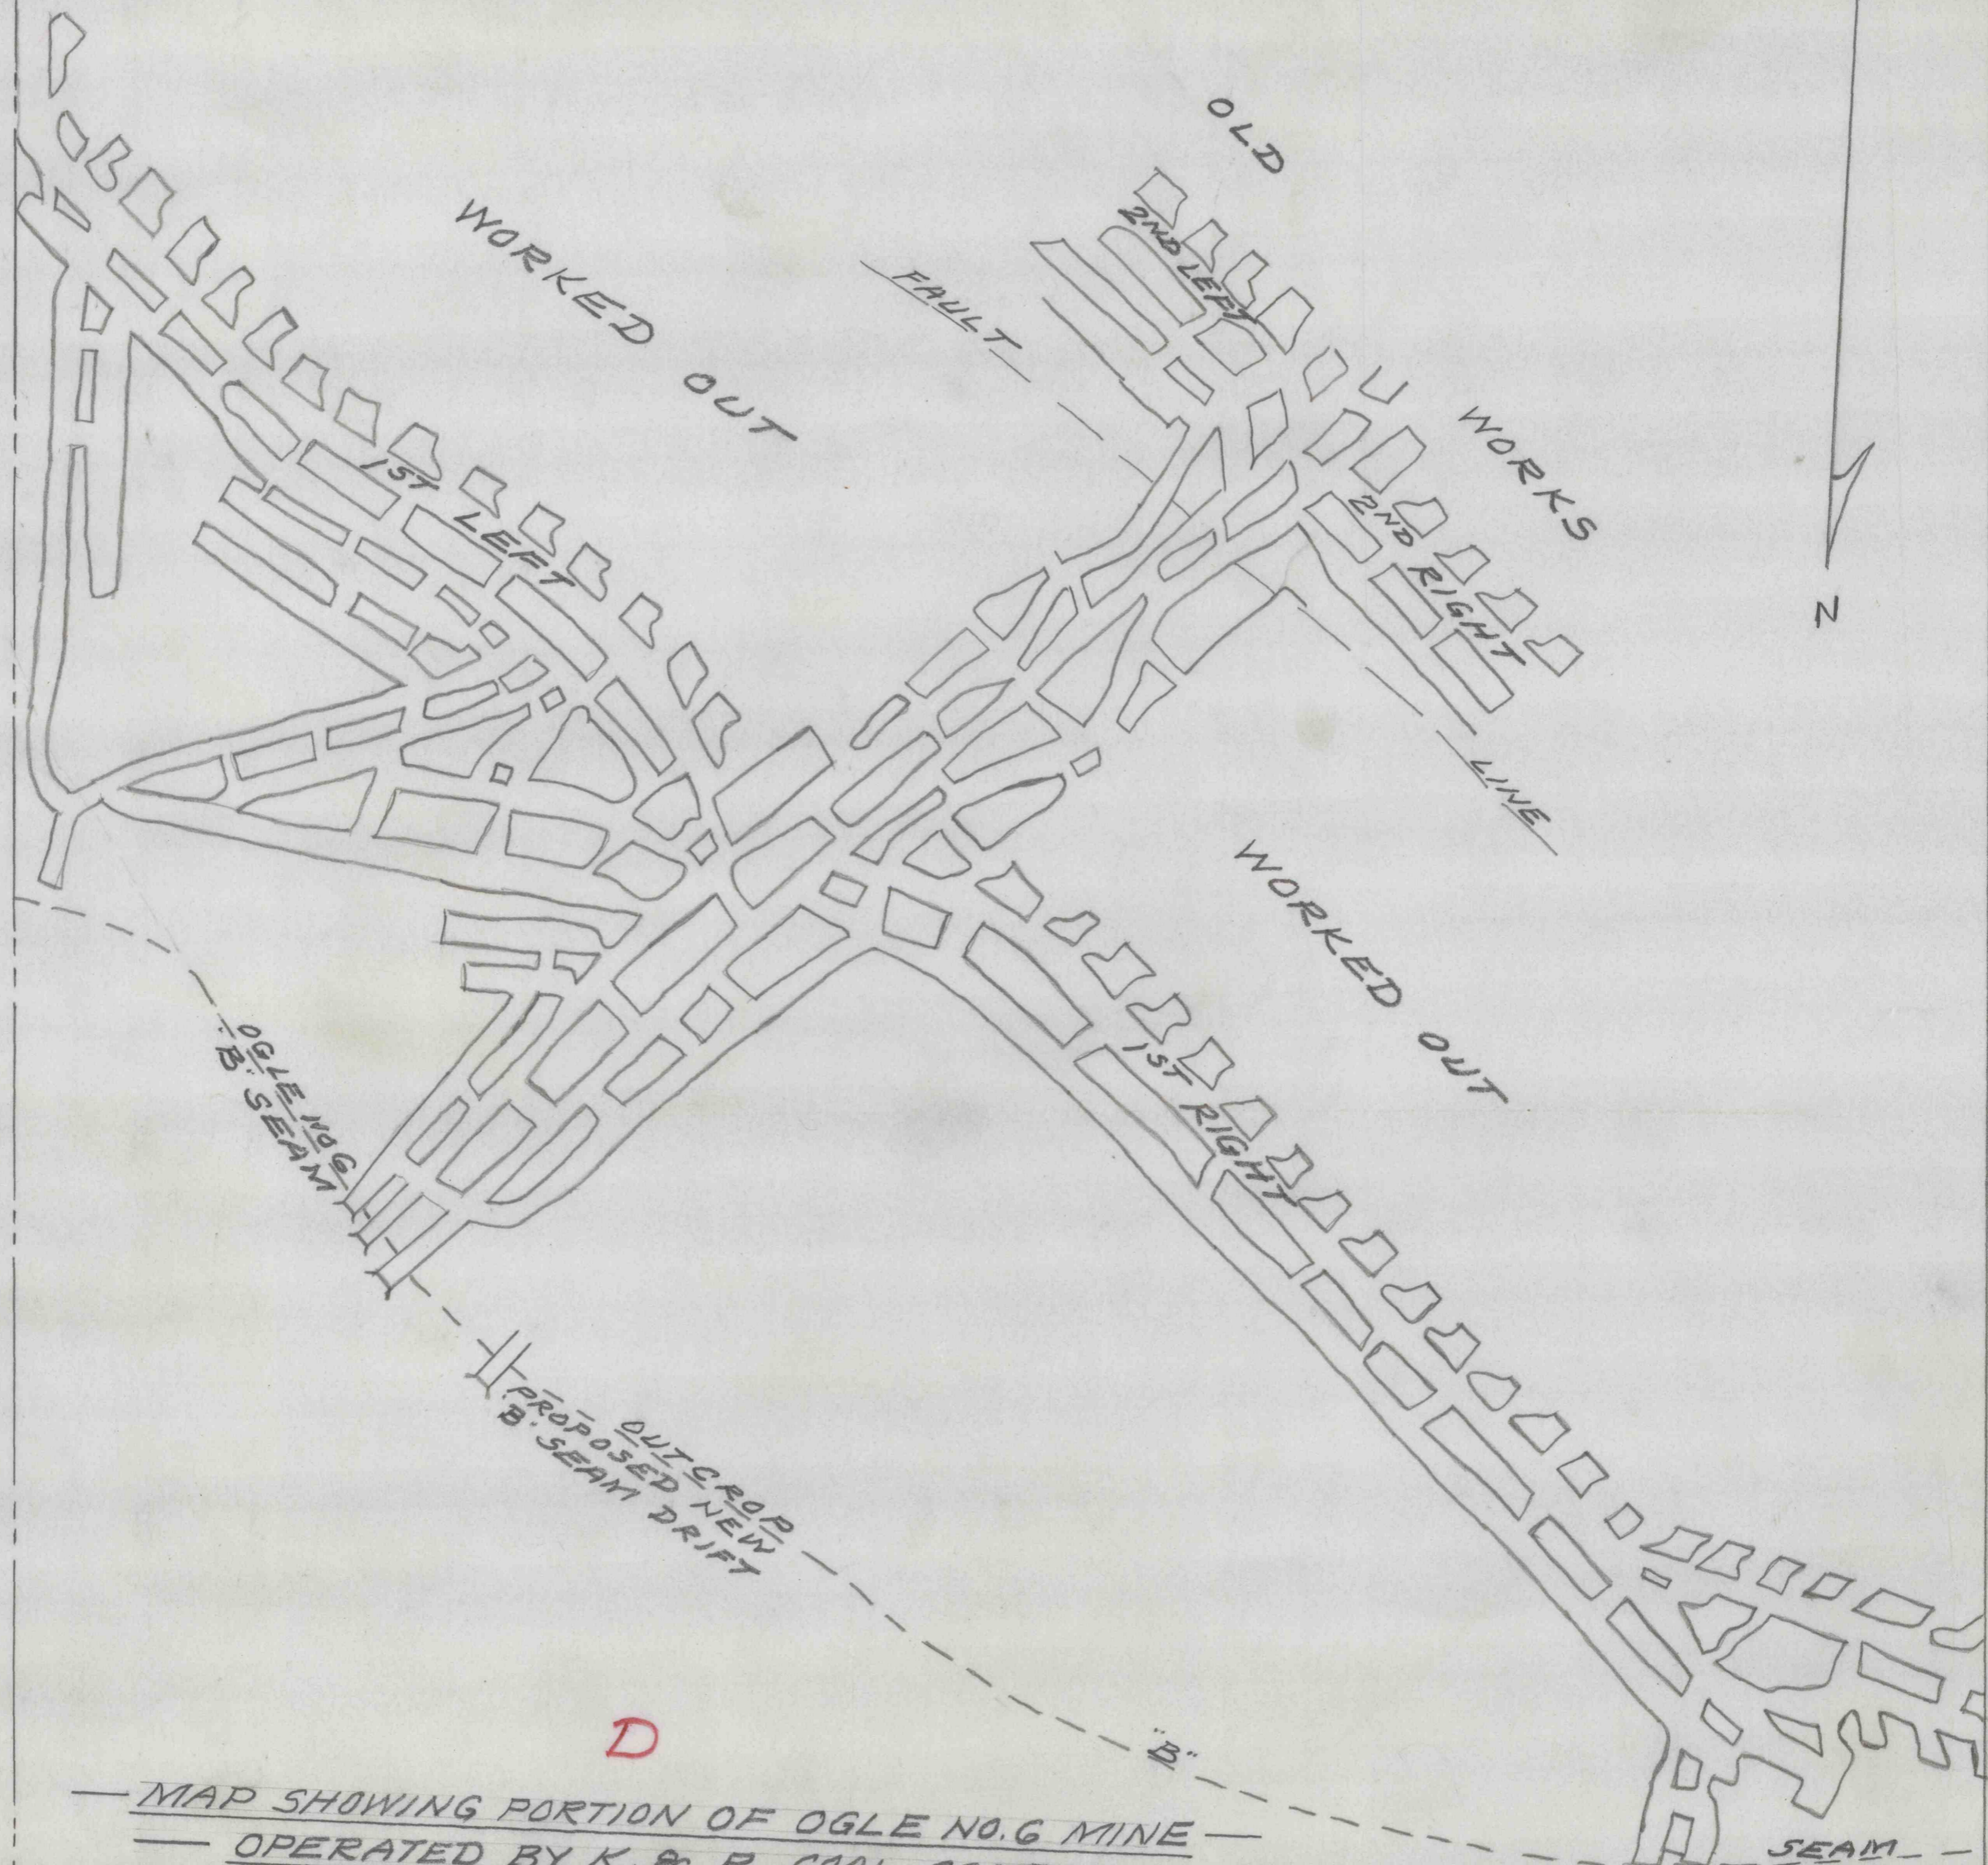

N

— MAP SHOWING PORTION OF OGLE NO. 6 MINE —
 — OPERATED BY K. & R. COAL COMPANY —
 — COOPER TWP. CLEARFIELD COUNTY PENNA. —
 — SCALE 1"=100' — — OCT. 3, 1957 —
 — BERNARD LUCAS ASSOC. —

C.D. 501

C. B. C. TRACT

2182

2185