



5188

RICHARD HUMPTON TRACT

MARTHA S. SNYDER TRACT

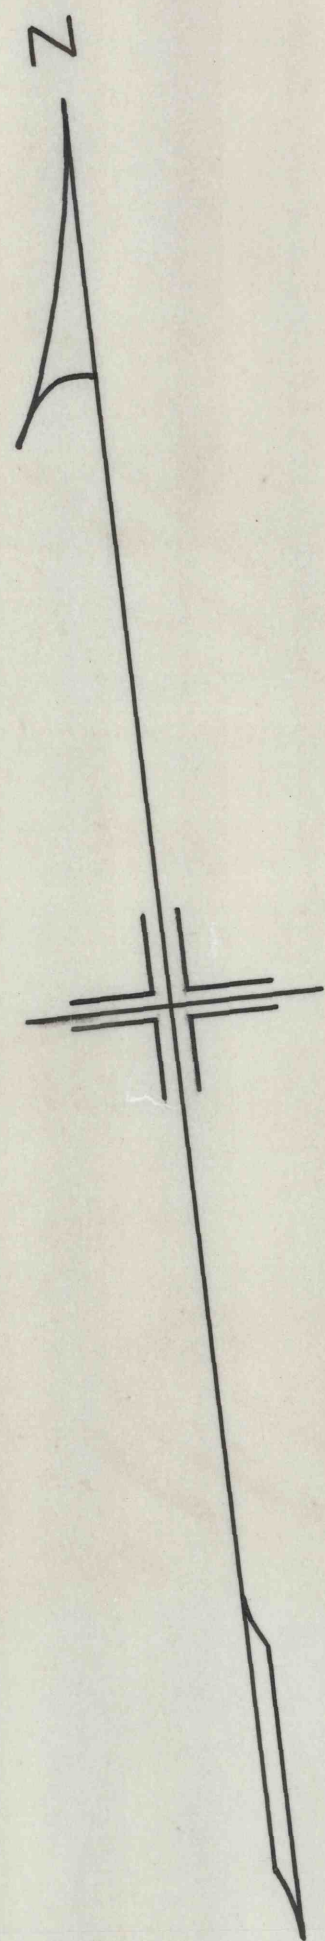

C. B. C. CORP.

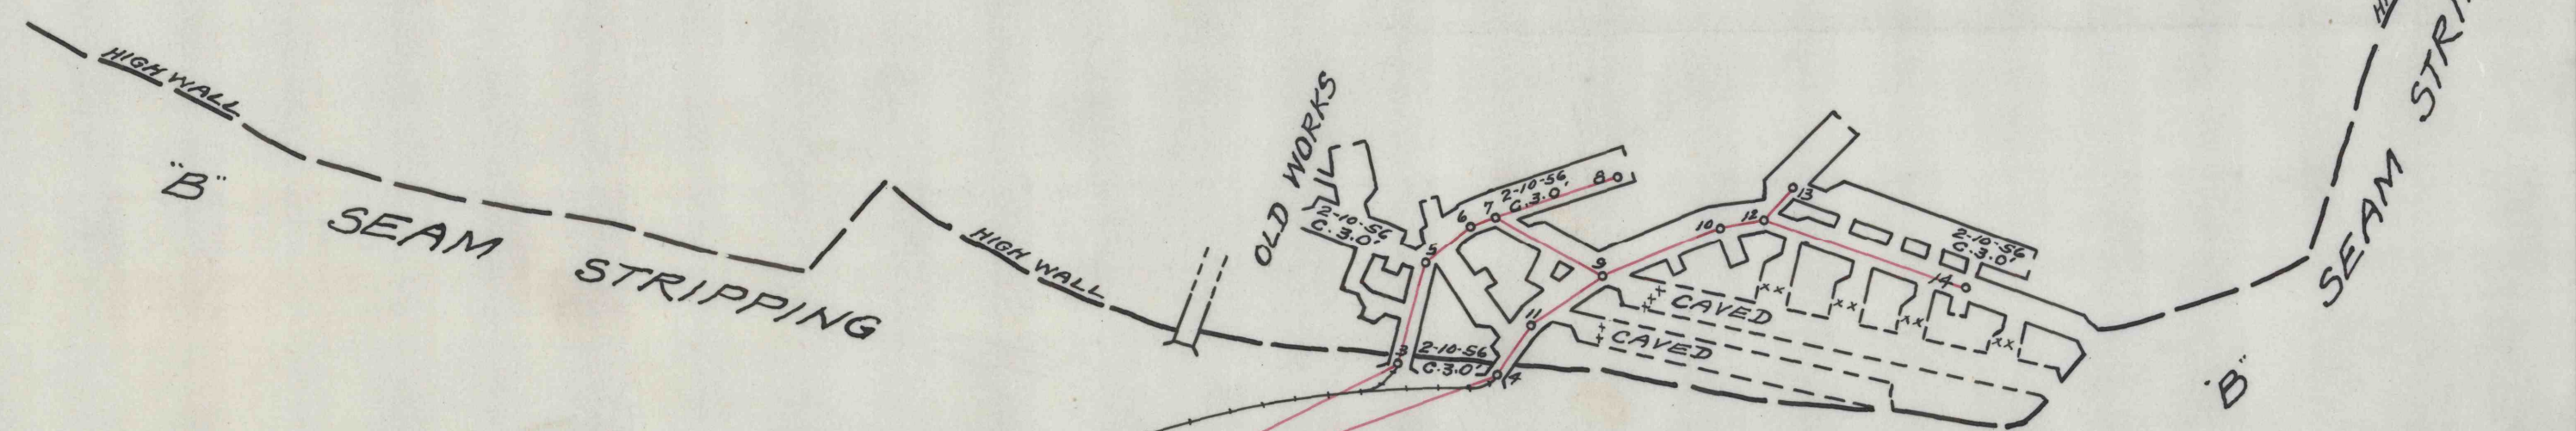

— MAP OF VIADUCT NO. 1 "B" SEAM MINE —
— OPERATED BY R. LARSON & M. EMANUELSON —
— COOPER TWP. CLEARFIELD COUNTY PENNA. —
— SCALE 1" = 100' — FEB. 13, 1956 —

— BERNARD LUCAS ASSOC. — **C.D. 501**

2188