


FINAL SURVEY
 SURVEYED
 PLOTTED
 NOTE BOOK
 NO.

ORIGINAL SURVEY
 SURVEYED
 PLOTTED
 NOTE BOOK
 NO.

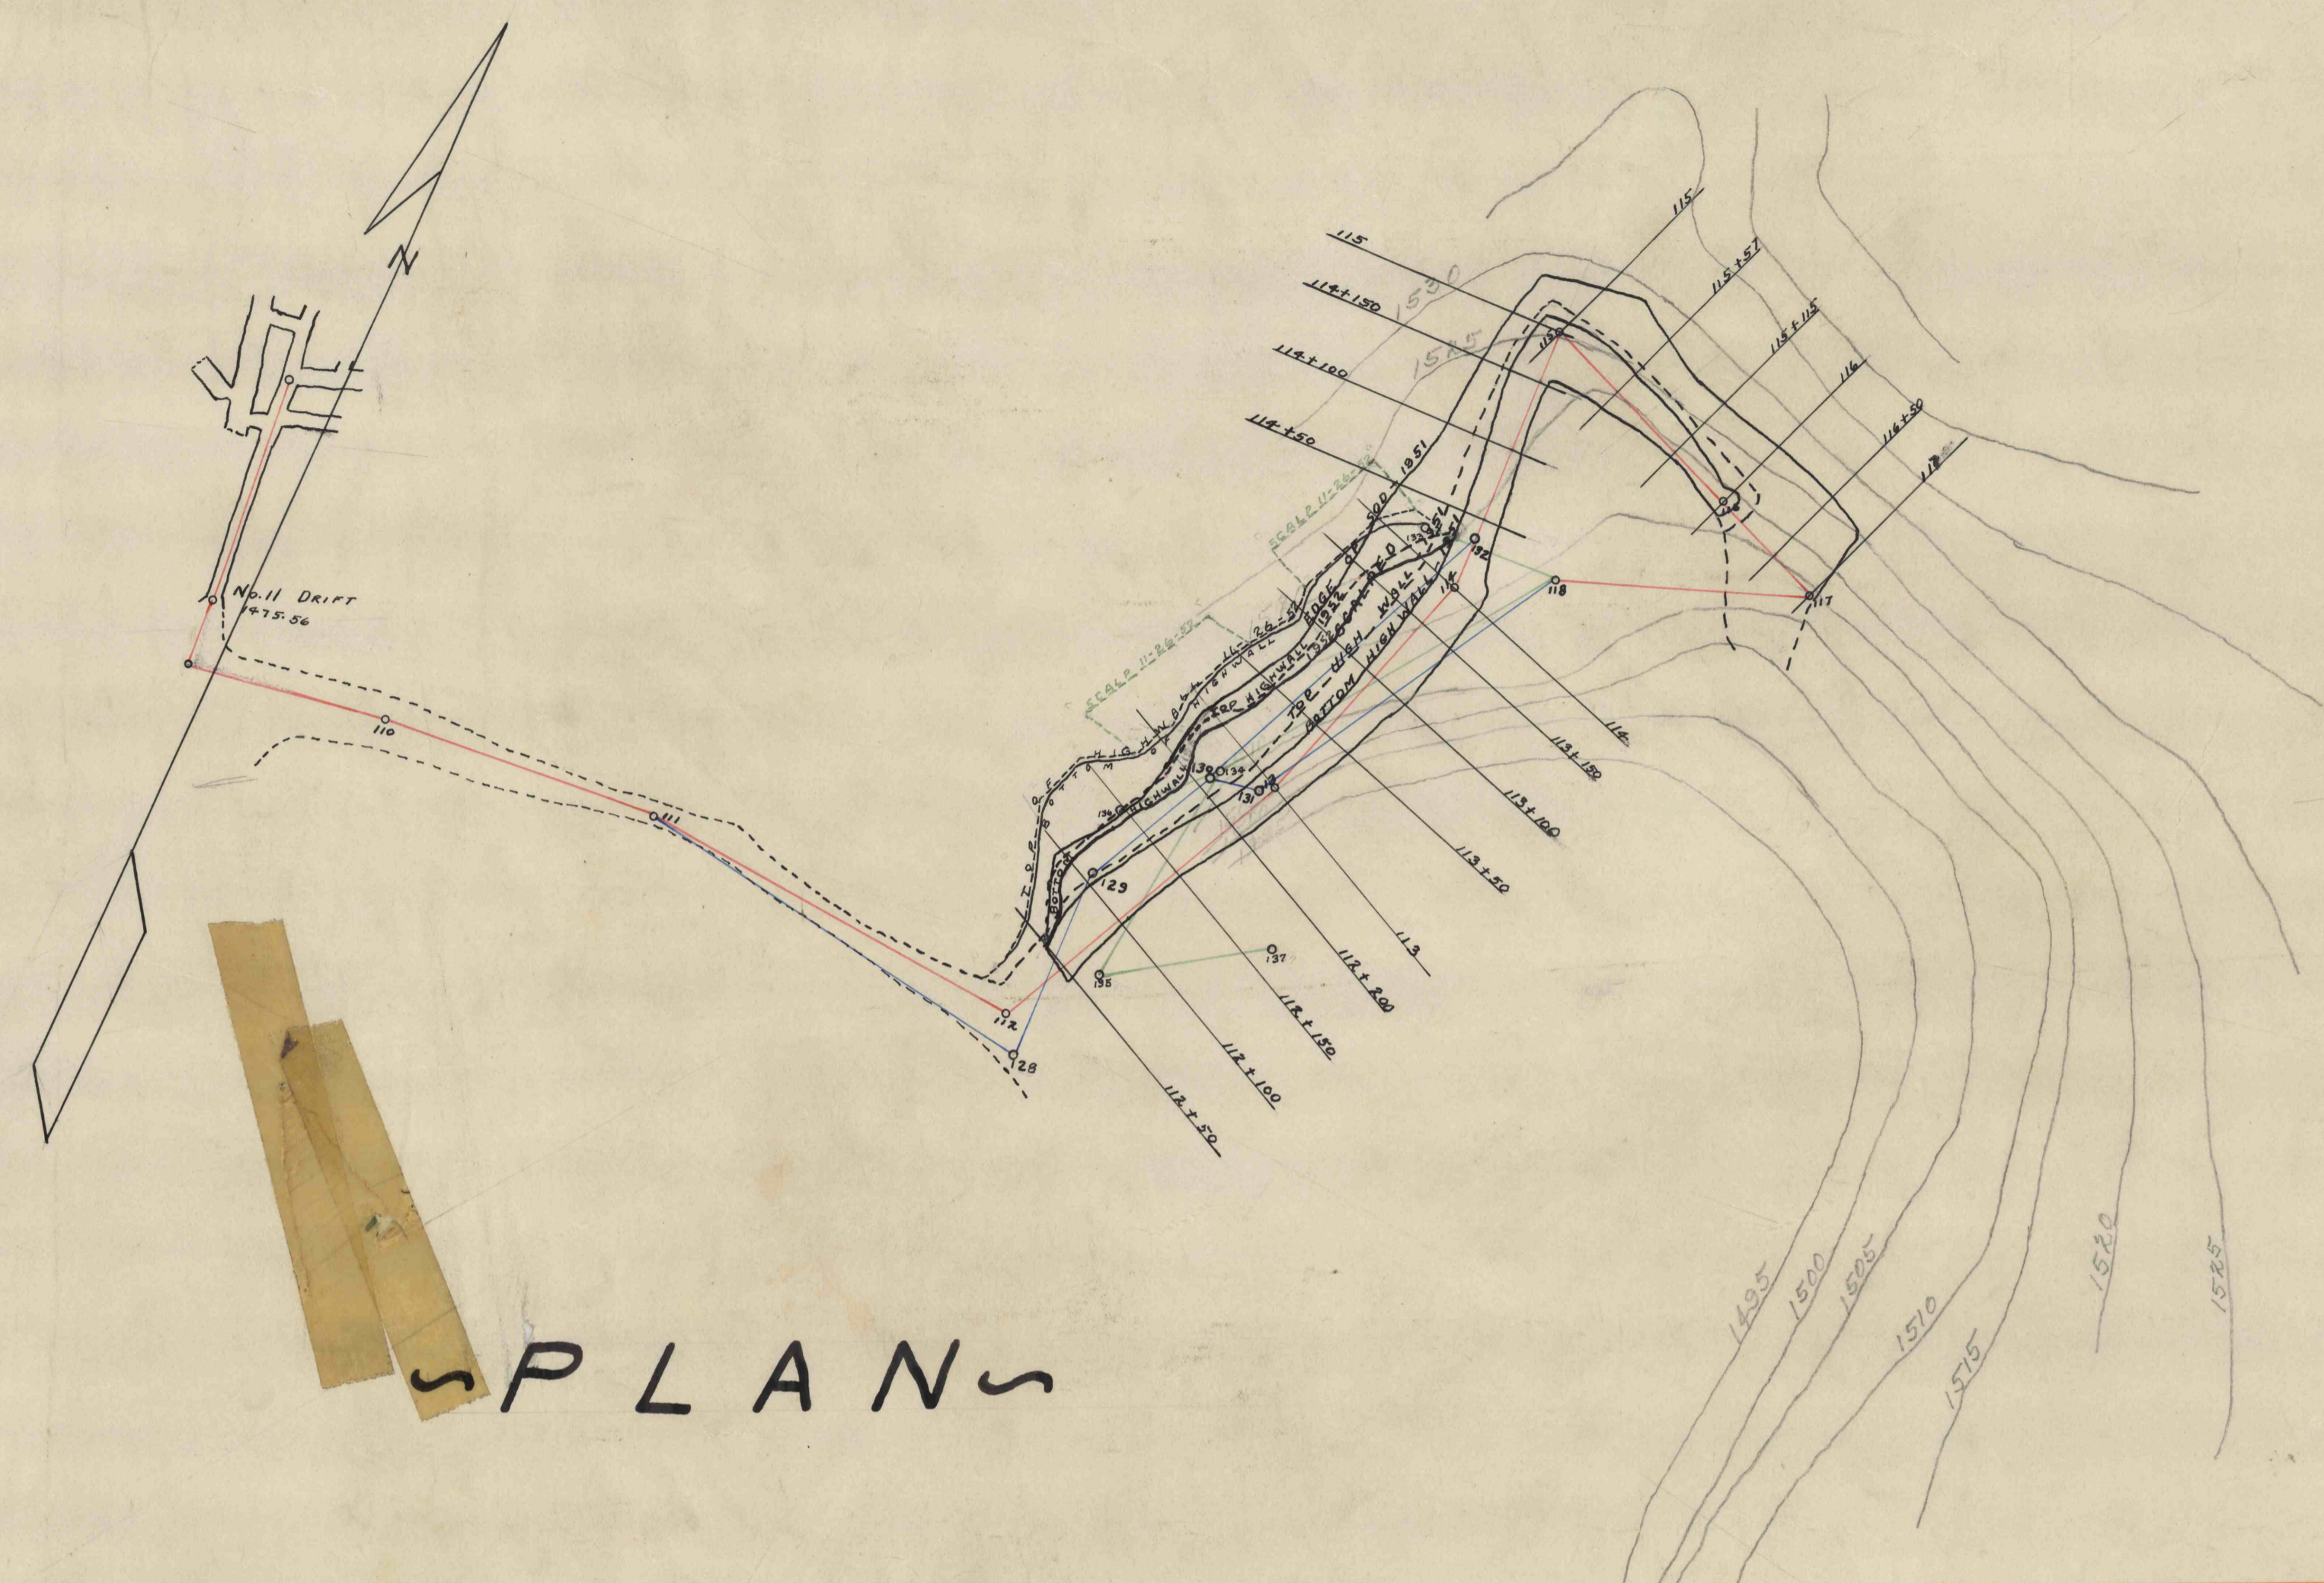

PLAN

NORTH AMERICAN REFRACTORIES Co.
 CLEVELAND, OHIO
 RIVER HILL STRIPPING, LOCK HAVEN, CLINTON Co, PA.

SURVEYED: JULY 17 1951
 3-17-52
 11-26-52 OK J.R.H.
 DRAWN BY: J.R.H., JR.
 CHECKED BY: J.R.H.
 CHECKED BY: SURVEY 3-17-52
 SCALE: 1" = 100'
 TRACED BY: J.R.H., JR.
 INDEX No. - RR-2-18